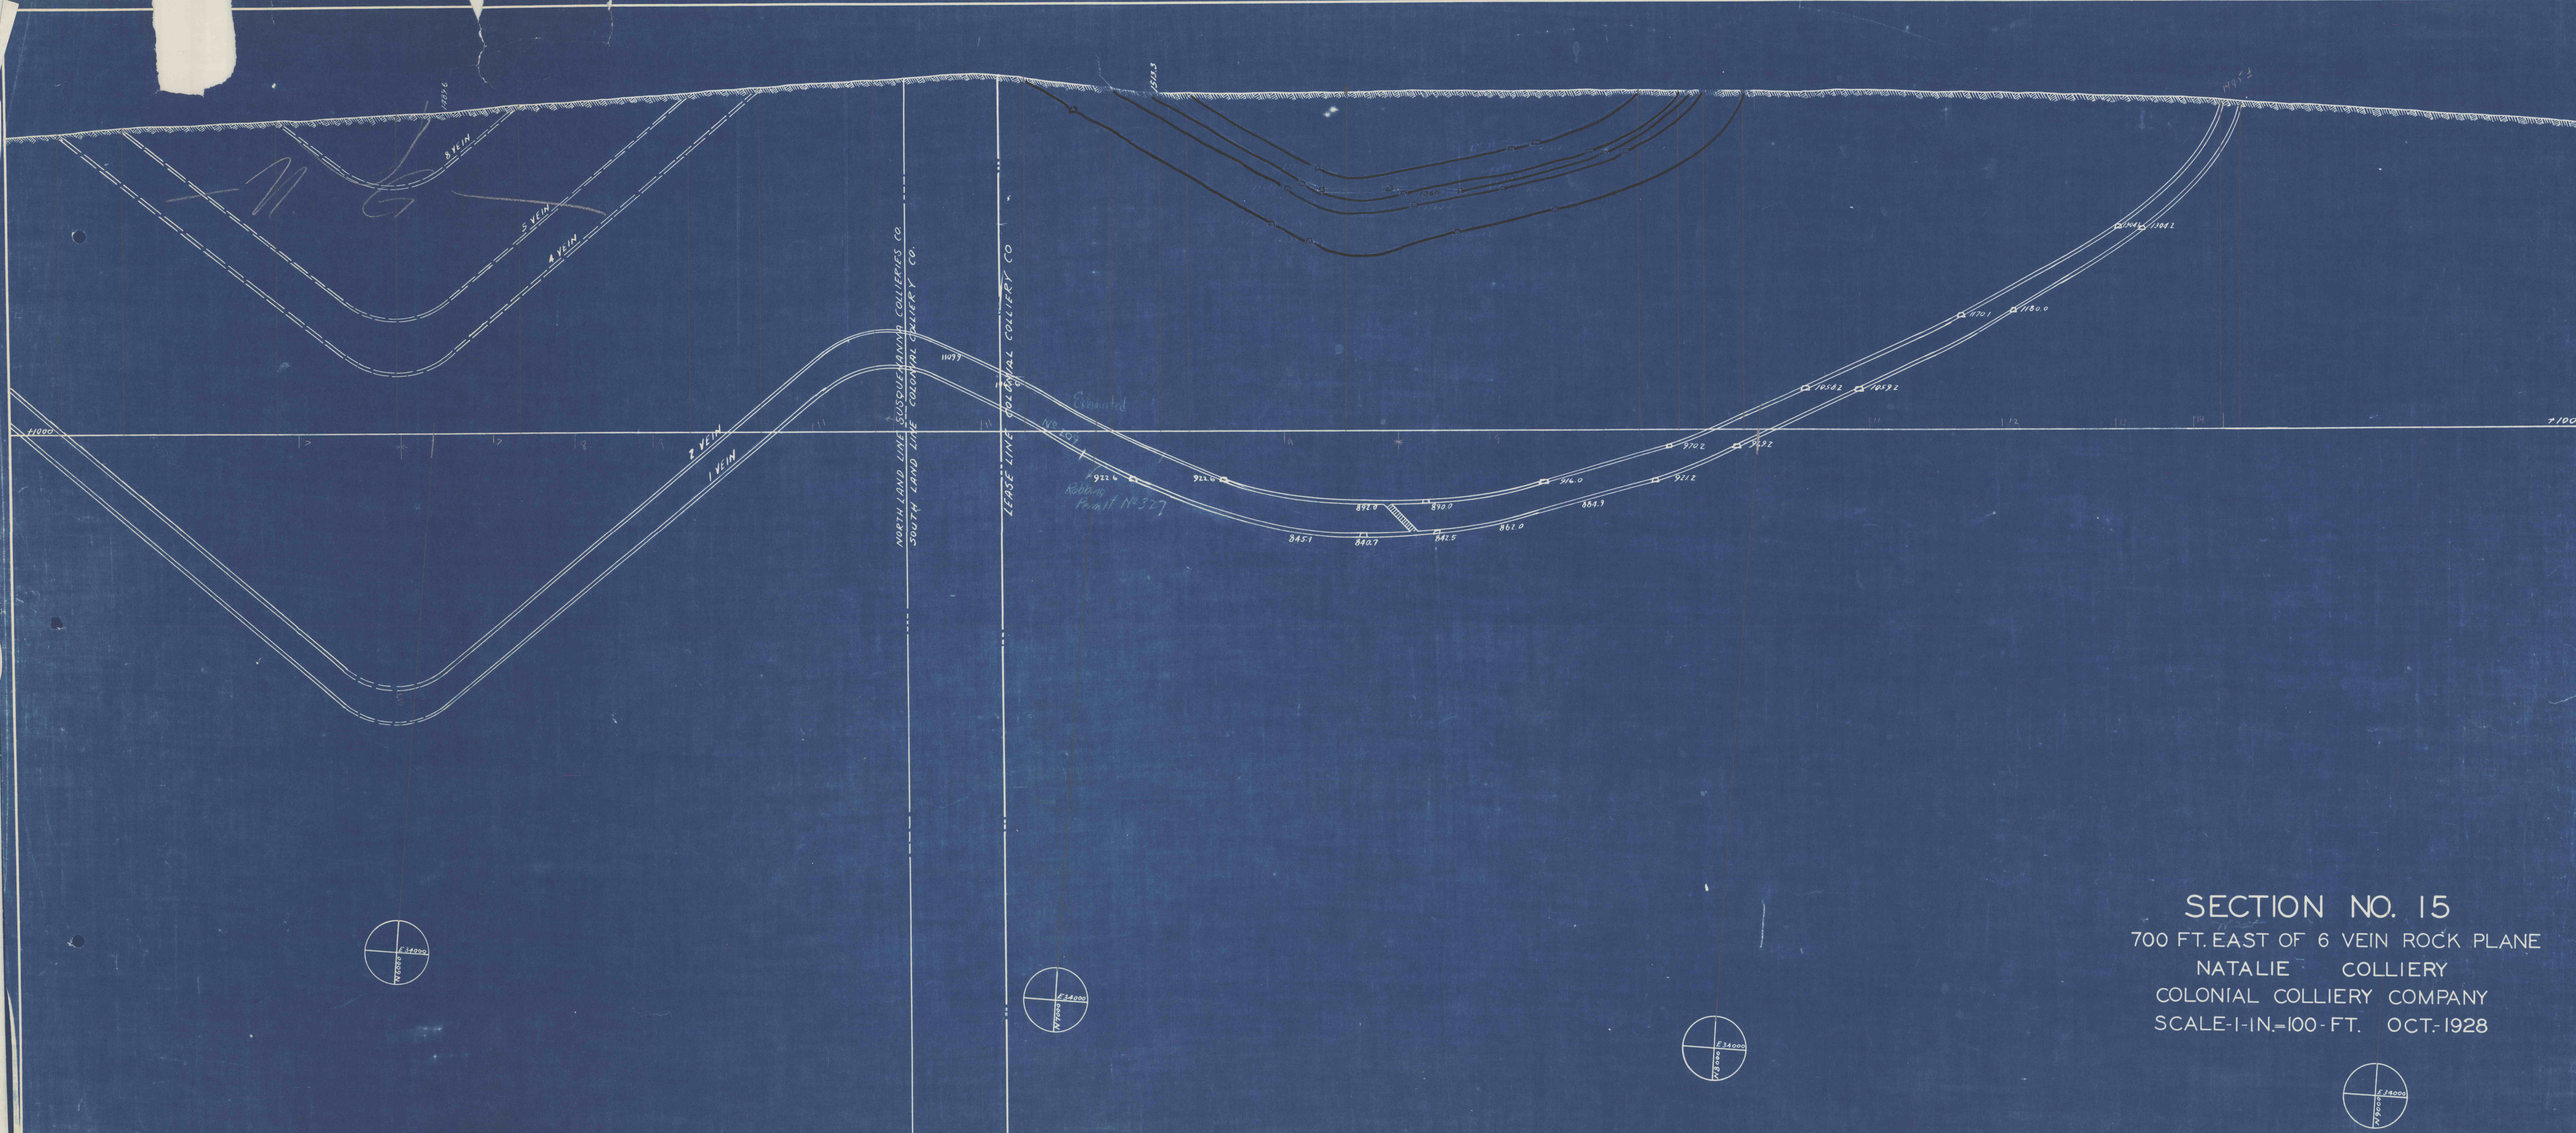
SECTION NO. 15
700 FT. EAST OF 6 VEIN ROCK PLANE
NATALIE COLLIERY
COLONIAL COLLIERY COMPANY
SCALE-1-IN.=100-FT. OCT.-1928
NORTH LAND LINE SUSQUEHANNA COLLIERIES CO.
SOUTH LAND LINE COLONIAL COLLIERY CO.
LEASE LINE COLONIAL COLLIERY CO.
9 VEIN
5 VEIN
4 VEIN
2 VEIN
1 VEIN
Excavated
Robbins Permit No. 327
+100
+1000
E 14000
N 9000