


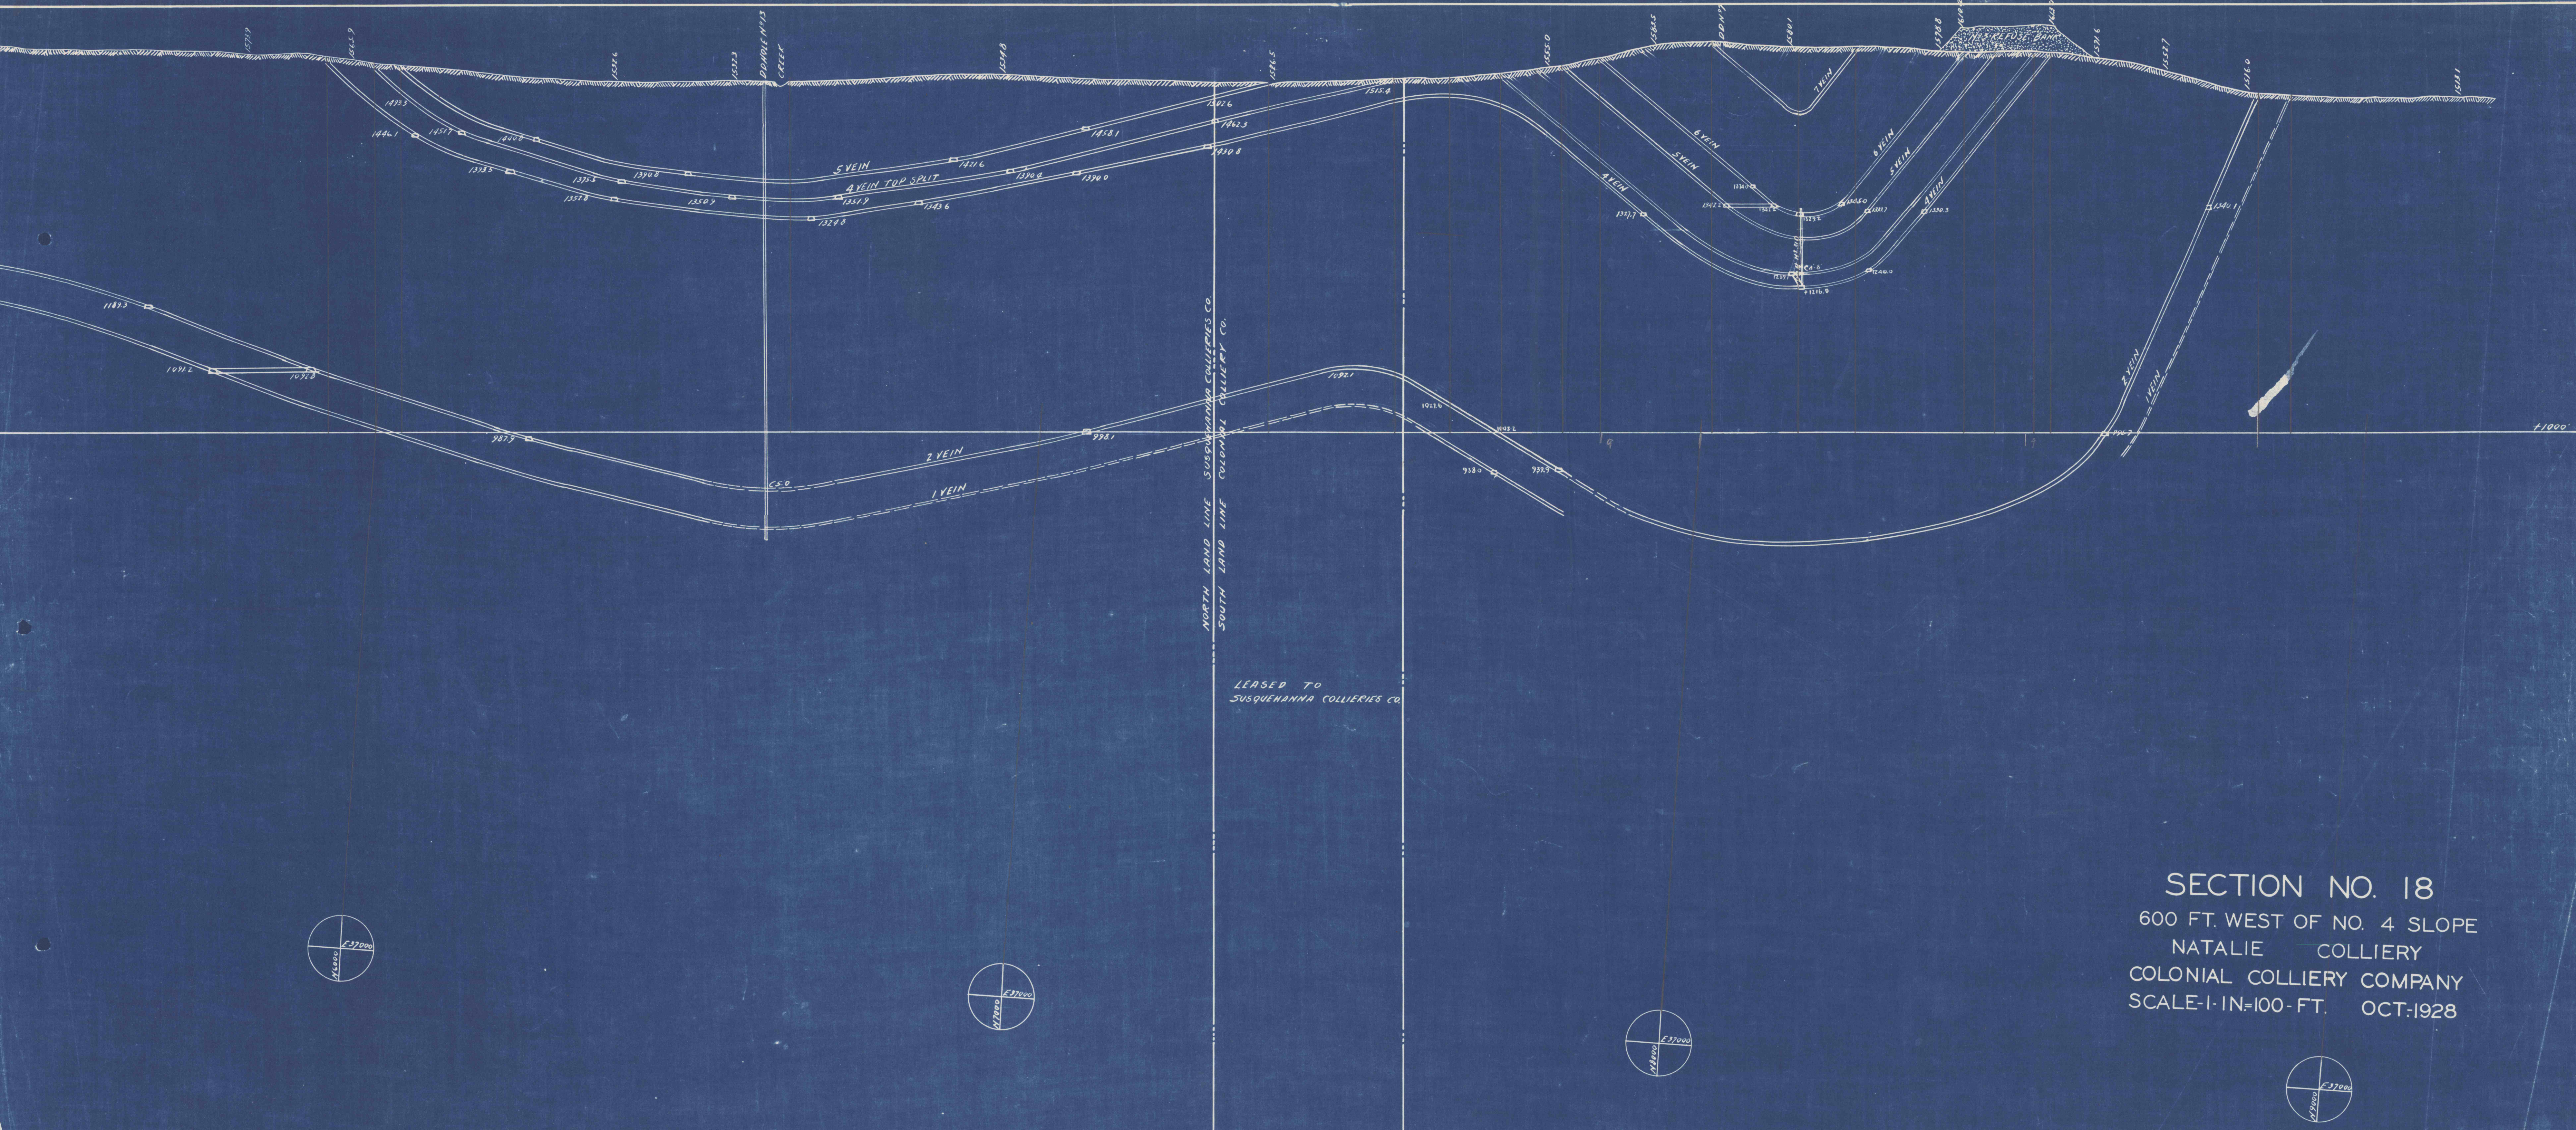

SECTION NO. 18
600 FT. WEST OF NO. 4 SLOPE
NATALIE COLLIERY
COLONIAL COLLIERY COMPANY
SCALE-1-IN=100-FT. OCT-1928