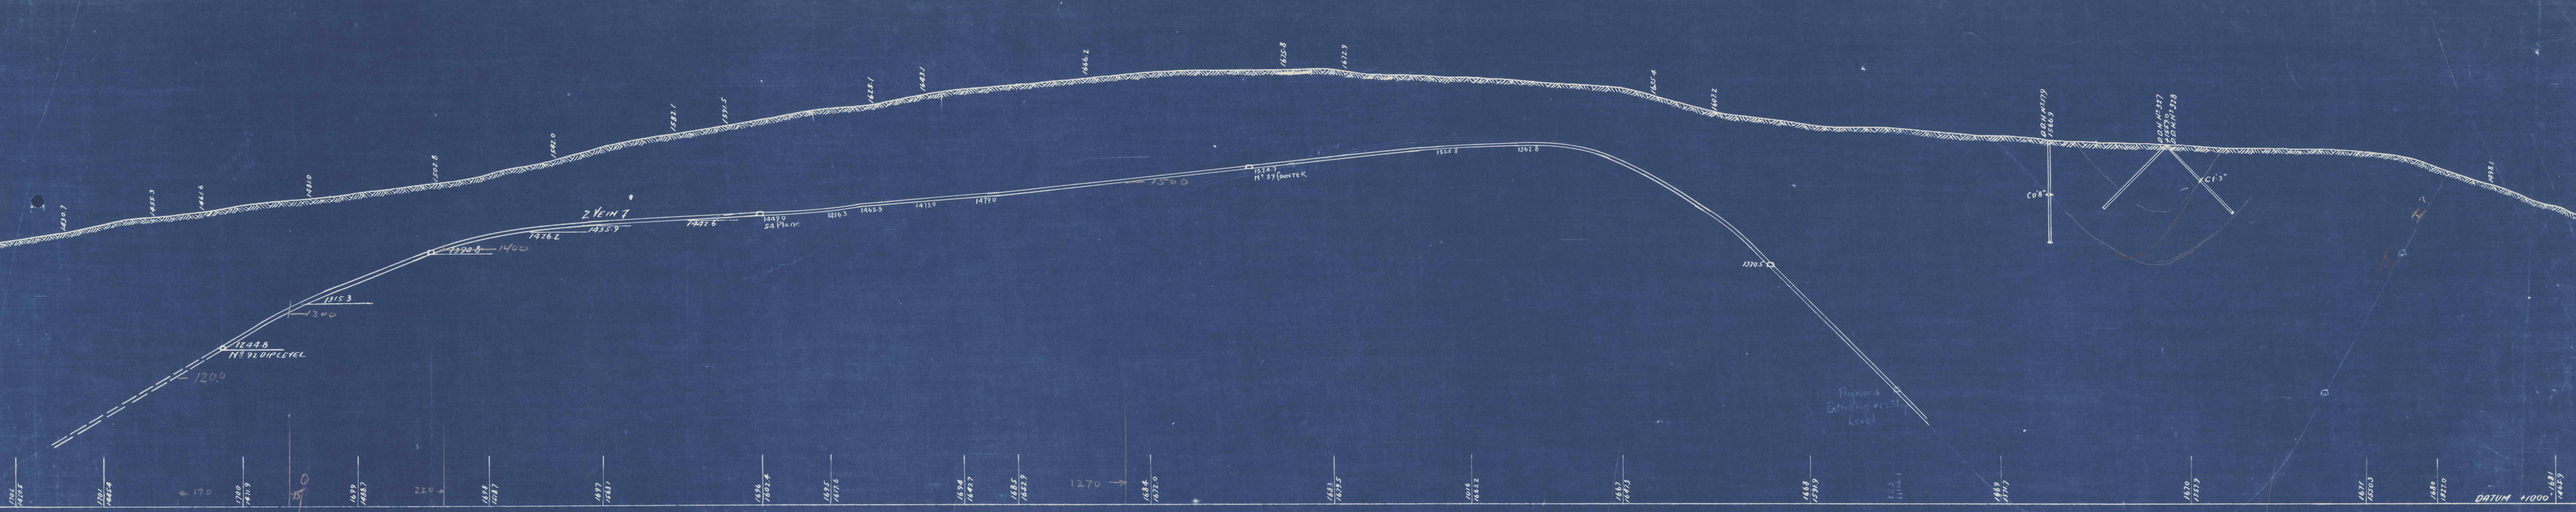

SECTION NO 24

ON LINE OF BOREHOLES 179–327

NATALIE COLLIERY

COLONIAL COLLIERY COMPANY

SCALE-1-IN-100-FT. AUG 1932