


STOCKTON MINE SECTION NO.17.

NORTH
SCALE 1"=100'

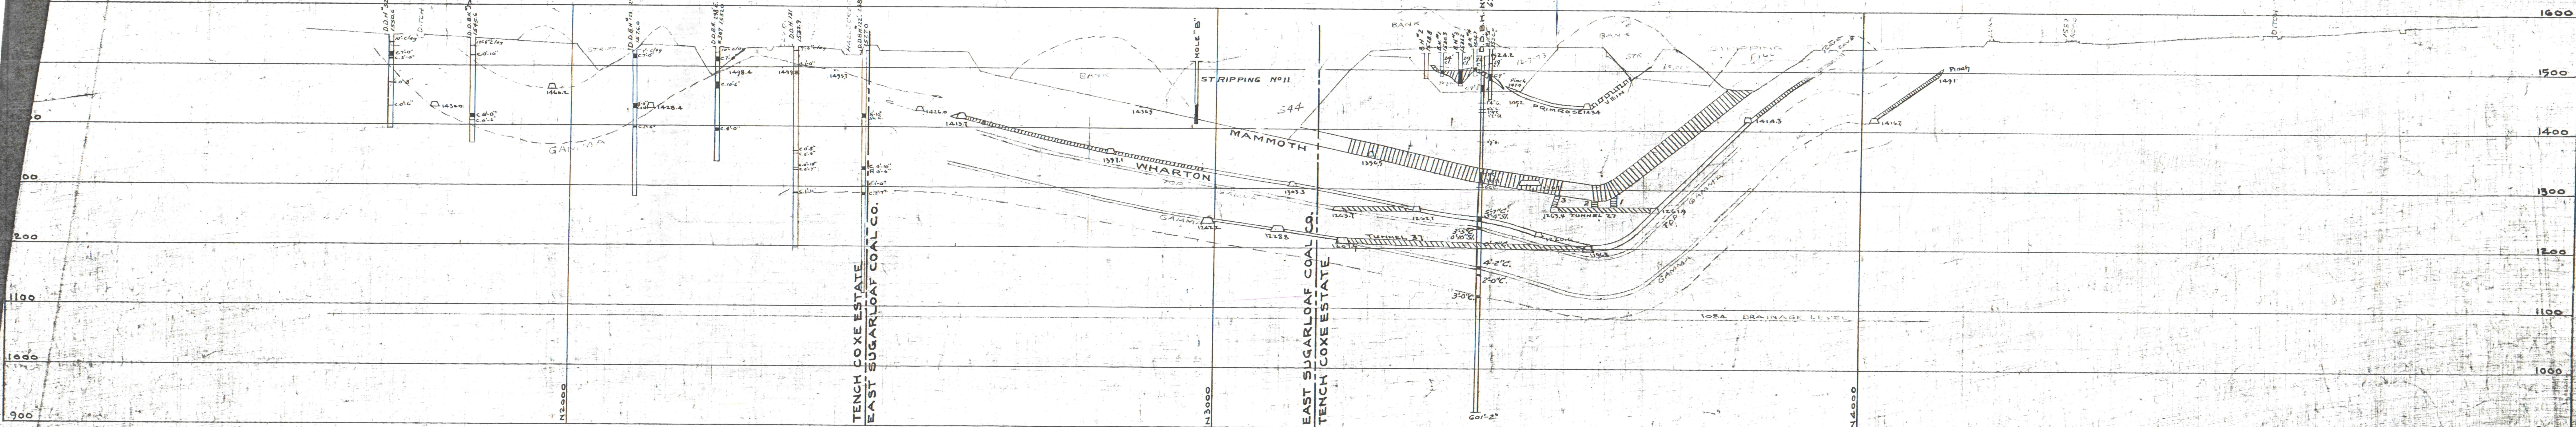

STOCKTON MINE SECTION NO.18.

NORTH
SCALE 1"=100'

