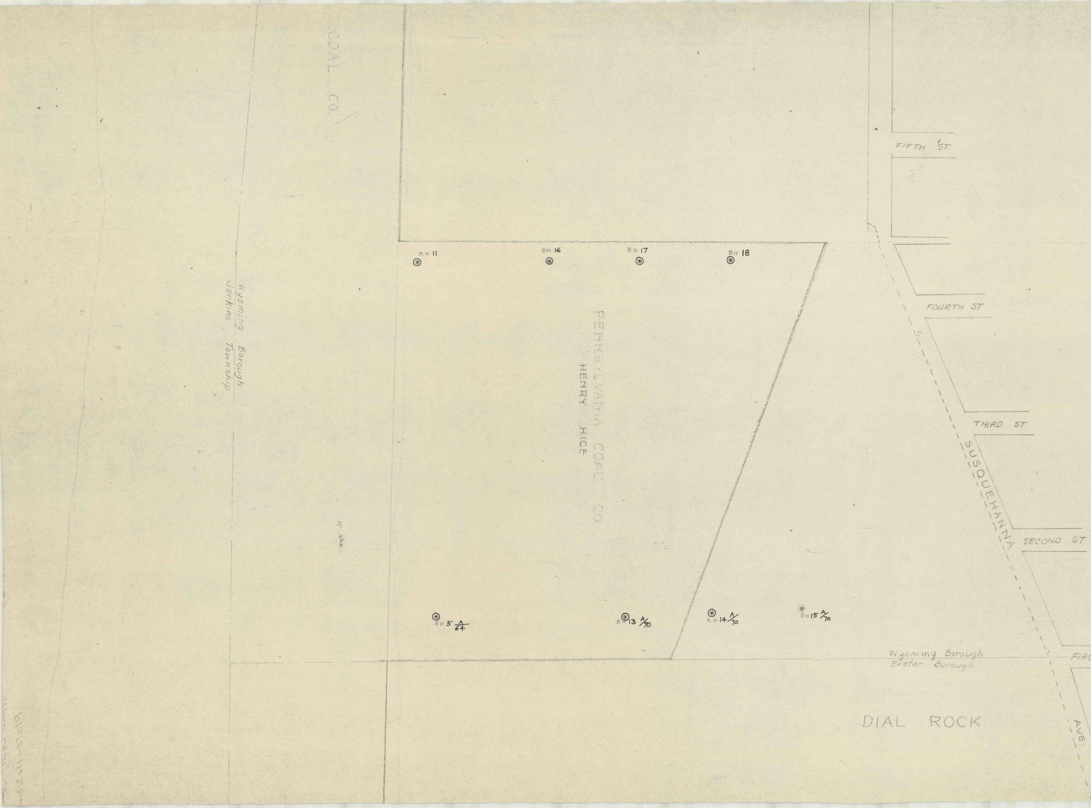
COAL CO.
Wyoming Borough
Jenkins Township
PENNSYLVANIA COAL CO.
HENRY HICE
B.H 11
B.H 16
B.H 17
B.H 18
B.H 5 $\frac{A}{64}$
B.H 13 A/70
B.H 14 A/70
B.H 15 A/70
FIFTH ST.
FOURTH ST.
THIRD ST
SECOND ST
FIRS
SUSQUEHANNA
AVE.
Wyoming Borough
Exeter Borough
DIAL ROCK

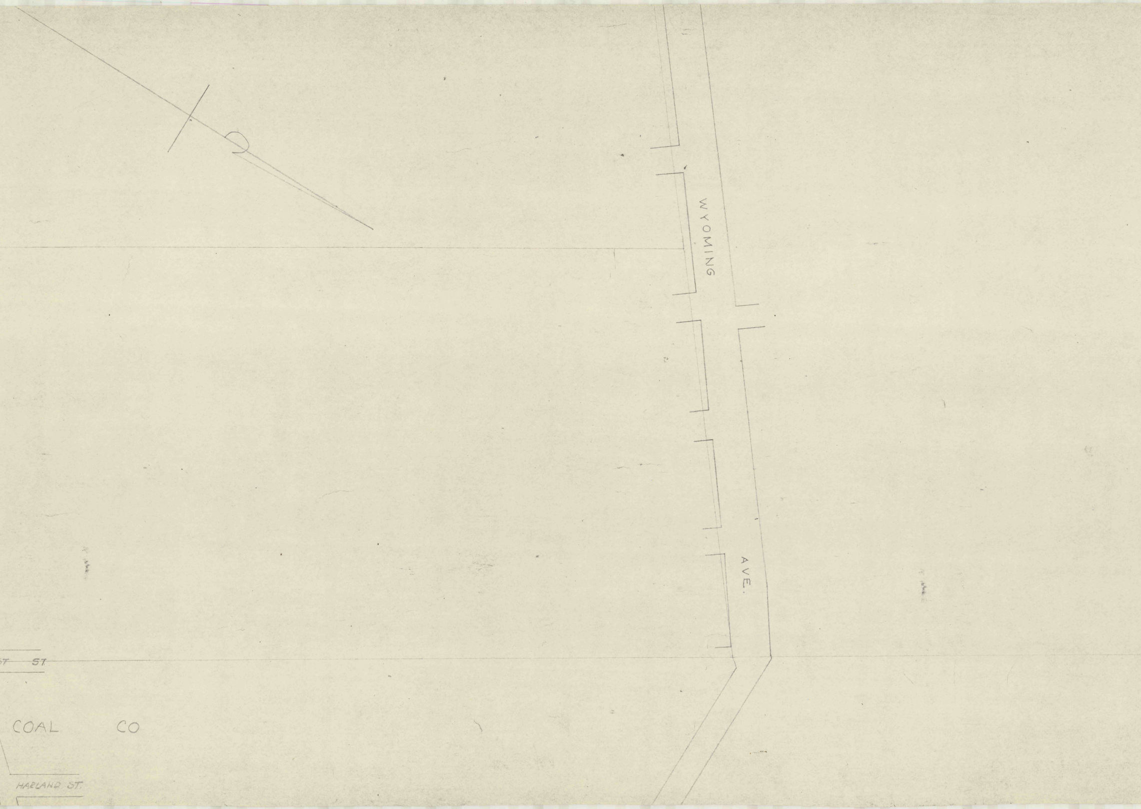
WYOMING
AVE.
ST ST
COAL CO
HARLAND ST.

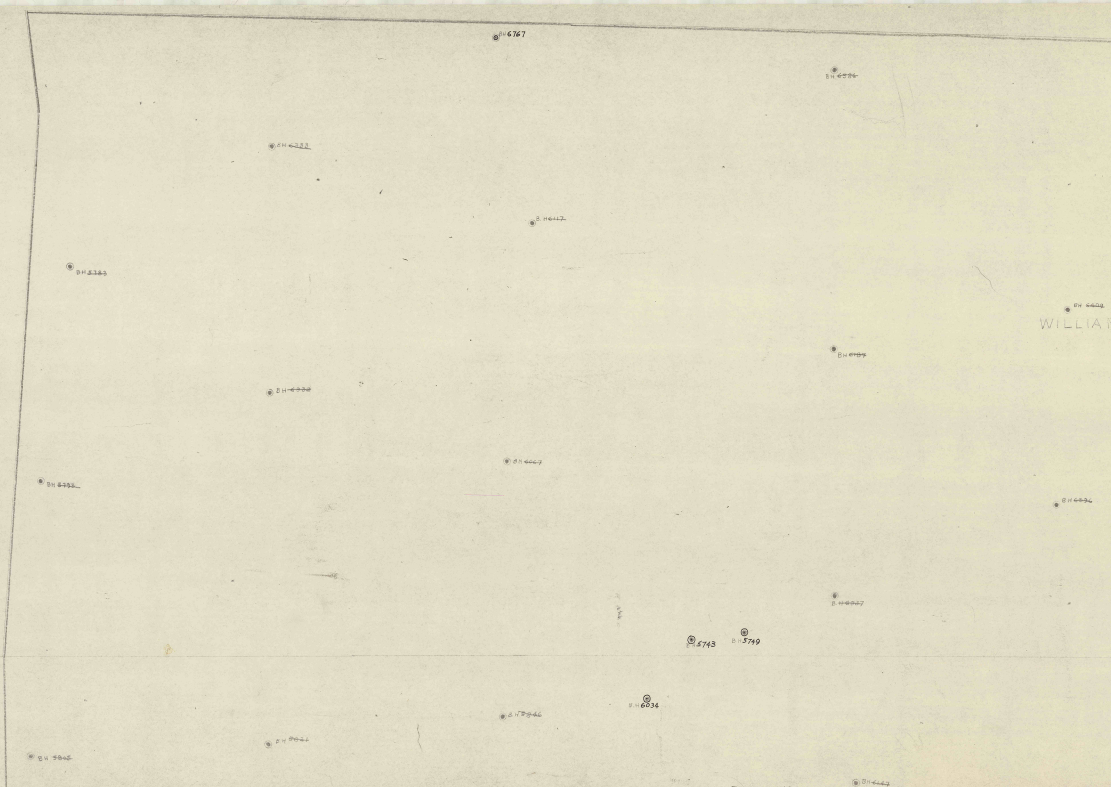
BH 6767
BH ~~6586~~
BH ~~6333~~
B. H~~6117~~
BH ~~5783~~
BH ~~6409~~
WILLIA
BH ~~6184~~
BH ~~6332~~
BH ~~6067~~
BH ~~5793~~
BH ~~6336~~
B. H ~~6337~~
B H 5743
B H 5749
B.H 6034
B.H ~~5846~~
B.H ~~5831~~
BH ~~5805~~
BH ~~6147~~

PENNSYLVANIA COAL CO   SCHOOLEY COLLIERY   PLATE 11

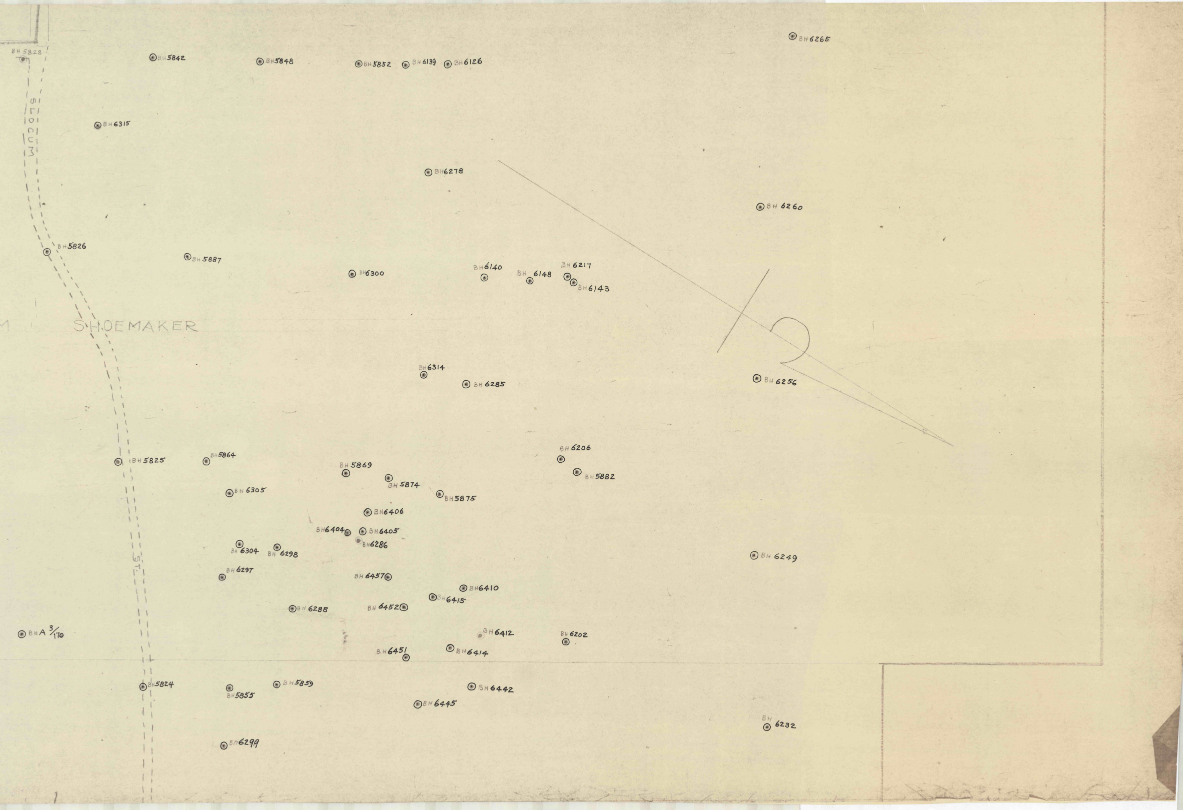
BH 5828
BH 5842
BH 5848
BH 5852
BH 6139
BH 6126
BH 6265
SLOCUM
BH 6315
BH 6278
BH 6260
BH 5826
BH 5887
BH 6300
BH 6140
BH 6148
BH 6217
BH 6143
M
SHOEMAKER
BH 6314
BH 6285
BH 6256
BH 6206
BH 5882
BH 5825
BH 5864
BH 5869
BH 5874
BH 5875
BH 6305
BH 6406
BH 6404
BH 6405
BH 6286
BH 6304
BH 6298
BH 6249
BH 6297
BH 6457
BH 6410
BH 6415
ST.
BH 6288
BH 6452
BH A 3/170
BH 6412
BH 6202
BH 6451
BH 6414
BH 5824
BH 5855
BH 5859
BH 6442
BH 6445
BH 6232
BH 6299