


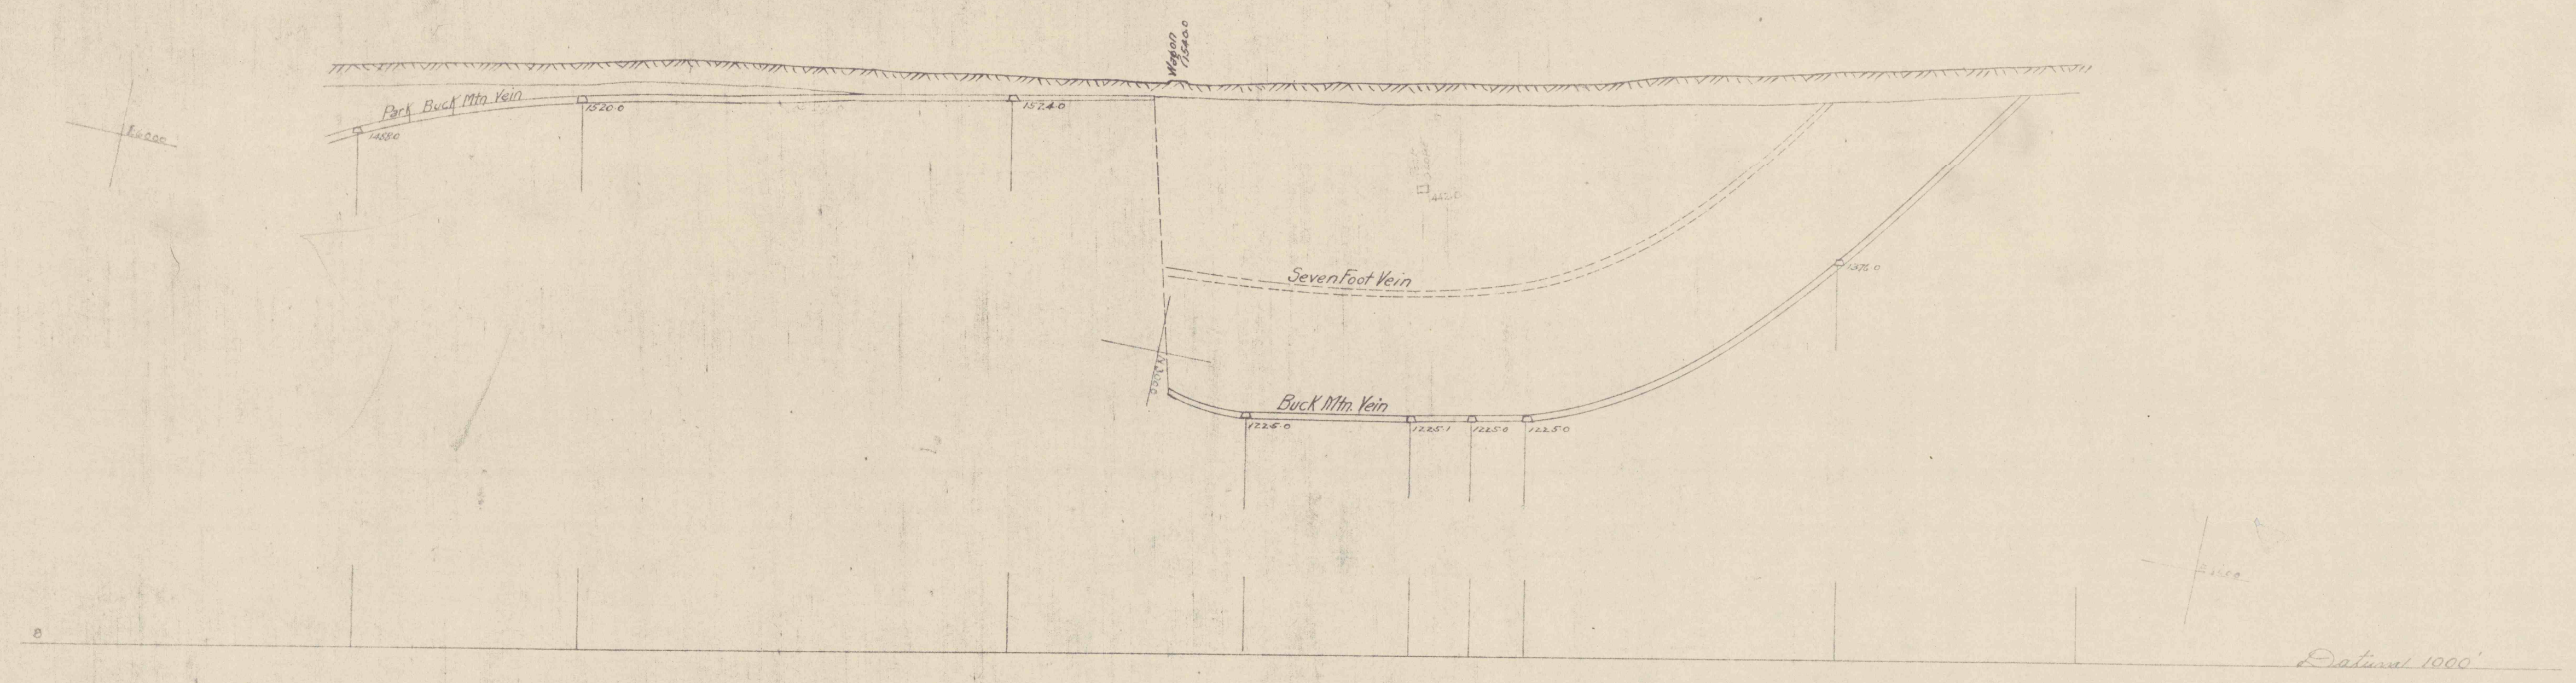

PRIMROSE COLLIERY
GENERAL CROSS SECTIONS


