




This explanation is only for
 editing purposes - this is
 not the final arrangement.
 Note -
 These x section lines
 have been changed so that
 A-A is at the top
 and D-D' is at the
 bottom.

 

STRUCTURAL CROSS SECTIONS

SCALE 1:12000

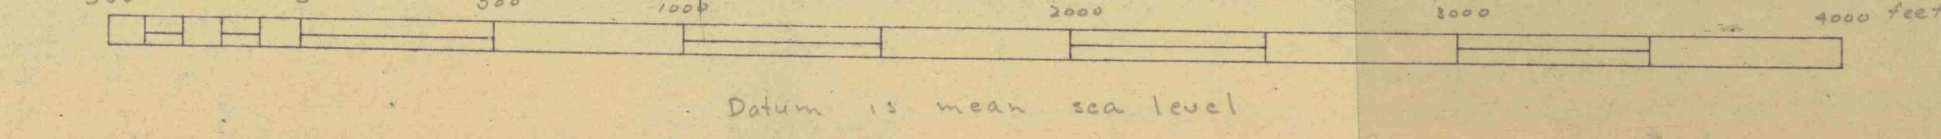

679
 11679