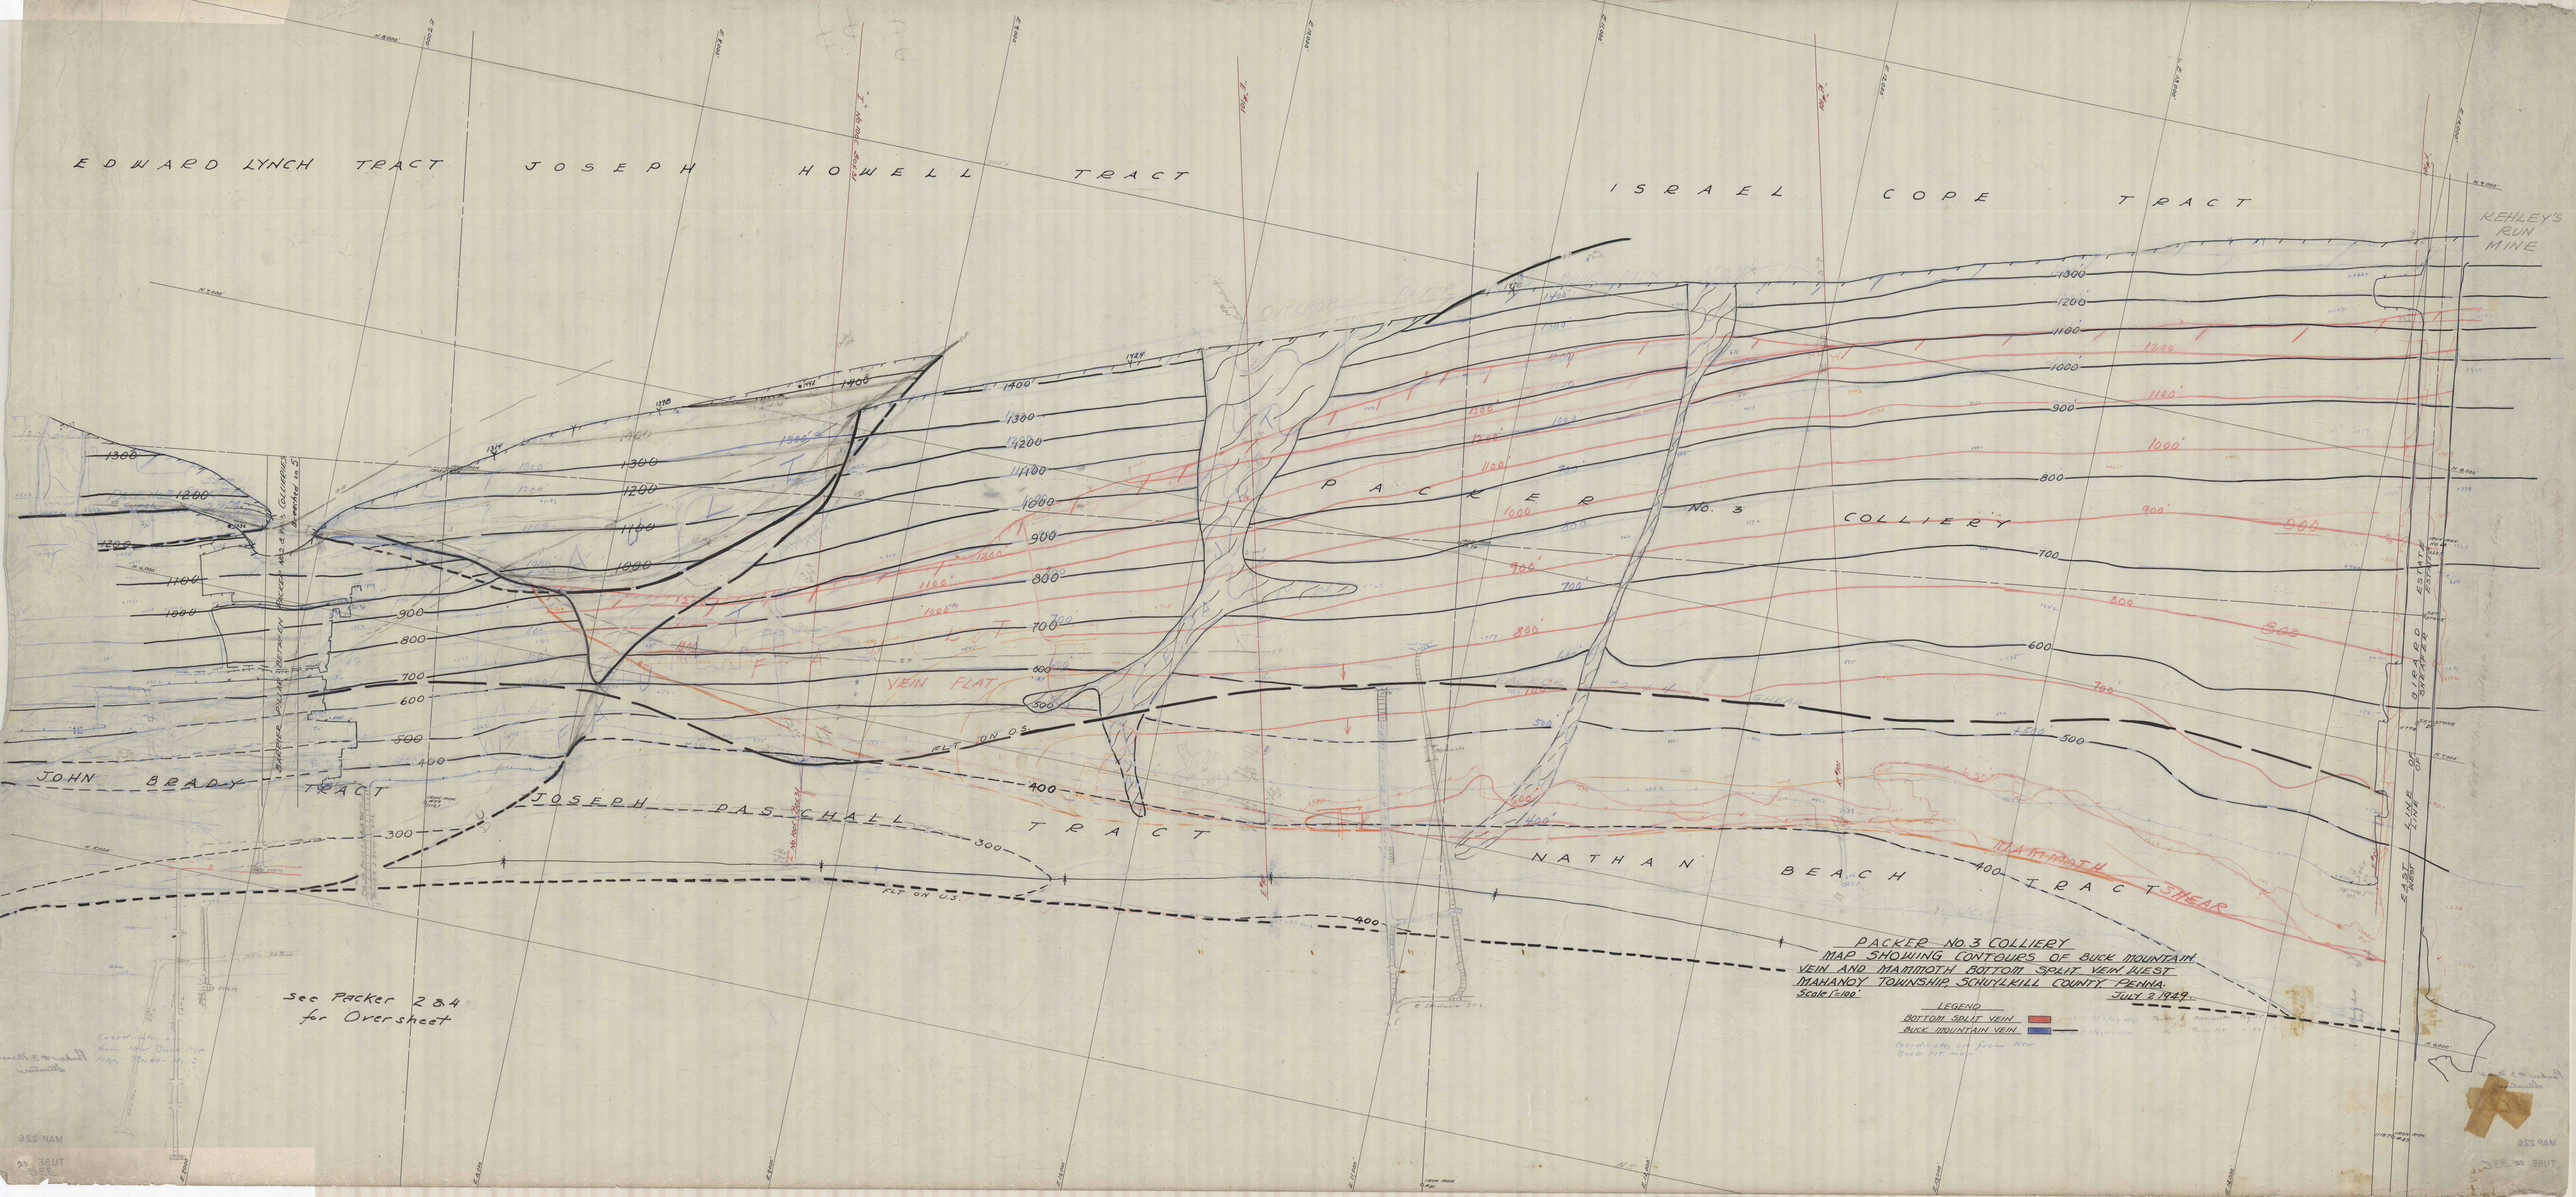

EDWARD LYNCH TRACT
JOSEPH HOWELL TRACT
ISRAEL COPE TRACT
KEHLEY'S RUN MINE
PACKER NO. 3 COLLIERY
JOHN BRADY TRACT
JOSEPH PASCHALL TRACT
NATHAN BEACH TRACT
BARRIER PILLAR BETWEEN PACKER NO. 2 & NO. 3 COLLIERIES
Breached on 5
VEIN FLAT
FLT ON O.S.
FLT ON U.S.
MAMMOTH SHEAR
GIRARD ESTATE
SHEAFER ESTATE
EAST LINE OF
WEST LINE
OUTCROP
N. 6,000'
IRON MON. #43
1118.7
1400
1300
1200
1100
1000
900
800
700
600
500
400
300

See Packer 2 & 4 for Oversheet

PACKER NO. 3 COLLIERY

MAP SHOWING CONTOURS OF BUCK MOUNTAIN
VEIN AND MAMMOTH BOTTOM SPLIT VEIN, WEST
MAHANOY TOWNSHIP, SCHUYLKILL COUNTY, PENNA.

Scale 1" = 100'

JULY 2, 1949.

LEGEND

BOTTOM SPLIT VEIN 🟥 checked 7/16/49 HER Packer 3 Mammoth Tag
BUCK MOUNTAIN VEIN 🟦 checked 7/23/49 HER do Buck Mt.

Coordinates are from New Buck Mt. map

Packer #3 Mine Structure