


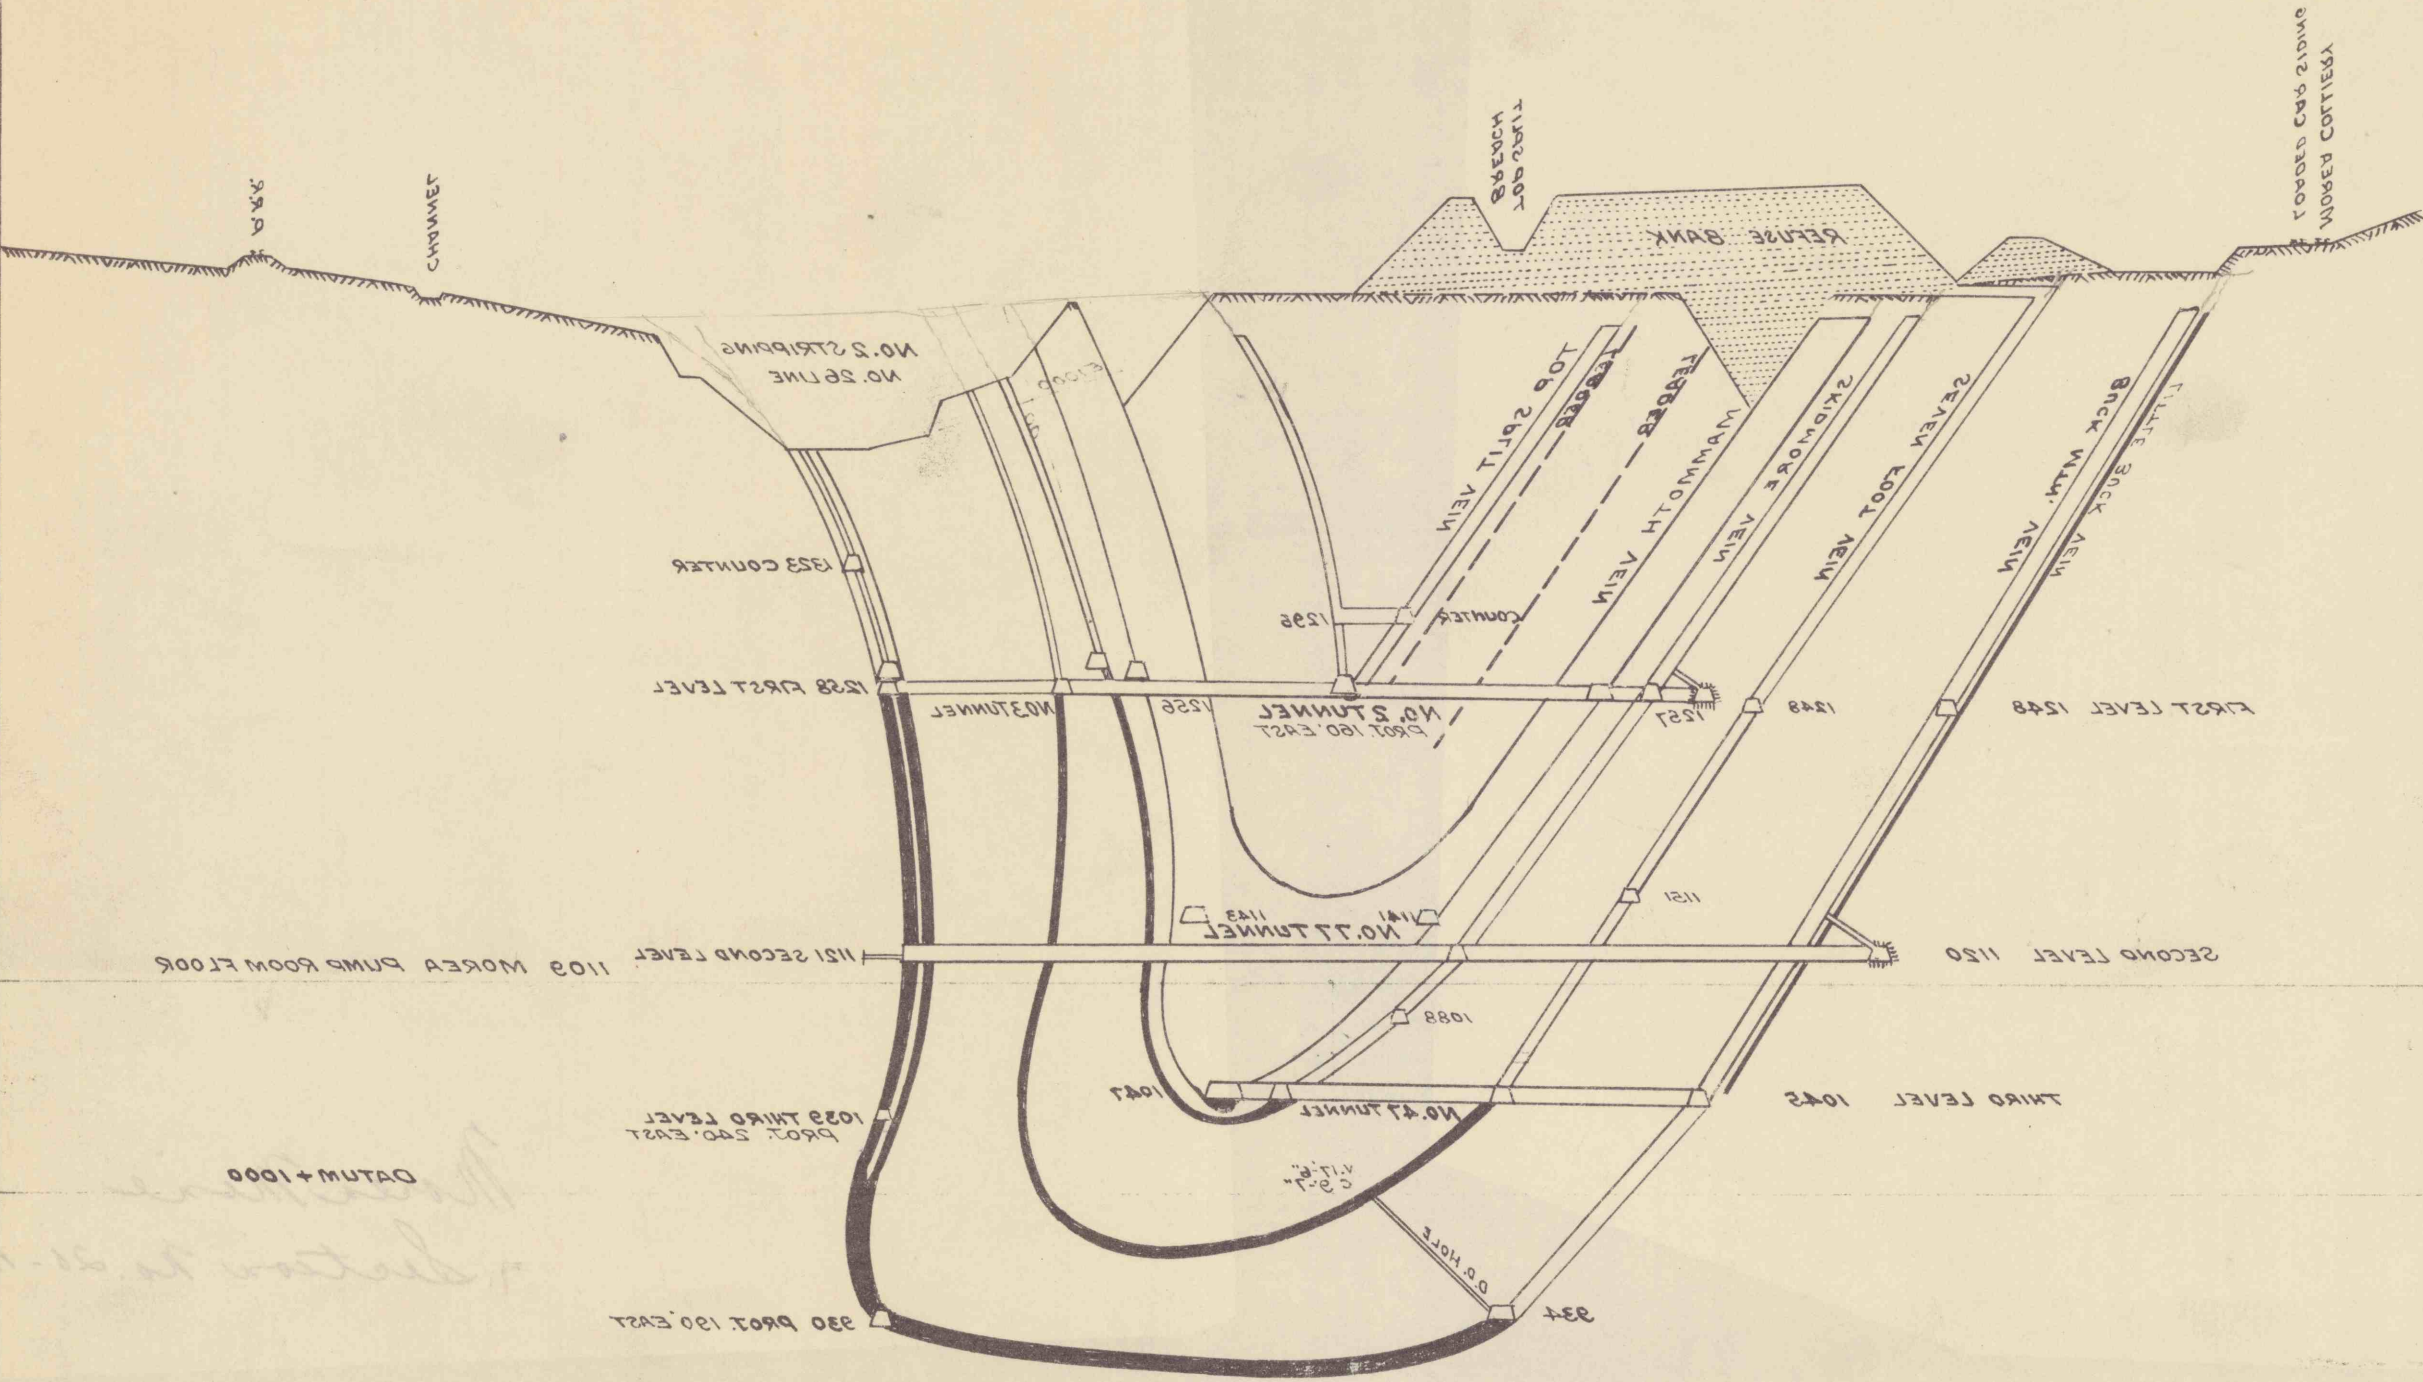

NO. 20-A
 MOREA COLLIERY
 SECTION THRU NO. 21 TUNNEL
 SCALE 1"=100'