


100 FOOT SCALE
 SECTION 100 FEET EAST OF THE REHLE WEST LINE
 — No. 2A —
 MOREA COLLIERY

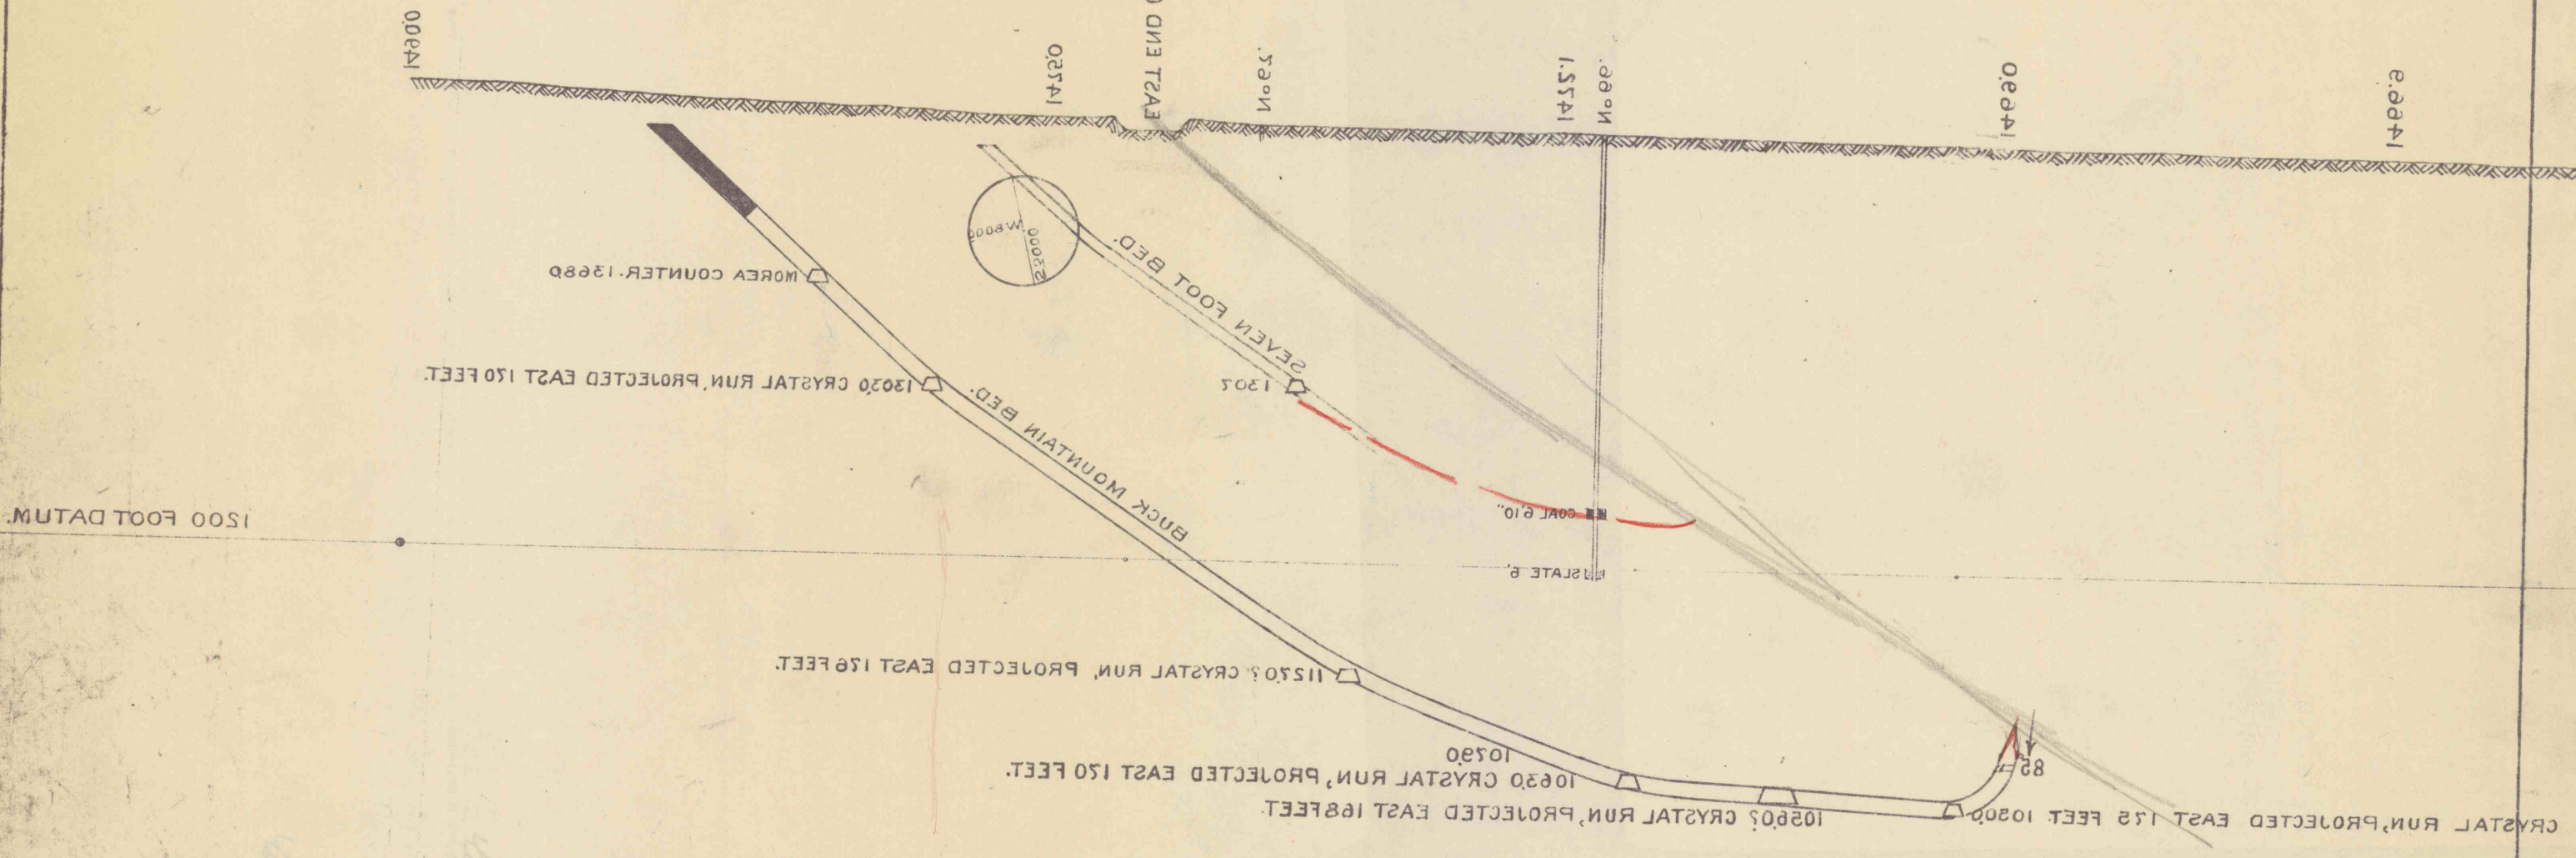

WOOD
 0.00032