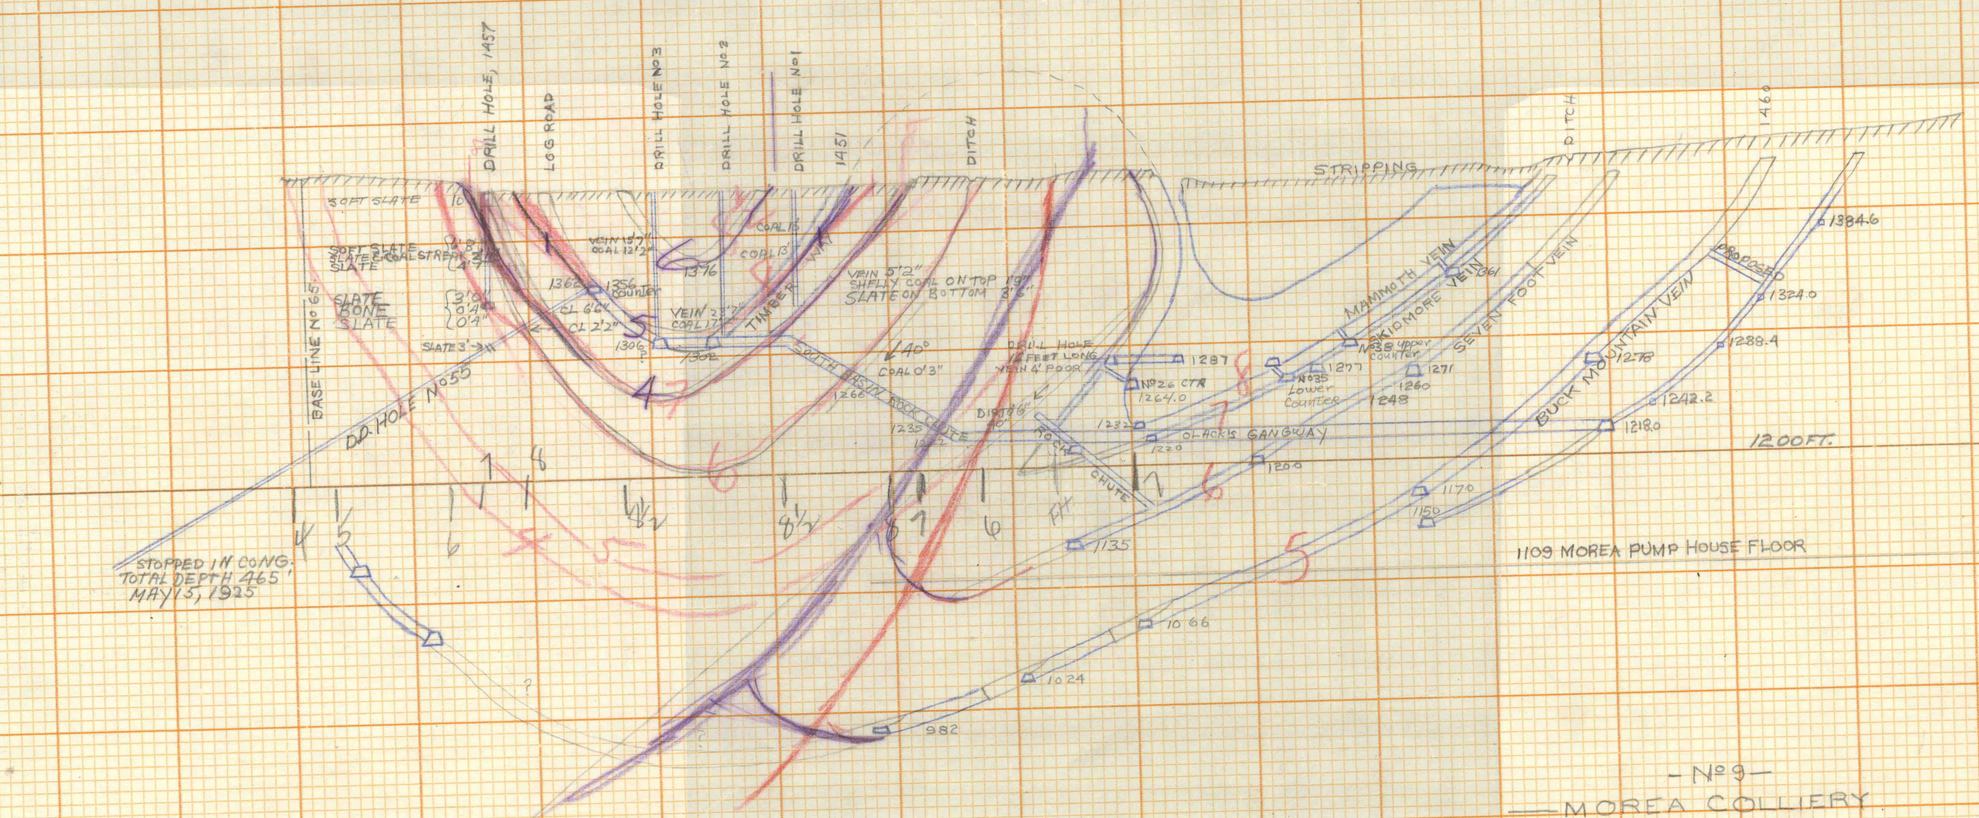

— No 9 —

MOREA COLLIERY

SECTION THROUGH THE SOUTH BASIN ROCK HOLE OR 1540 FEET WEST OF THE DELANO WEST LINE

1" = 100'

10-23-27

MAP X-73
TUBE 434