


S

N

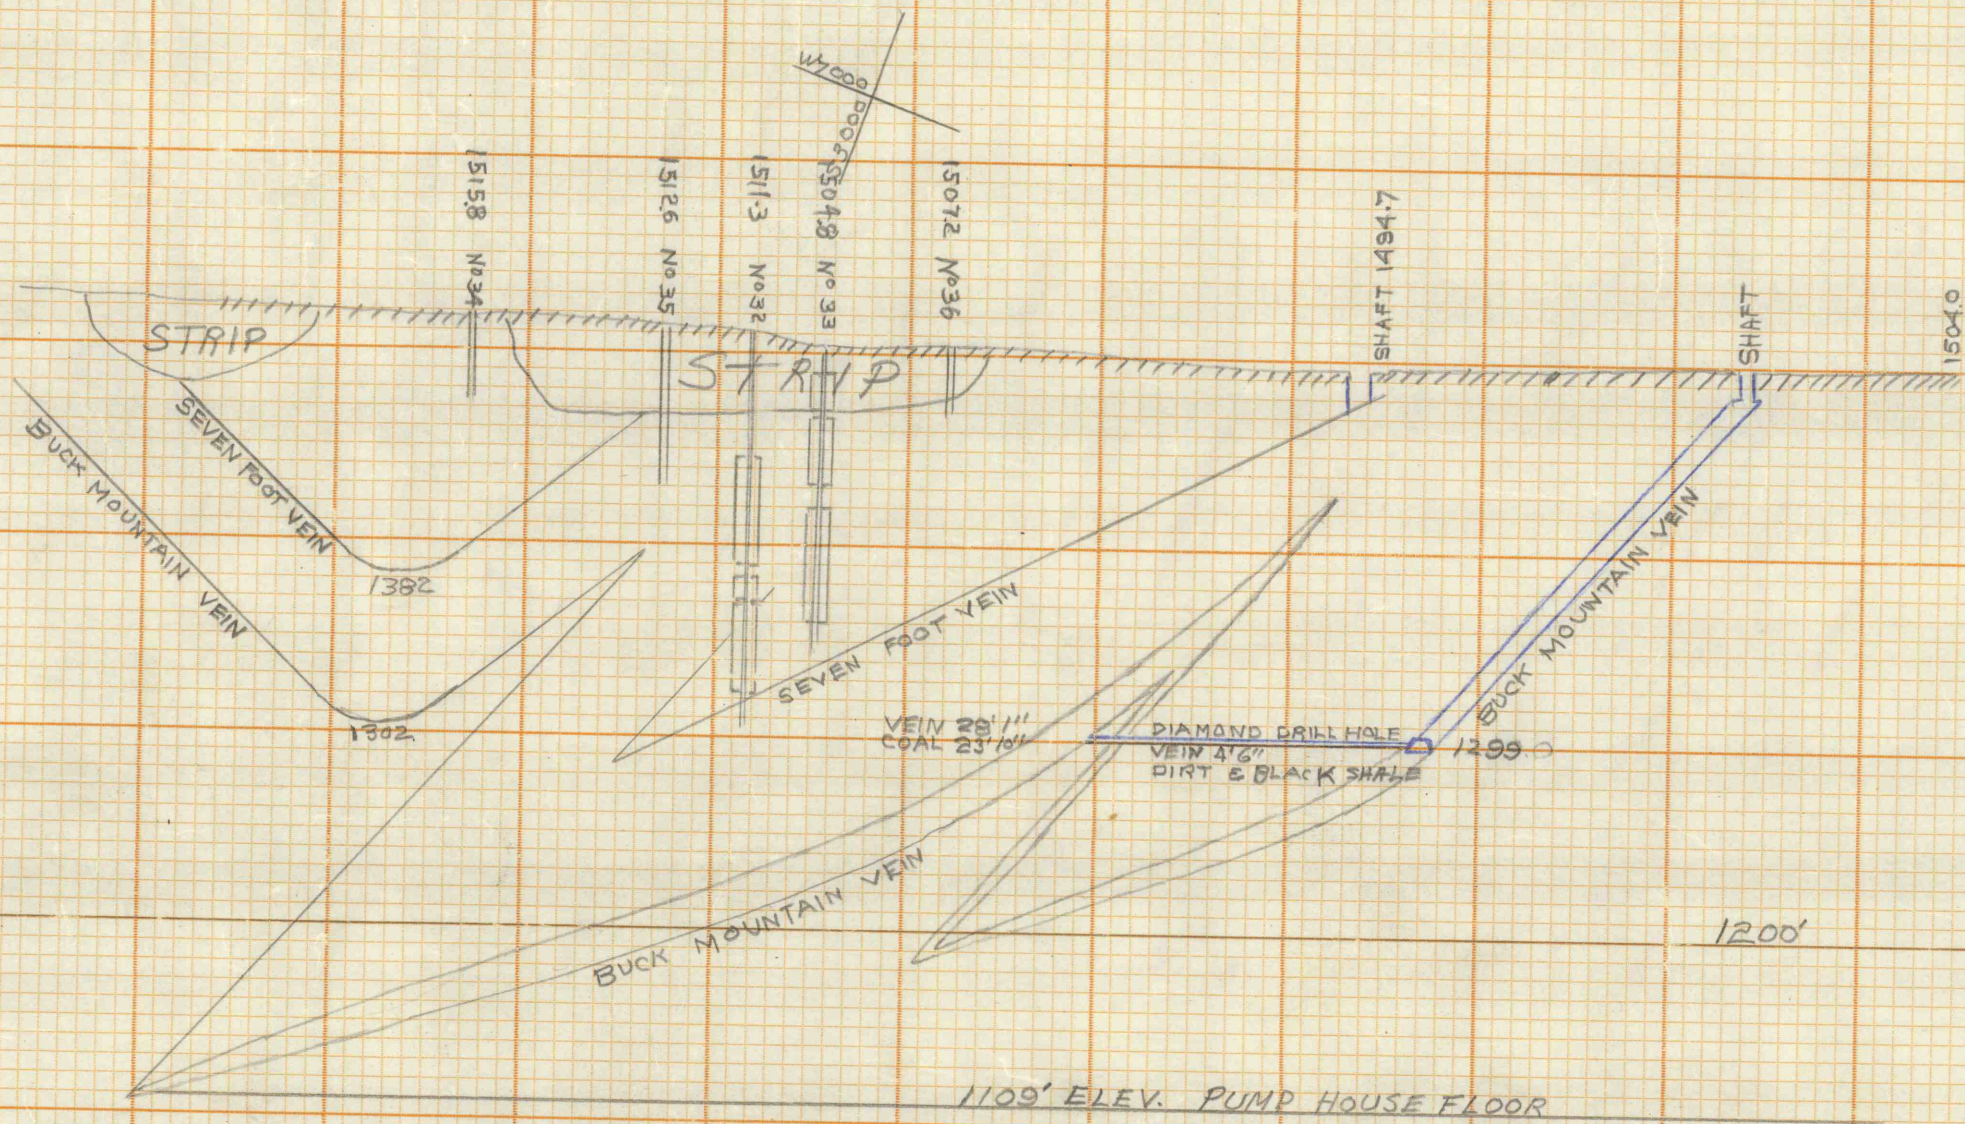

- N25 -

MOREA COLLIERY
SECTION 4410 FEET WEST OF THE
DELANO WEST LINE
OR THROUGH BREAST NO 91 IN THE
FIRST WEST SOUTH DIP

BUCK MOUNTAIN VEIN GANGWAY

1" = 100'

MAP X-EE

TUBE X-EE

43A

MAP X-EE

TUBE X-EE

43A

W6000