


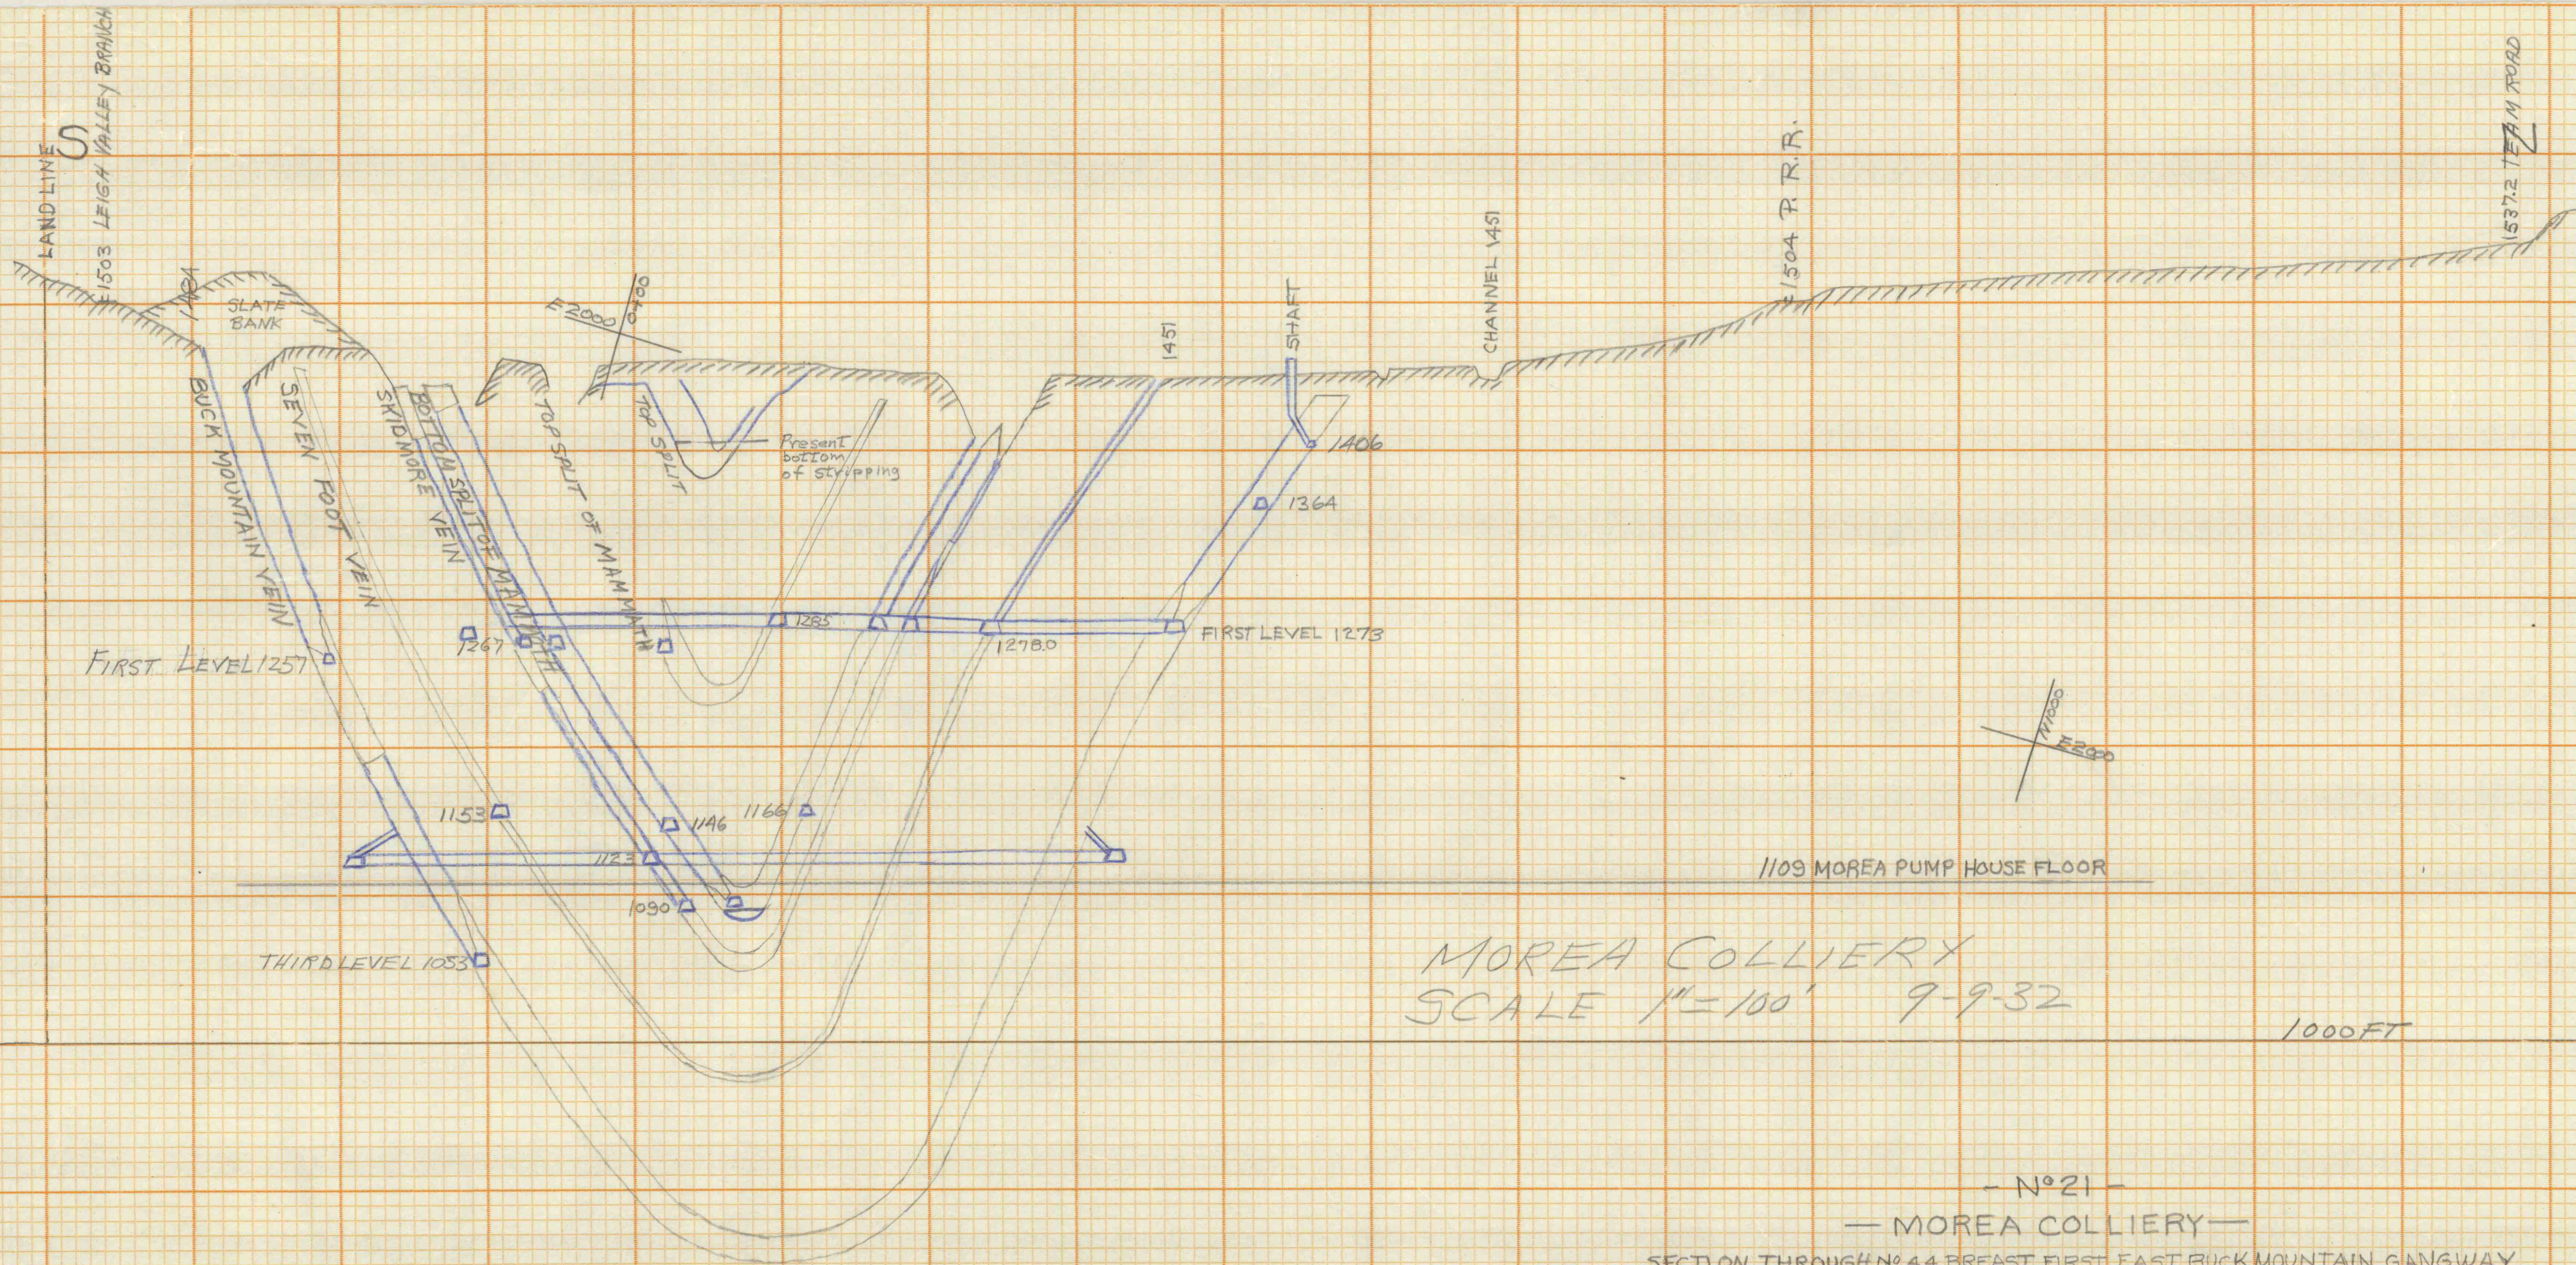

MOREA COLLIERY
SCALE 1"=100' 9-9-32

- N° 21 -
- MOREA COLLIERY -
SECTION THROUGH N° 44 BREAST, FIRST EAST BUCK MOUNTAIN GANGWAY
1"=100'

MAP-X-30

MAP X30

TUBE-X-30

TUBE-X-30