
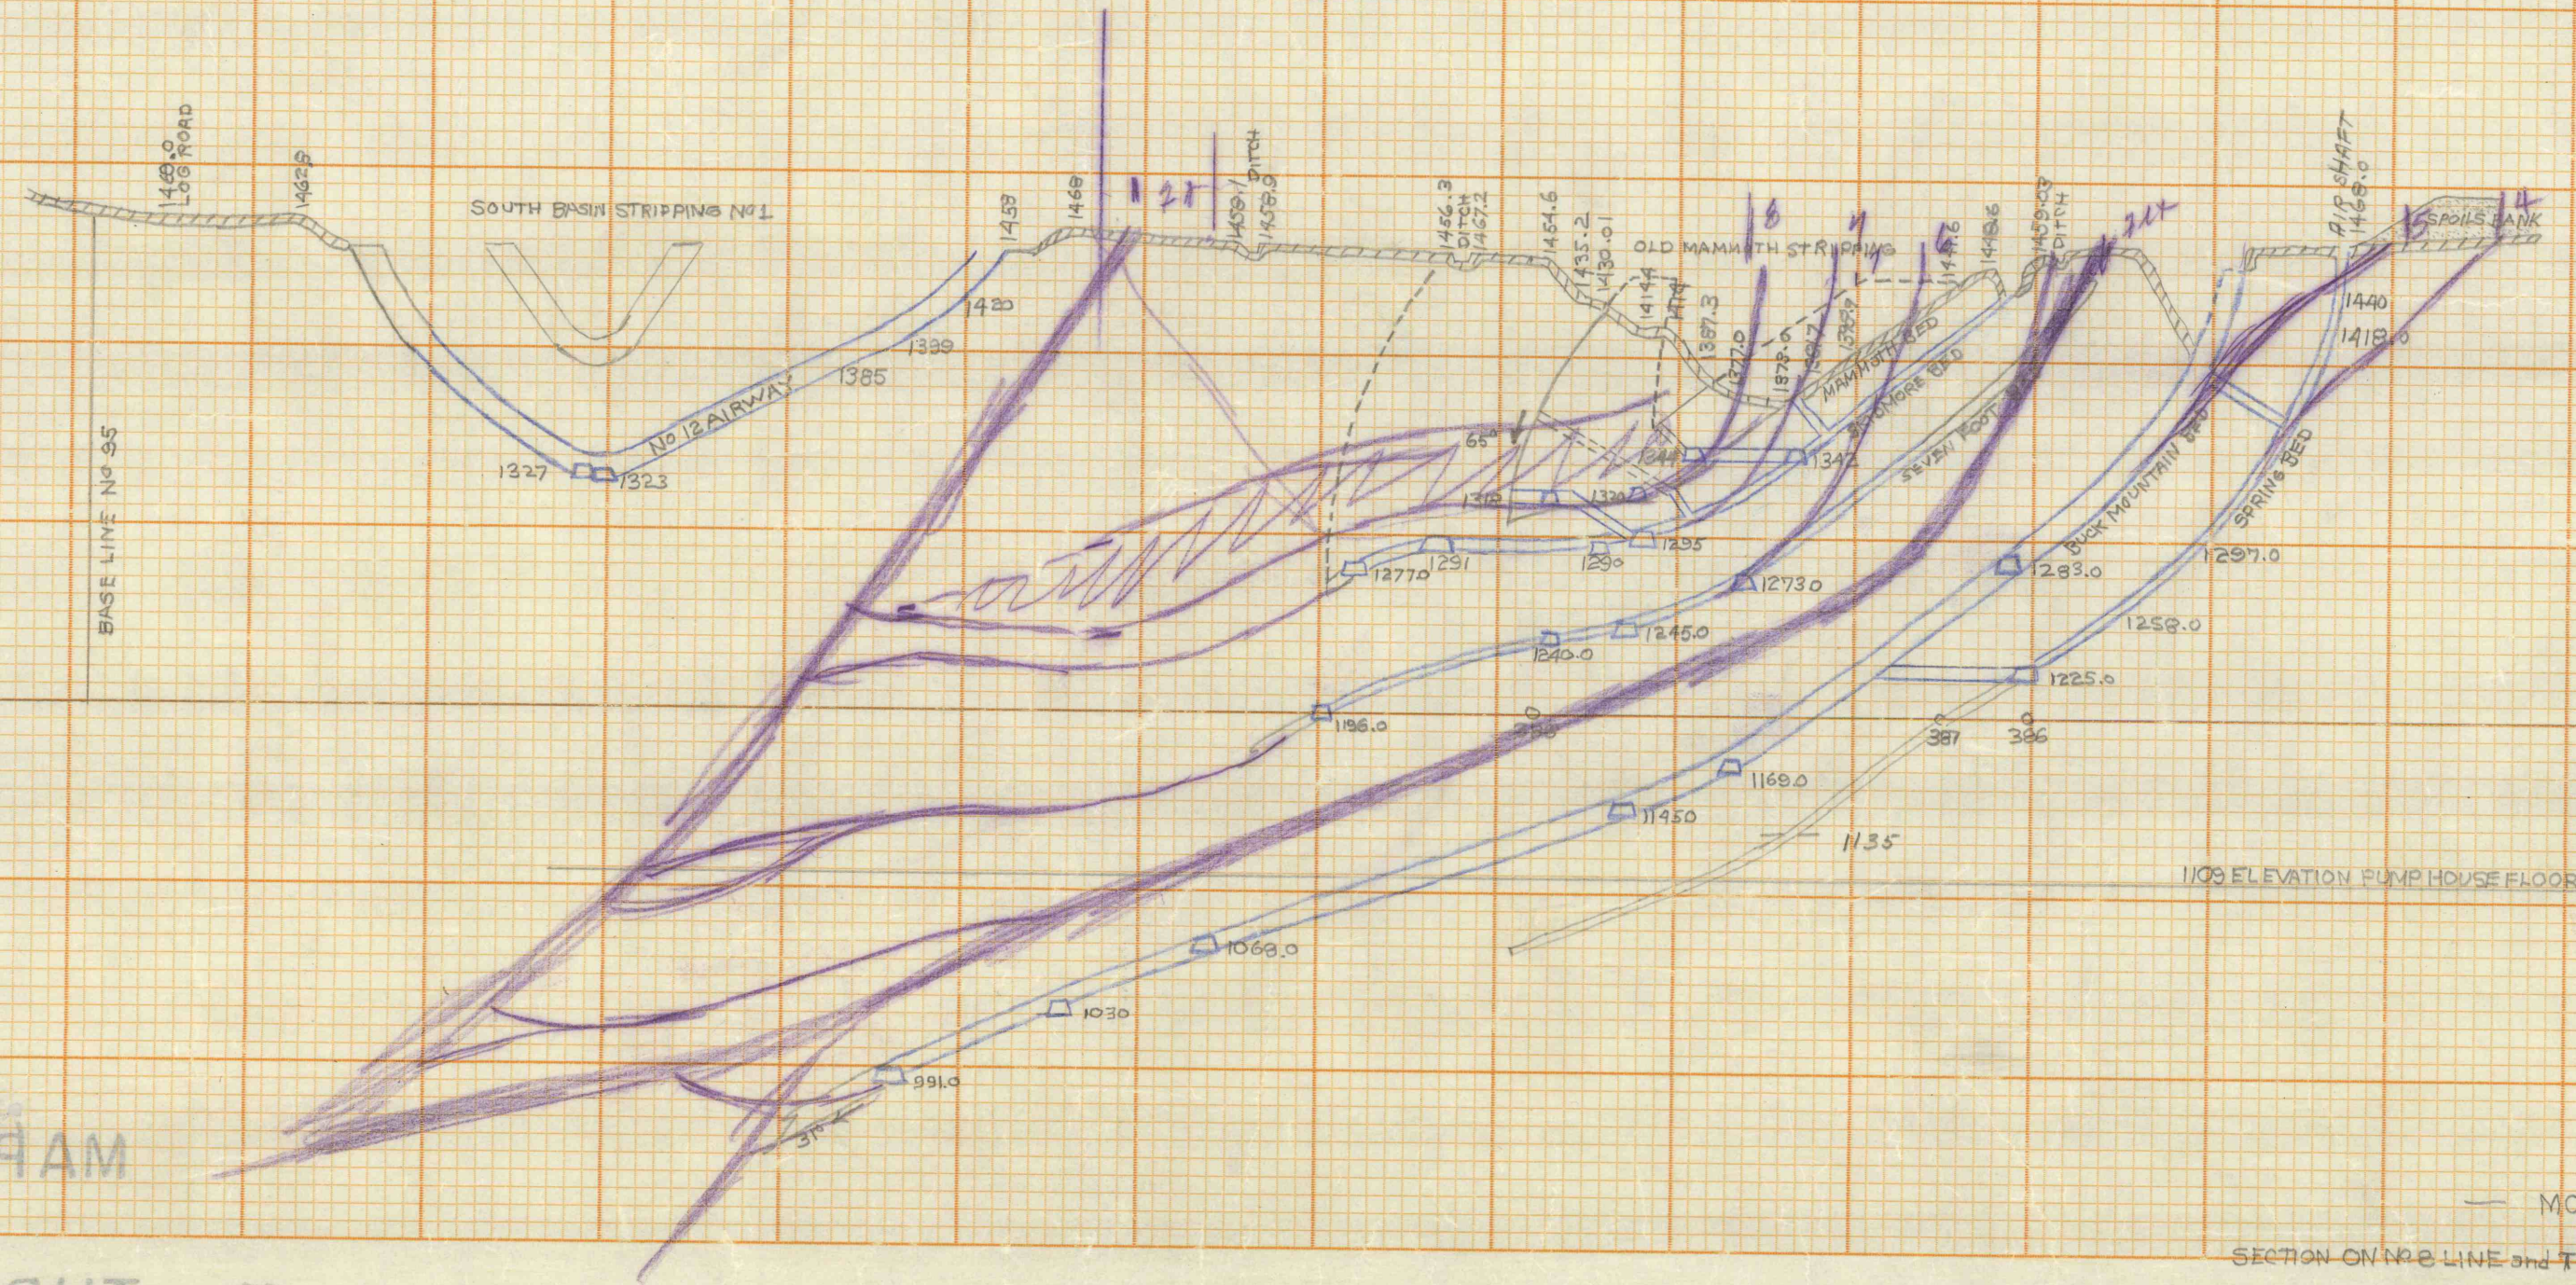


S

N

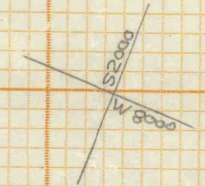

MAP X-28

MAP X-28

MOREA COLLIERY

SECTION ON NO 8 LINE and THROUGH NO 38 WEST SKIDMORE COUNTER

RELATIVE TO THE OLD MAMMOTH STRIPPING

1" = 100'

Dec 19, 1927

TUBE

TUBE