


S

N

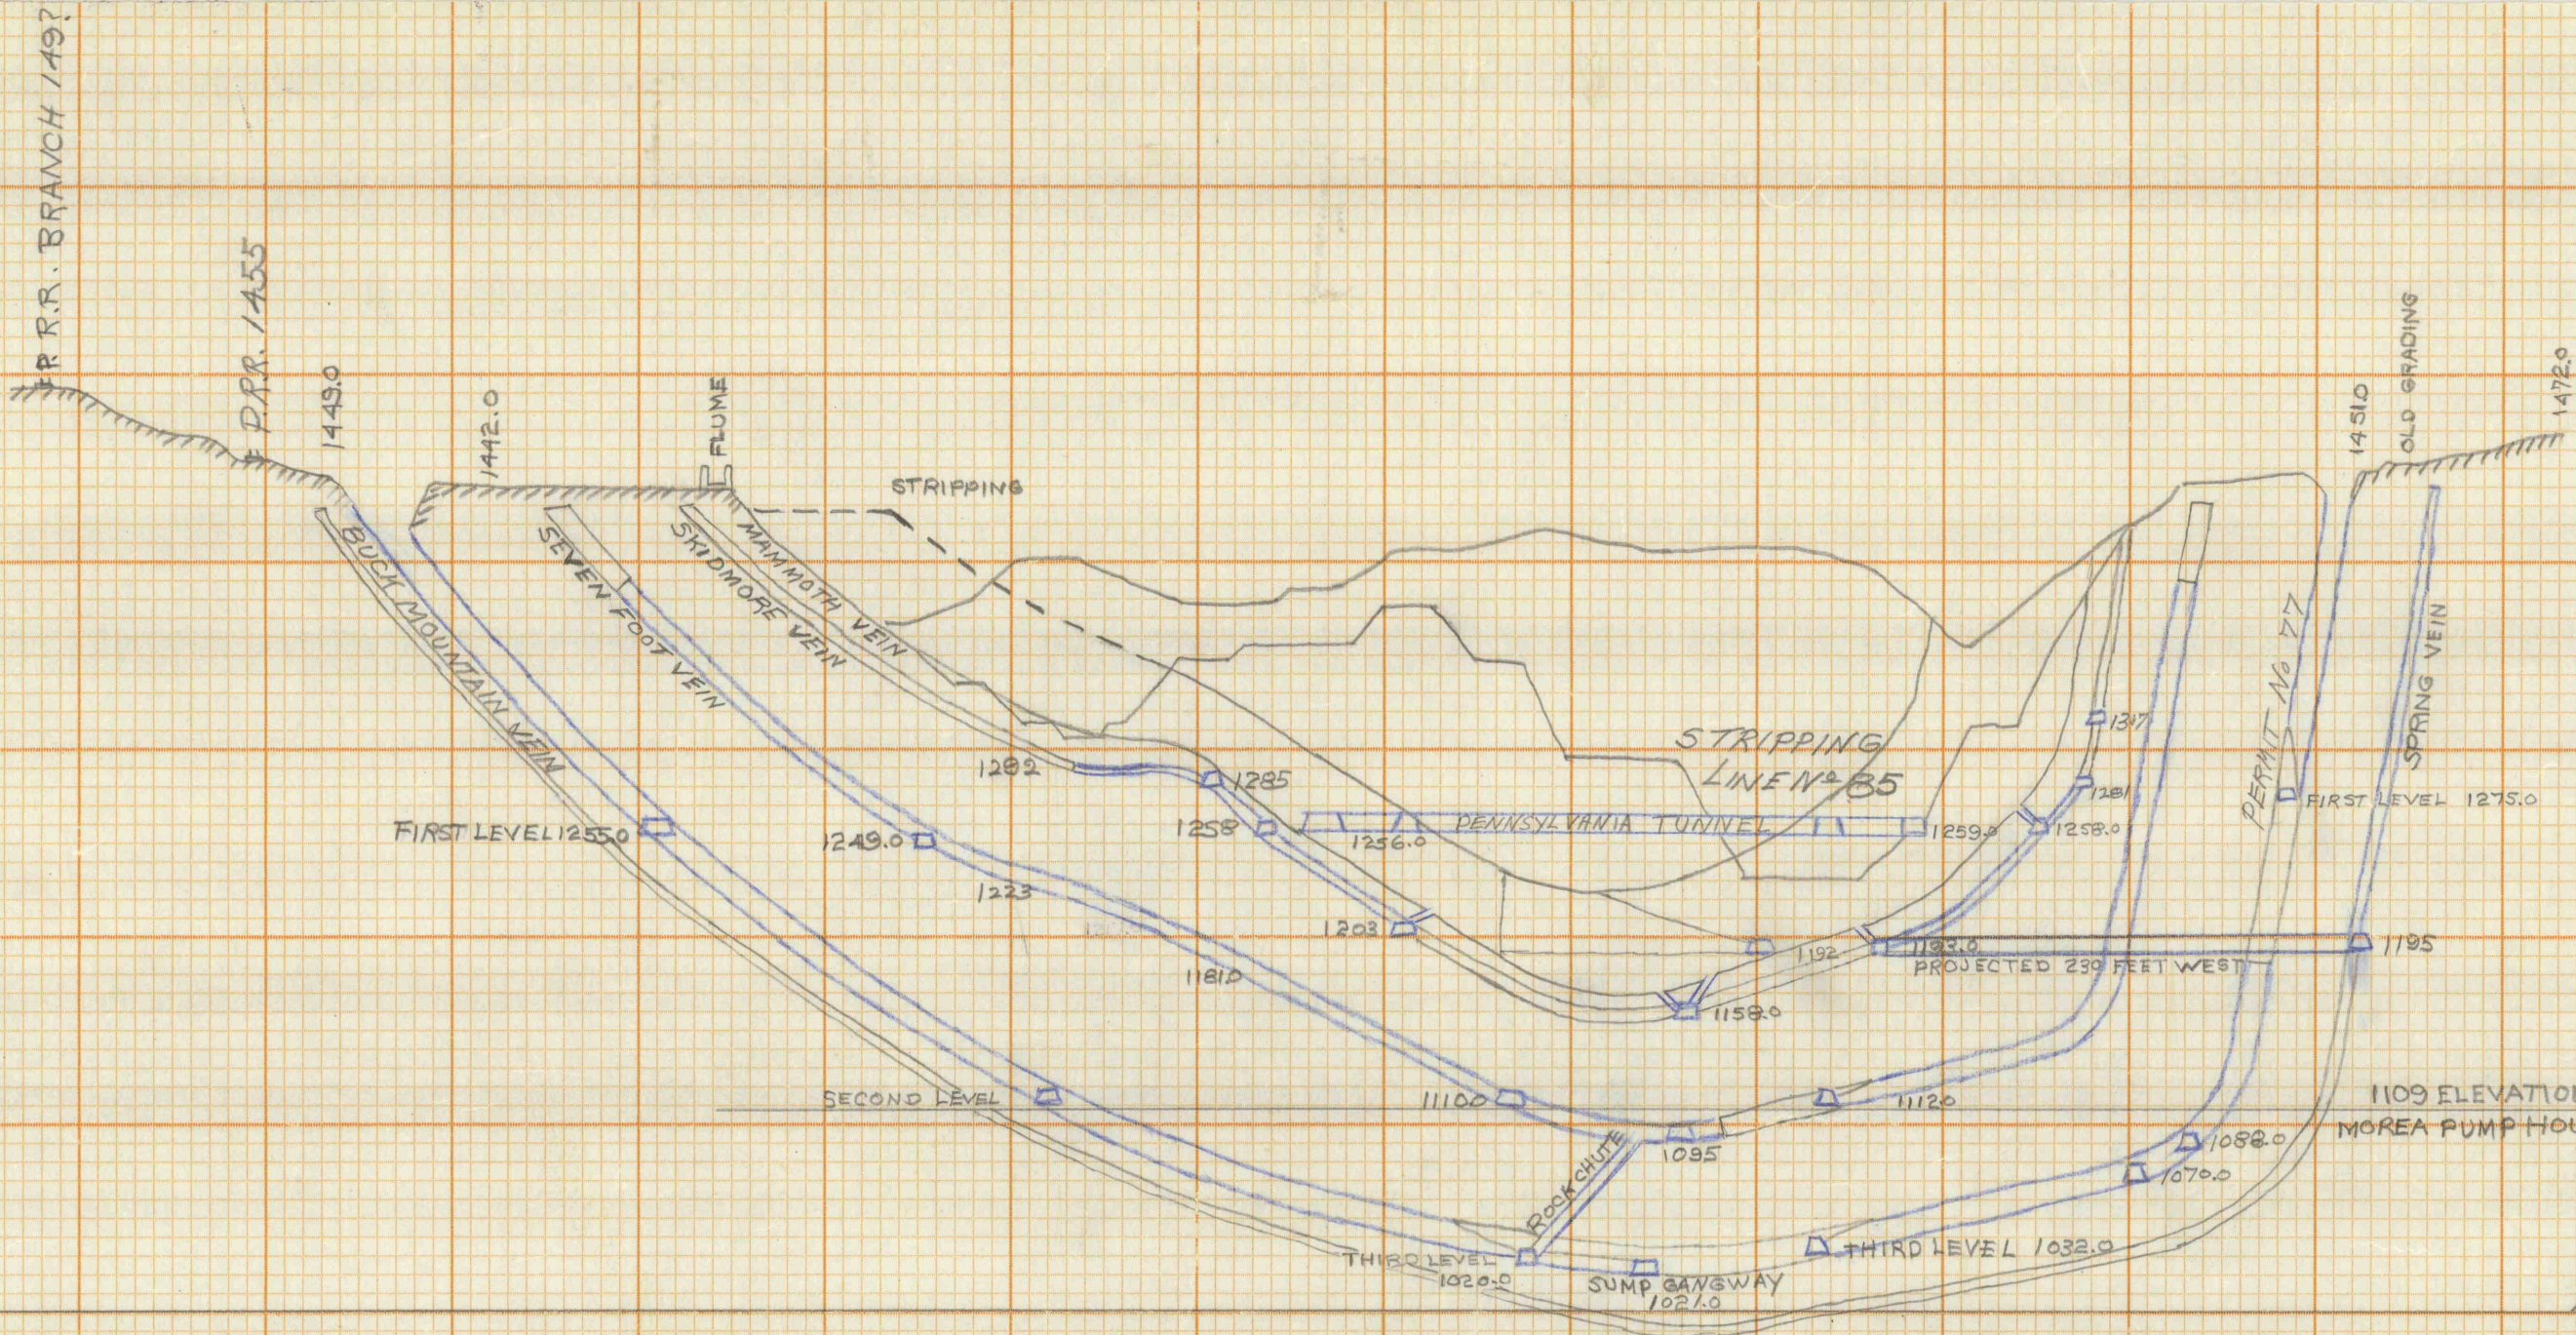

53000
W

53000
W

- No 15 -
- MOREA COLLIERY -
SECTION THROUGH No 32 BREAST FIRST WEST BUCK MOUNTAIN GANGWAY
1" = 100'

MAP-X-80

MAP-X-80

TUBE #13A

TUBE #13A

"PERFECT" CROSS SECTION
10 X 10 = ONE INCH
EUGENE DIETZEN CO.

PRINTED IN U.S.A.
PAPER MADE IN U.S.A.