


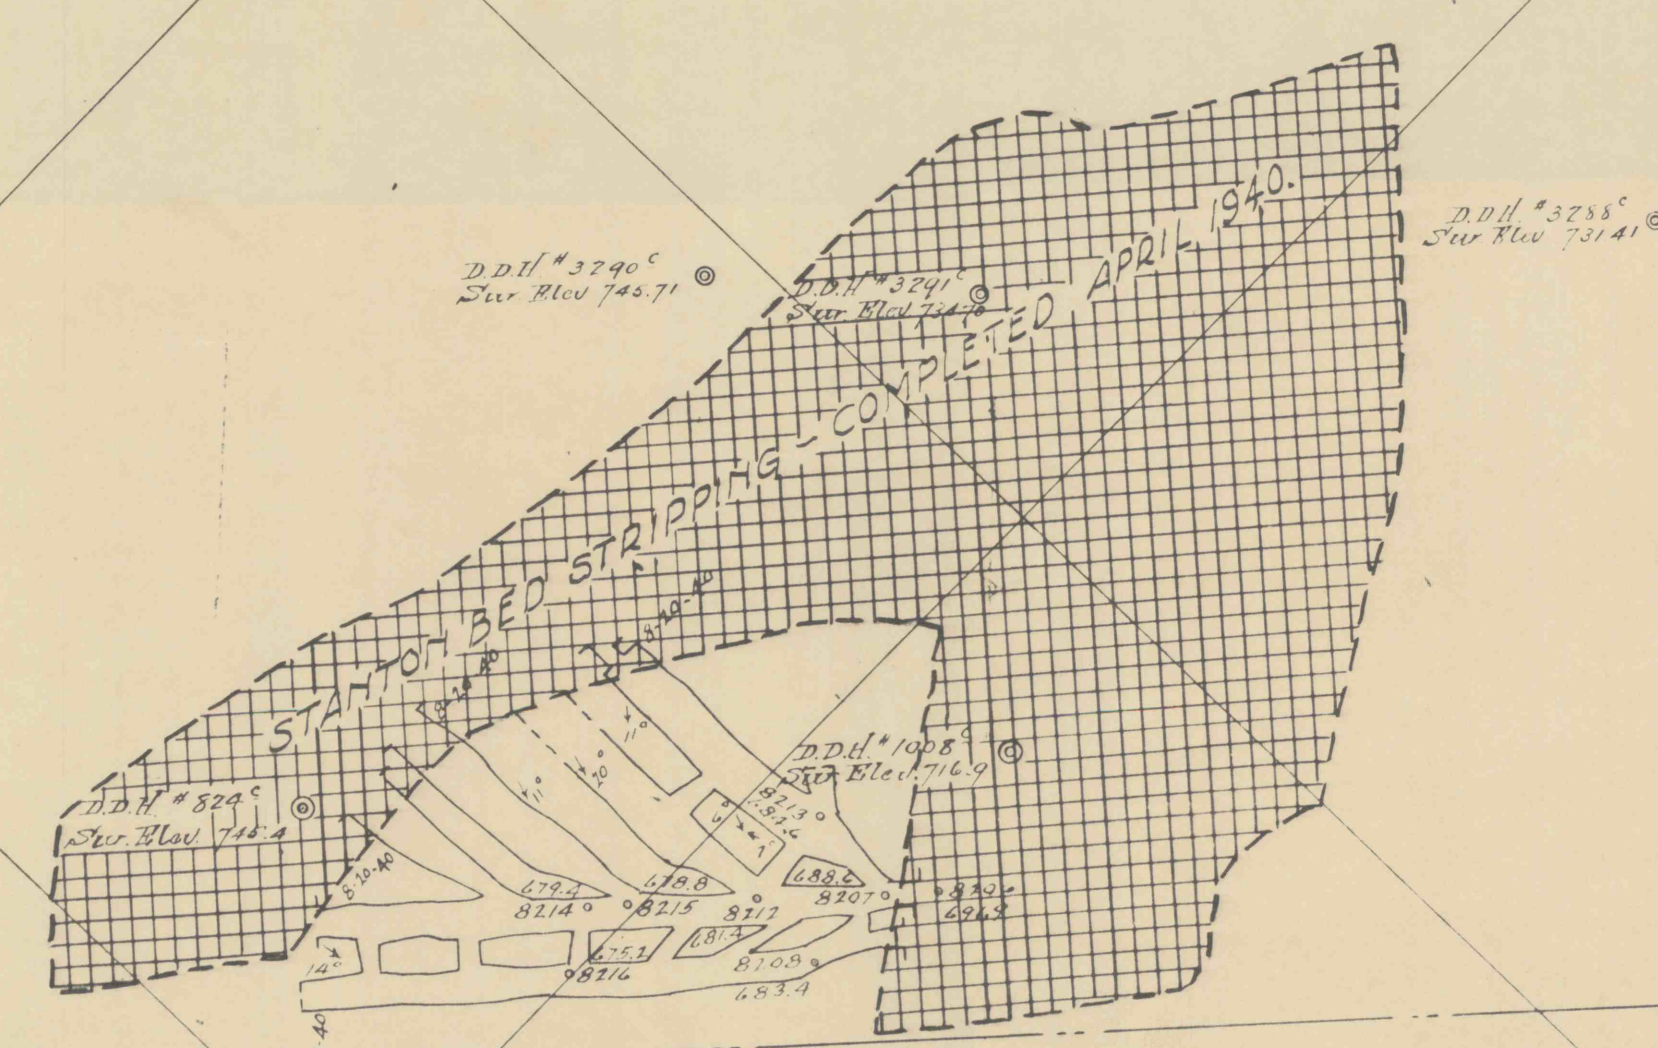

BALTIMORE COLLIERY.  
STANTON BED.  
SUPPLEMENT TO  
WEST SECTION  
SCALE 1"=100'