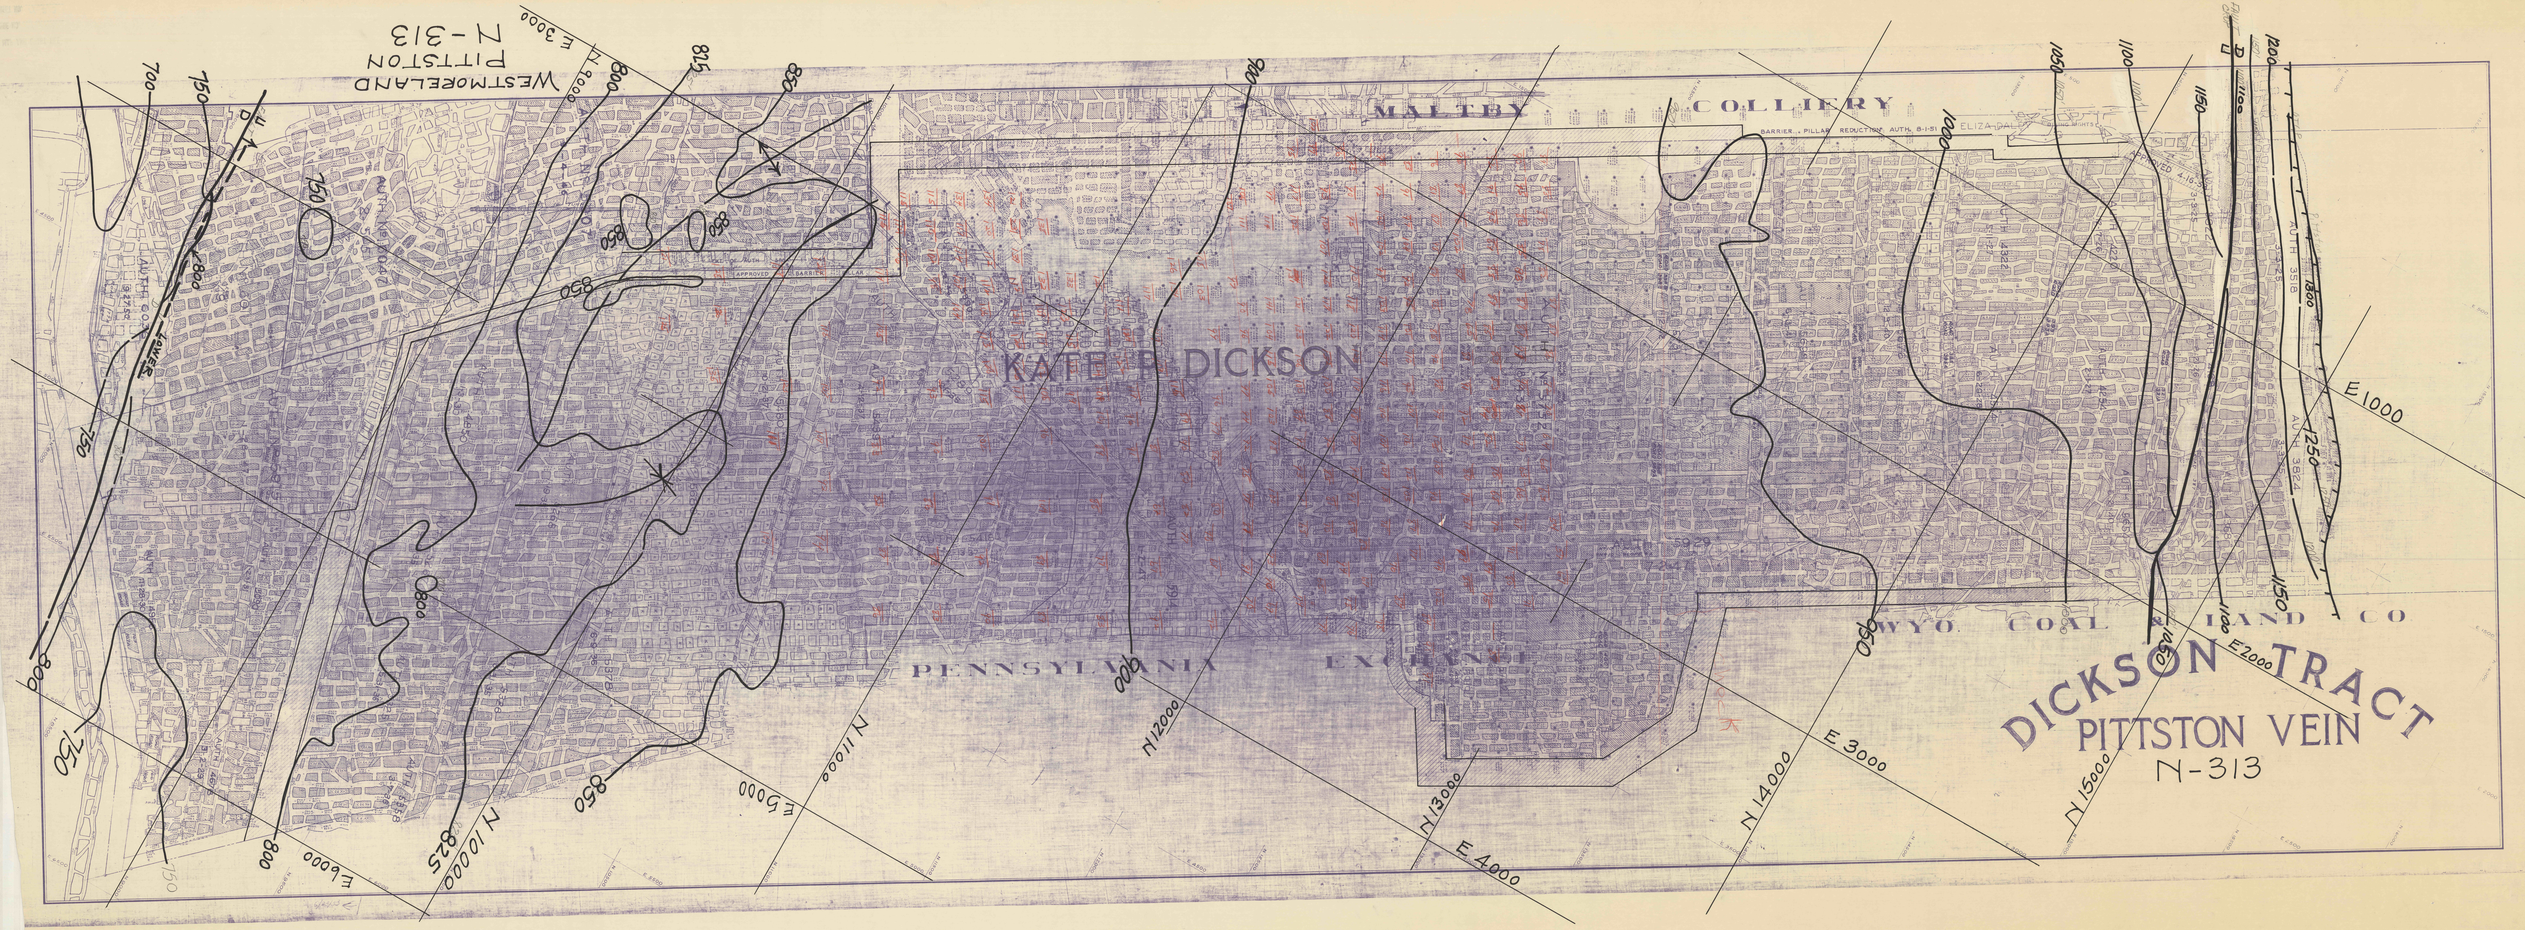
WESTMORELAND
PITTSTON
Z-313
MALTBY
COLLIERY
KATE B. DICKSON
PENNSYLVANIA
WYO. COAL LAND CO
DICKSON TRACT
PITTSTON VEIN
N-313
N 10000
N 11000
N 12000
N 13000
N 14000
N 15000
E 3000
E 4000
E 2000
E 1000
E 5000
E 6000