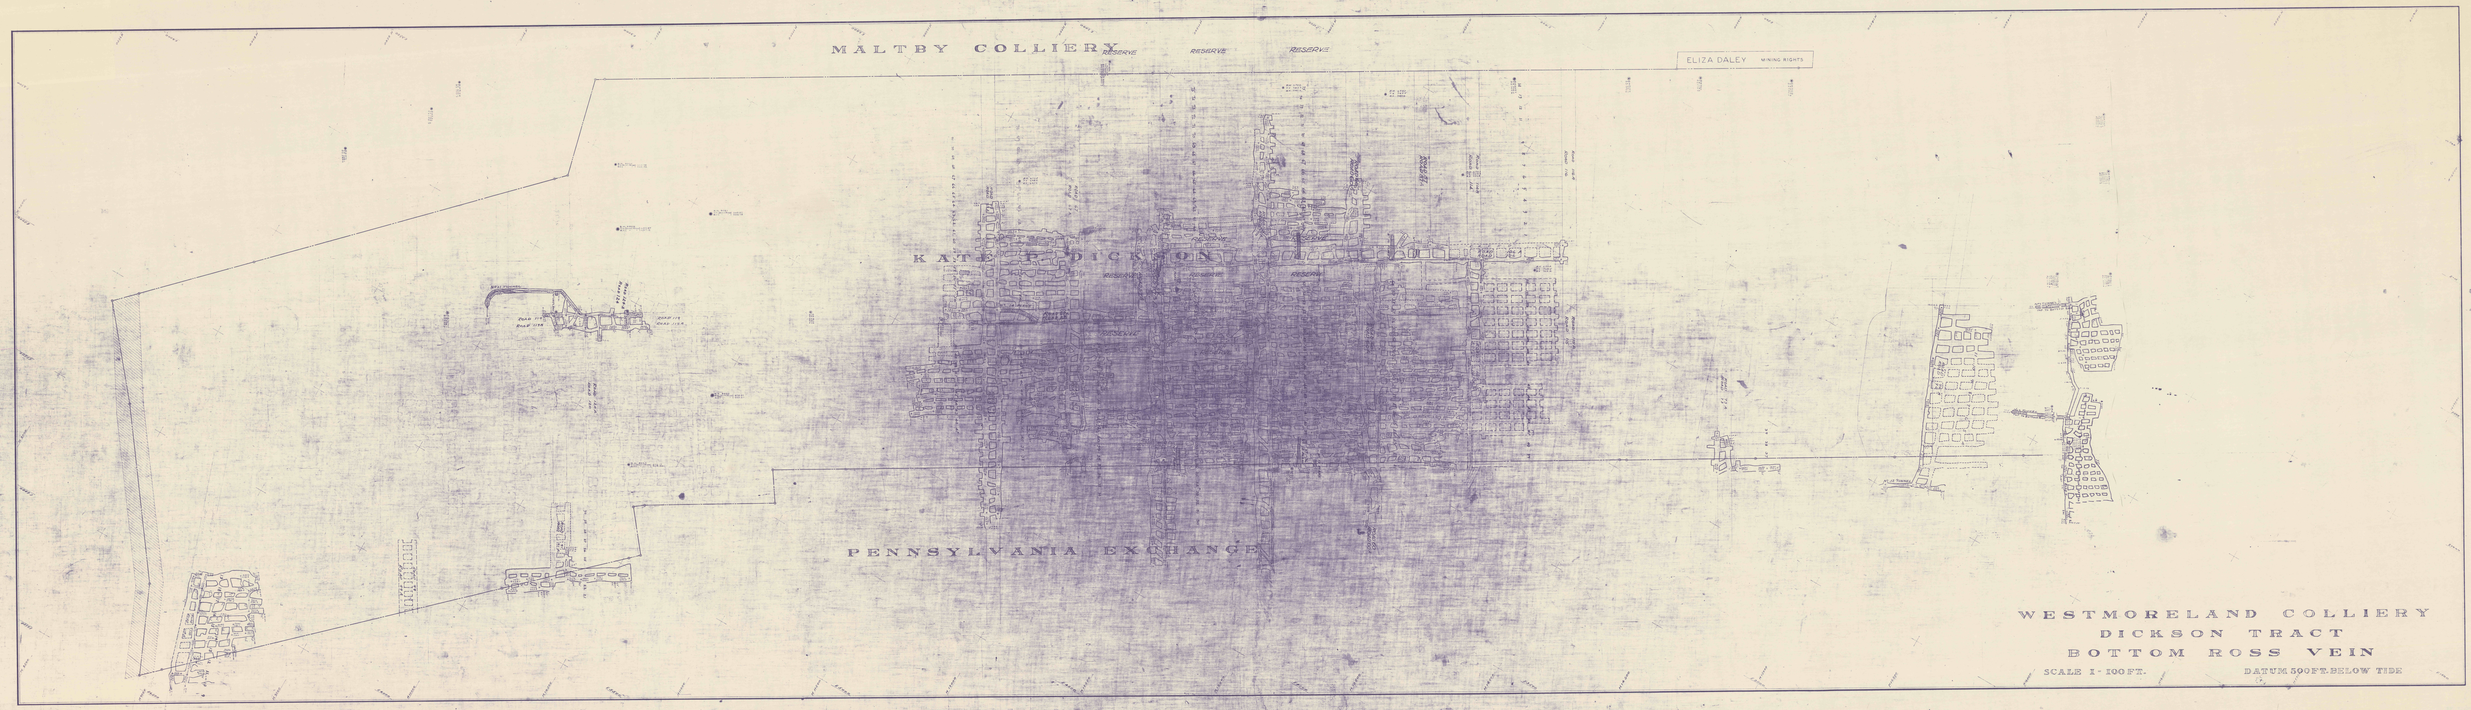

WESTMORELAND COLLIERY

DICKSON TRACT

BOTTOM ROSS VEIN

SCALE 1- 100 FT. DATUM 500 FT. BELOW TIDE