
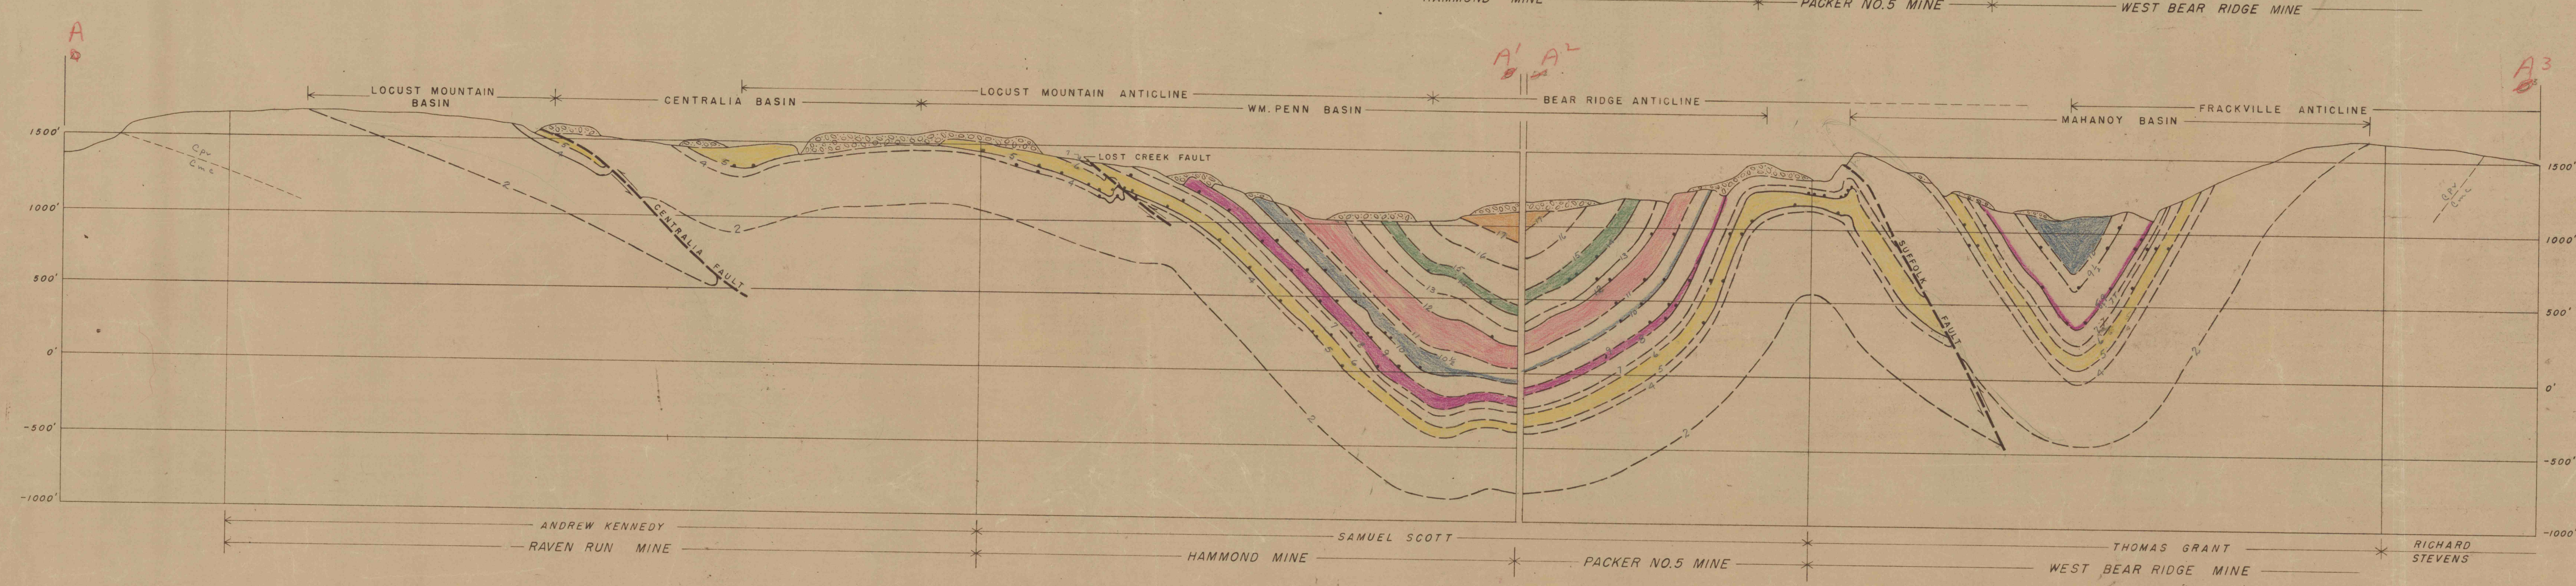
 
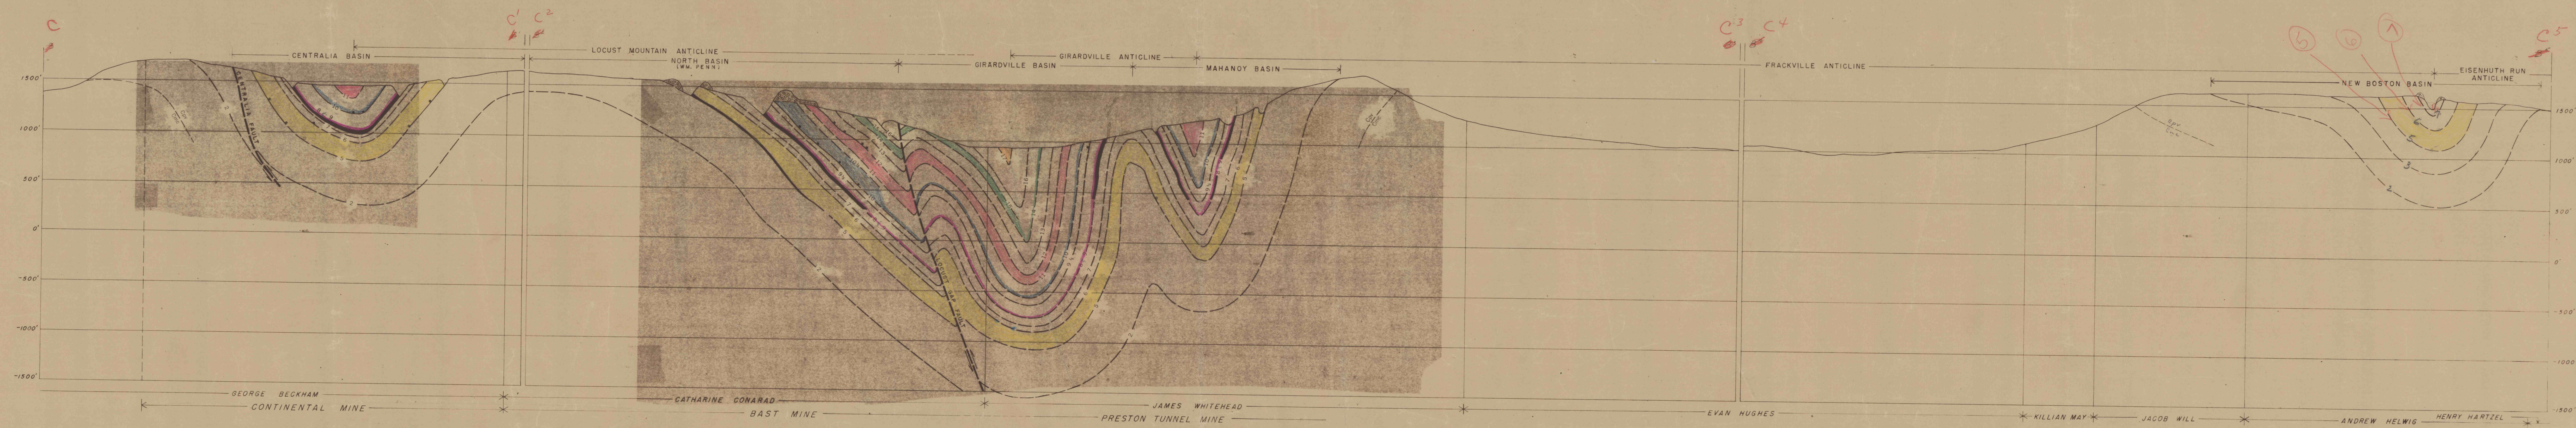


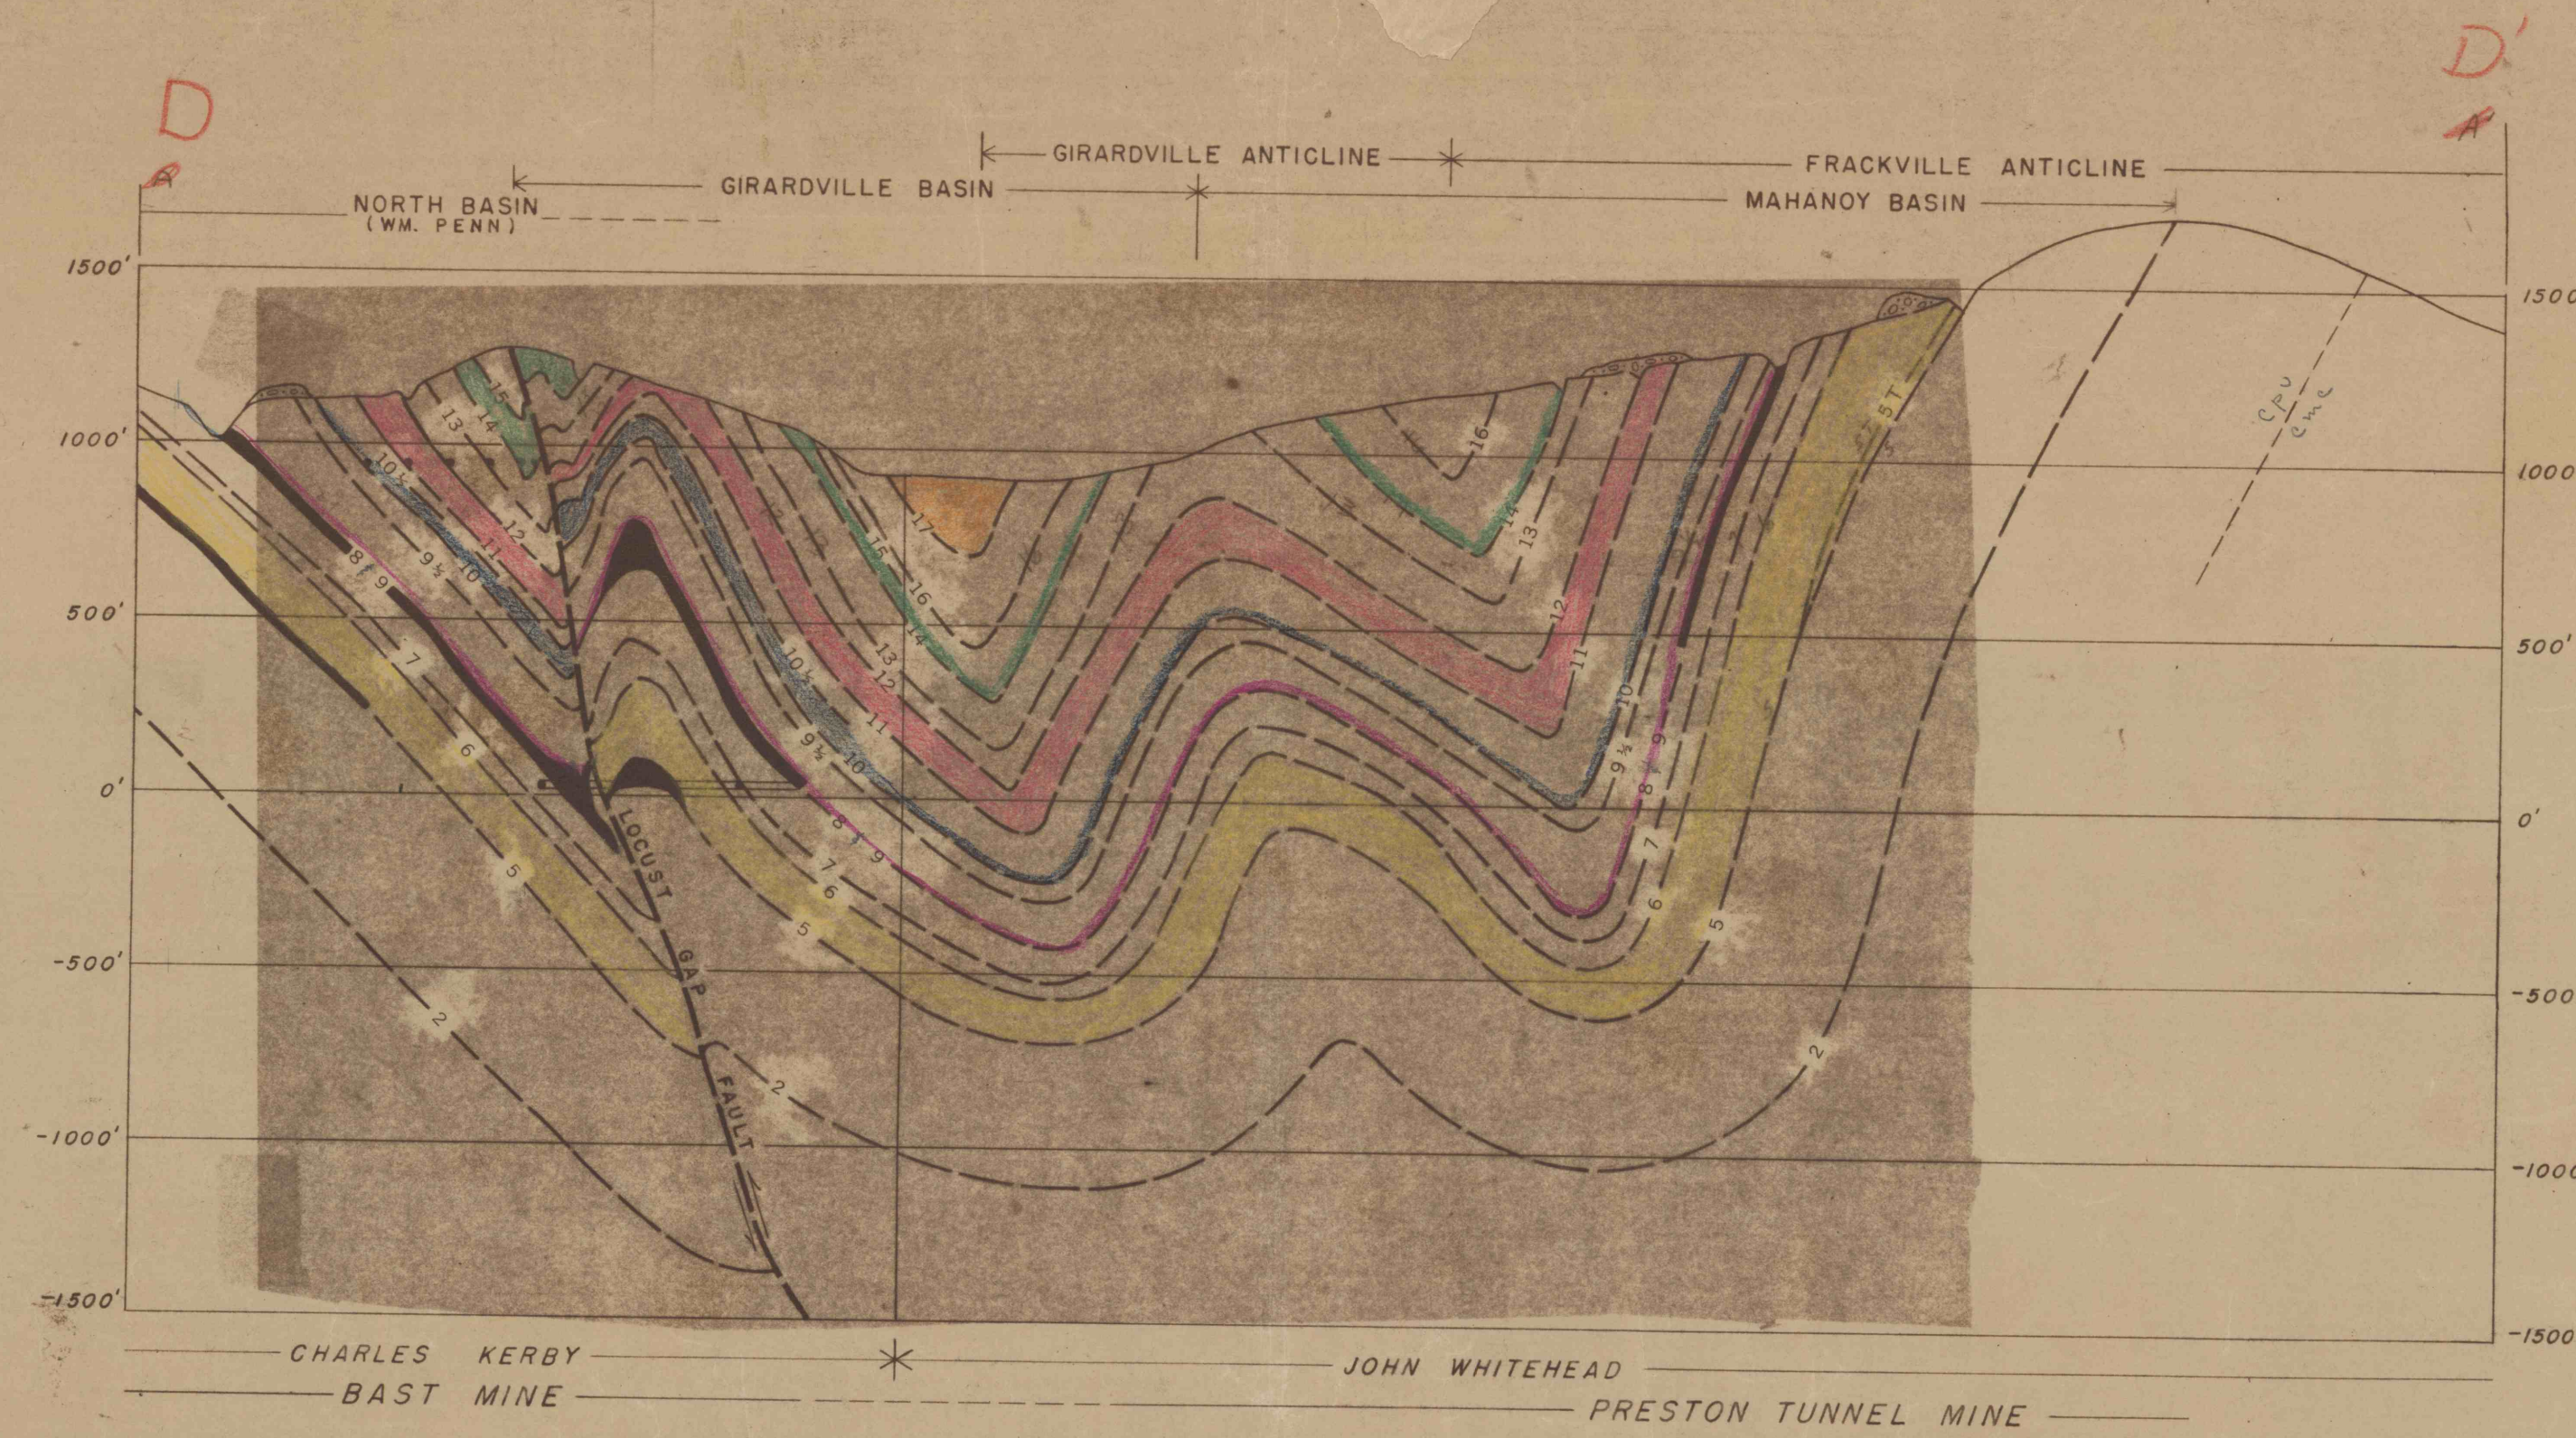

Adkins E.