


SHEET NO. 11 1903
NEW AND LATEST EDITION

STANTON

GLEN ALDEN COAL CO.
LANCE COLLIERY

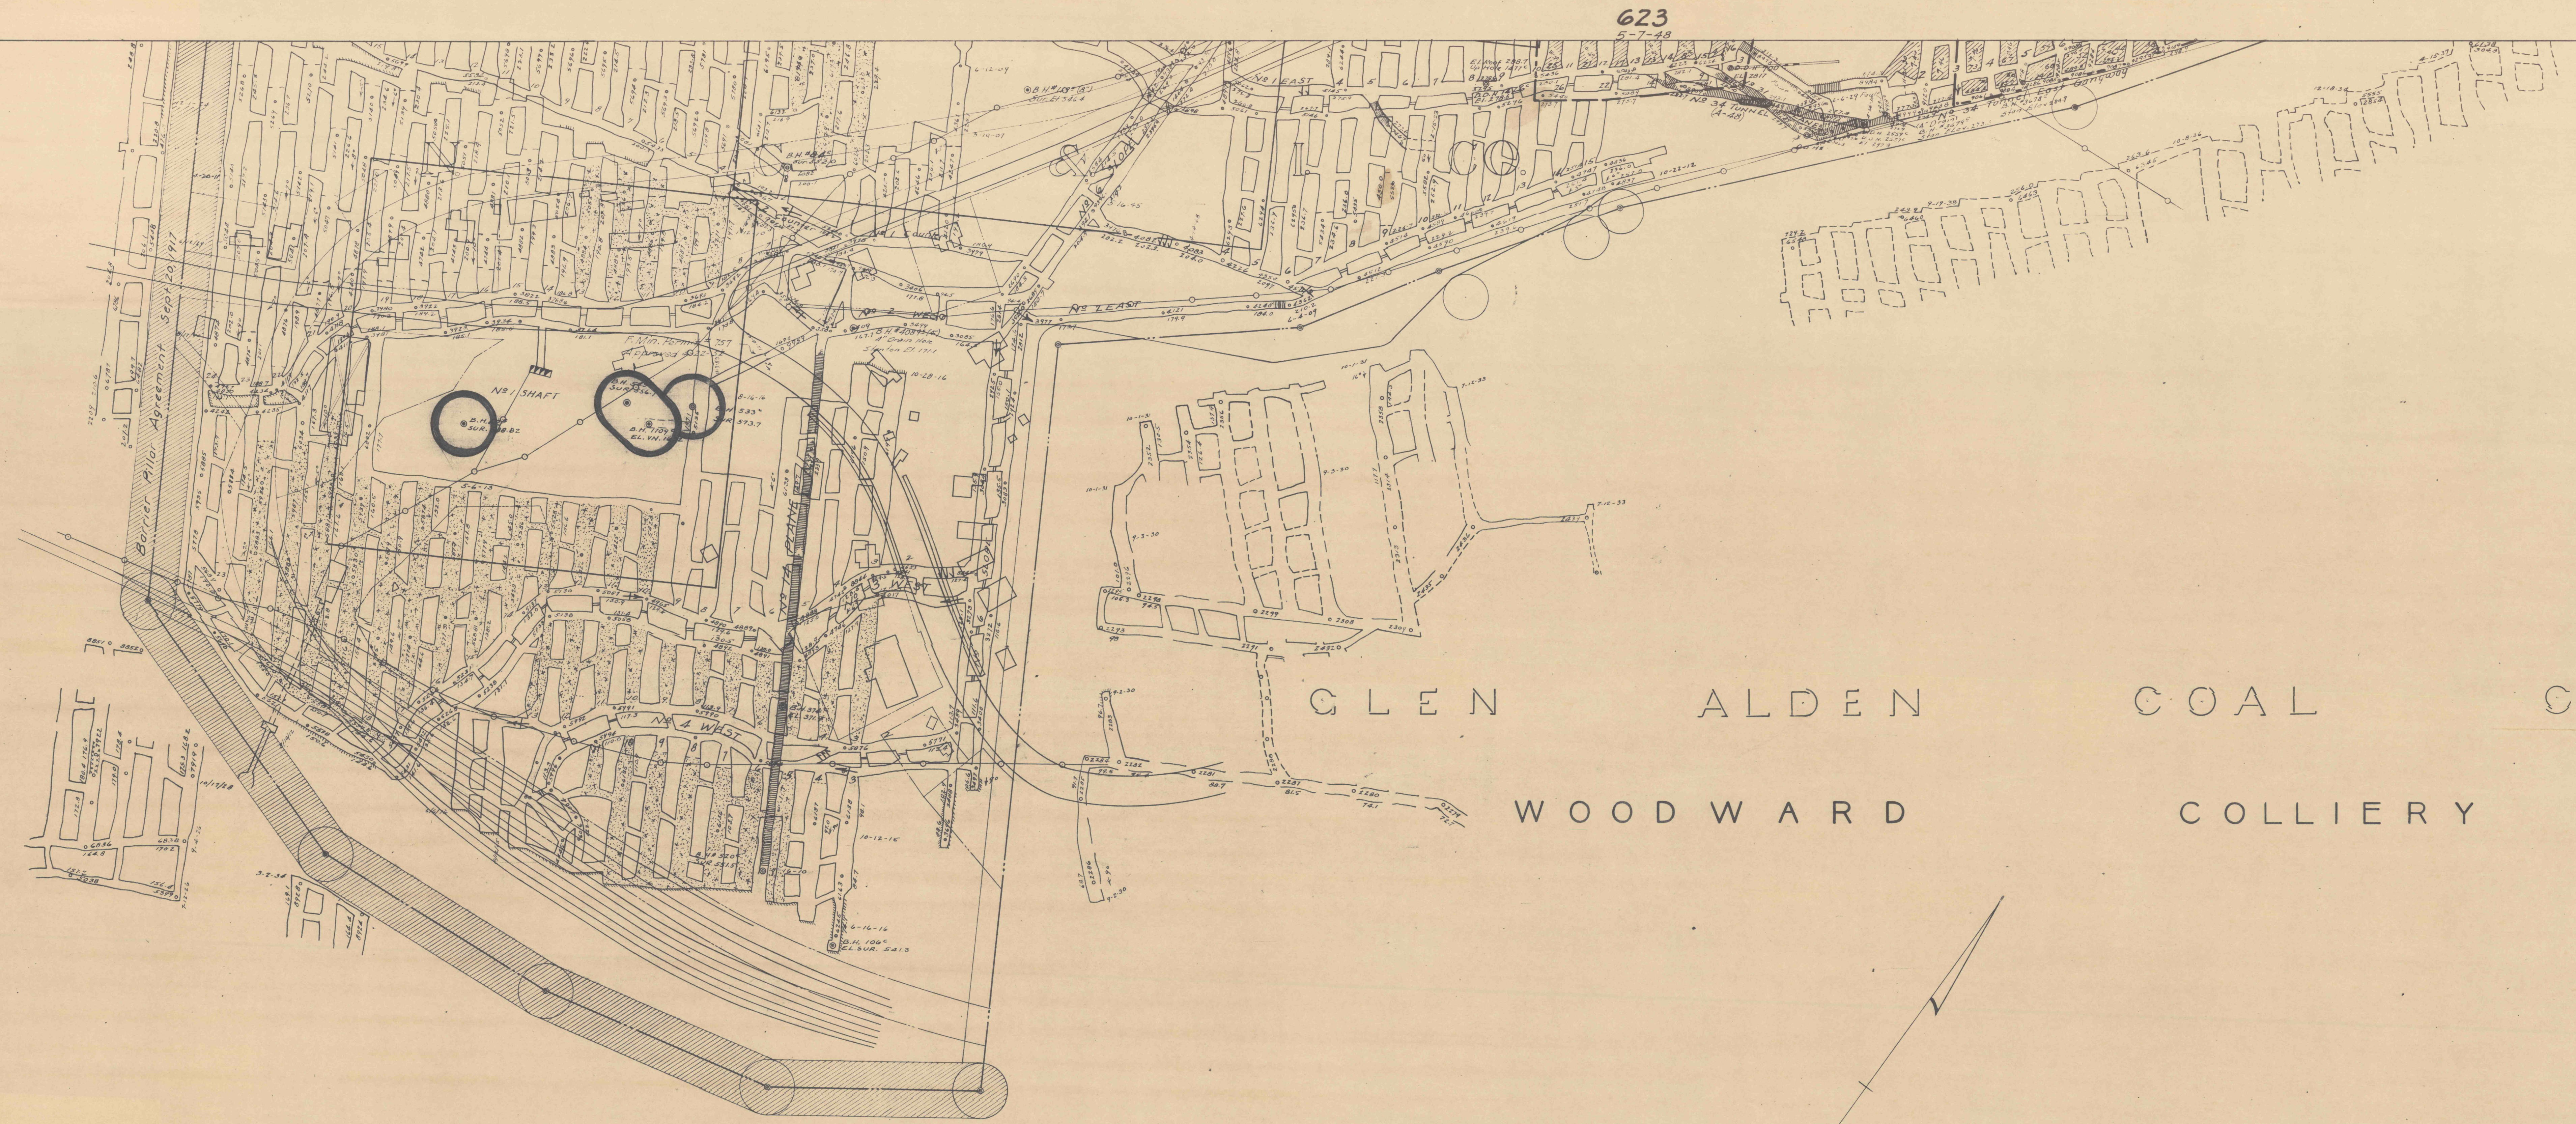

623
5-7-48

GLEN ALDEN COAL CO.
WOODWARD COLLIERY

