


DATE OF LAST SURVEY POSTED	NO. 2 SHAFT
First	By

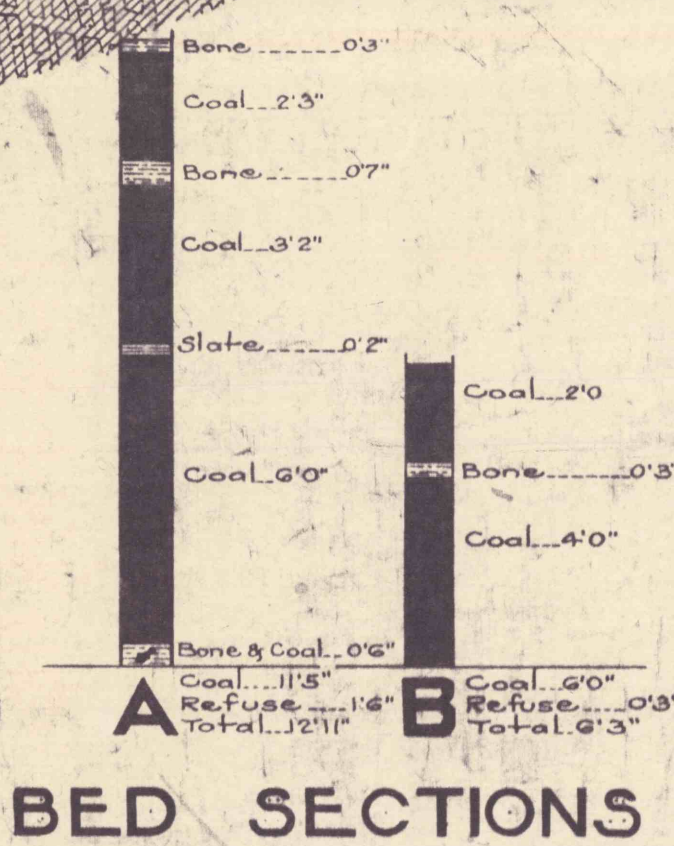

THE HUDSON COAL CO
 Map Showing The
ABBOTT BED
 AT LOREE COLLY
 Scale 1"=400'
 Office of The
 Forecast Dept.
 April 2, 1927