


OFFICE OF CONSTRUCTION MINING ENGINEER
THE HOBBS COAL CO.
DESCRIPTION: C-M.E. SURVEY IN
COLONIAL COAL CO.'S WKS.
FORMALLY: THE W.BARRE COLLY. CO.
COLONIAL COAL CO.
COLLIERY: MADEIRA HILL, VEH. "A."
SCALE 1"=100'. DATE 4-13-26.
COMPARTMENT: G. (S-38).

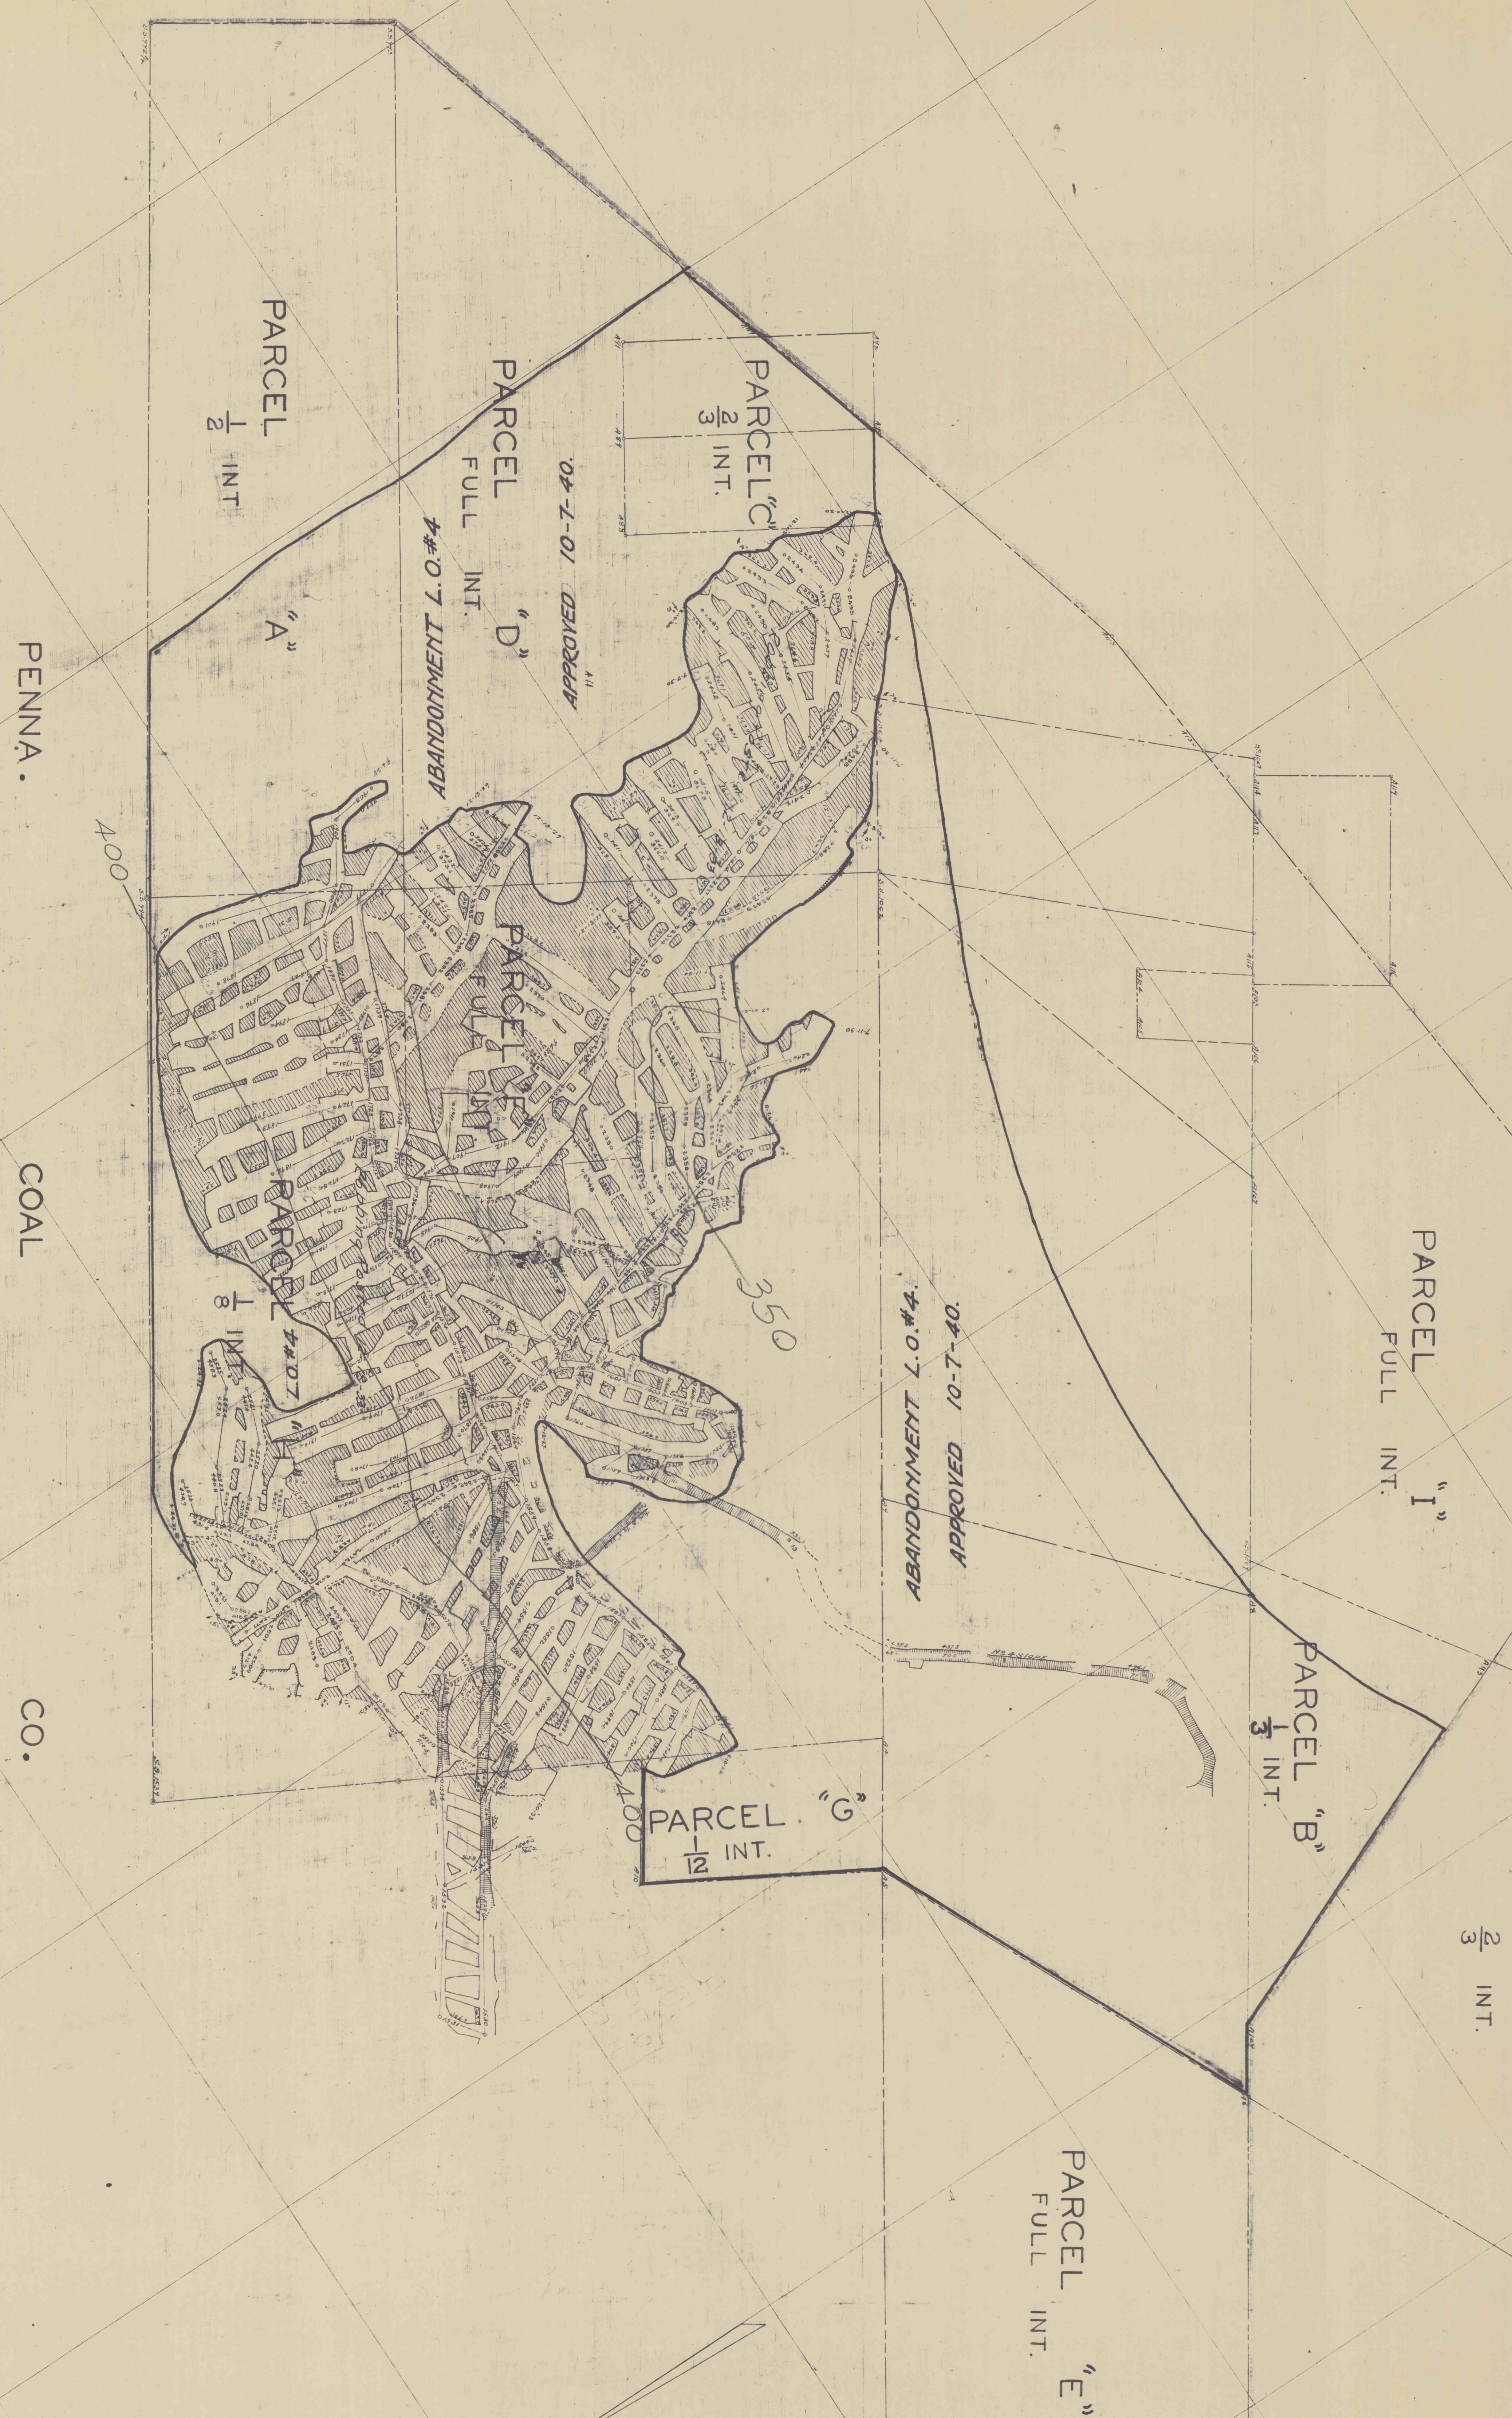

THE HUDSON COAL CO.
OFFICE OF CONSULTING MINING ENGINEER.
DESCRIPTIONS:- G.M.E. SURVEY IN
COLONIAL COAL CO.'S WEG'S.
FORMALLY: THE W.BARRE COLLY CO.
COLONIAL COAL CO.
COLLIERY: MADERIA HILL. VEIN: 'A'.
SCALE 1"=100' DATE 9-13-26.
COMPARTMENT G. M²38.

THIS
IS
CONTOURED ON

COLLECTORY: MADERIA HILL VEIN
SCALE 1"=100' DATE 9-13-2
COMPARTMENT G. M²38-

N-451

DELAWARE
PINE RIDGE