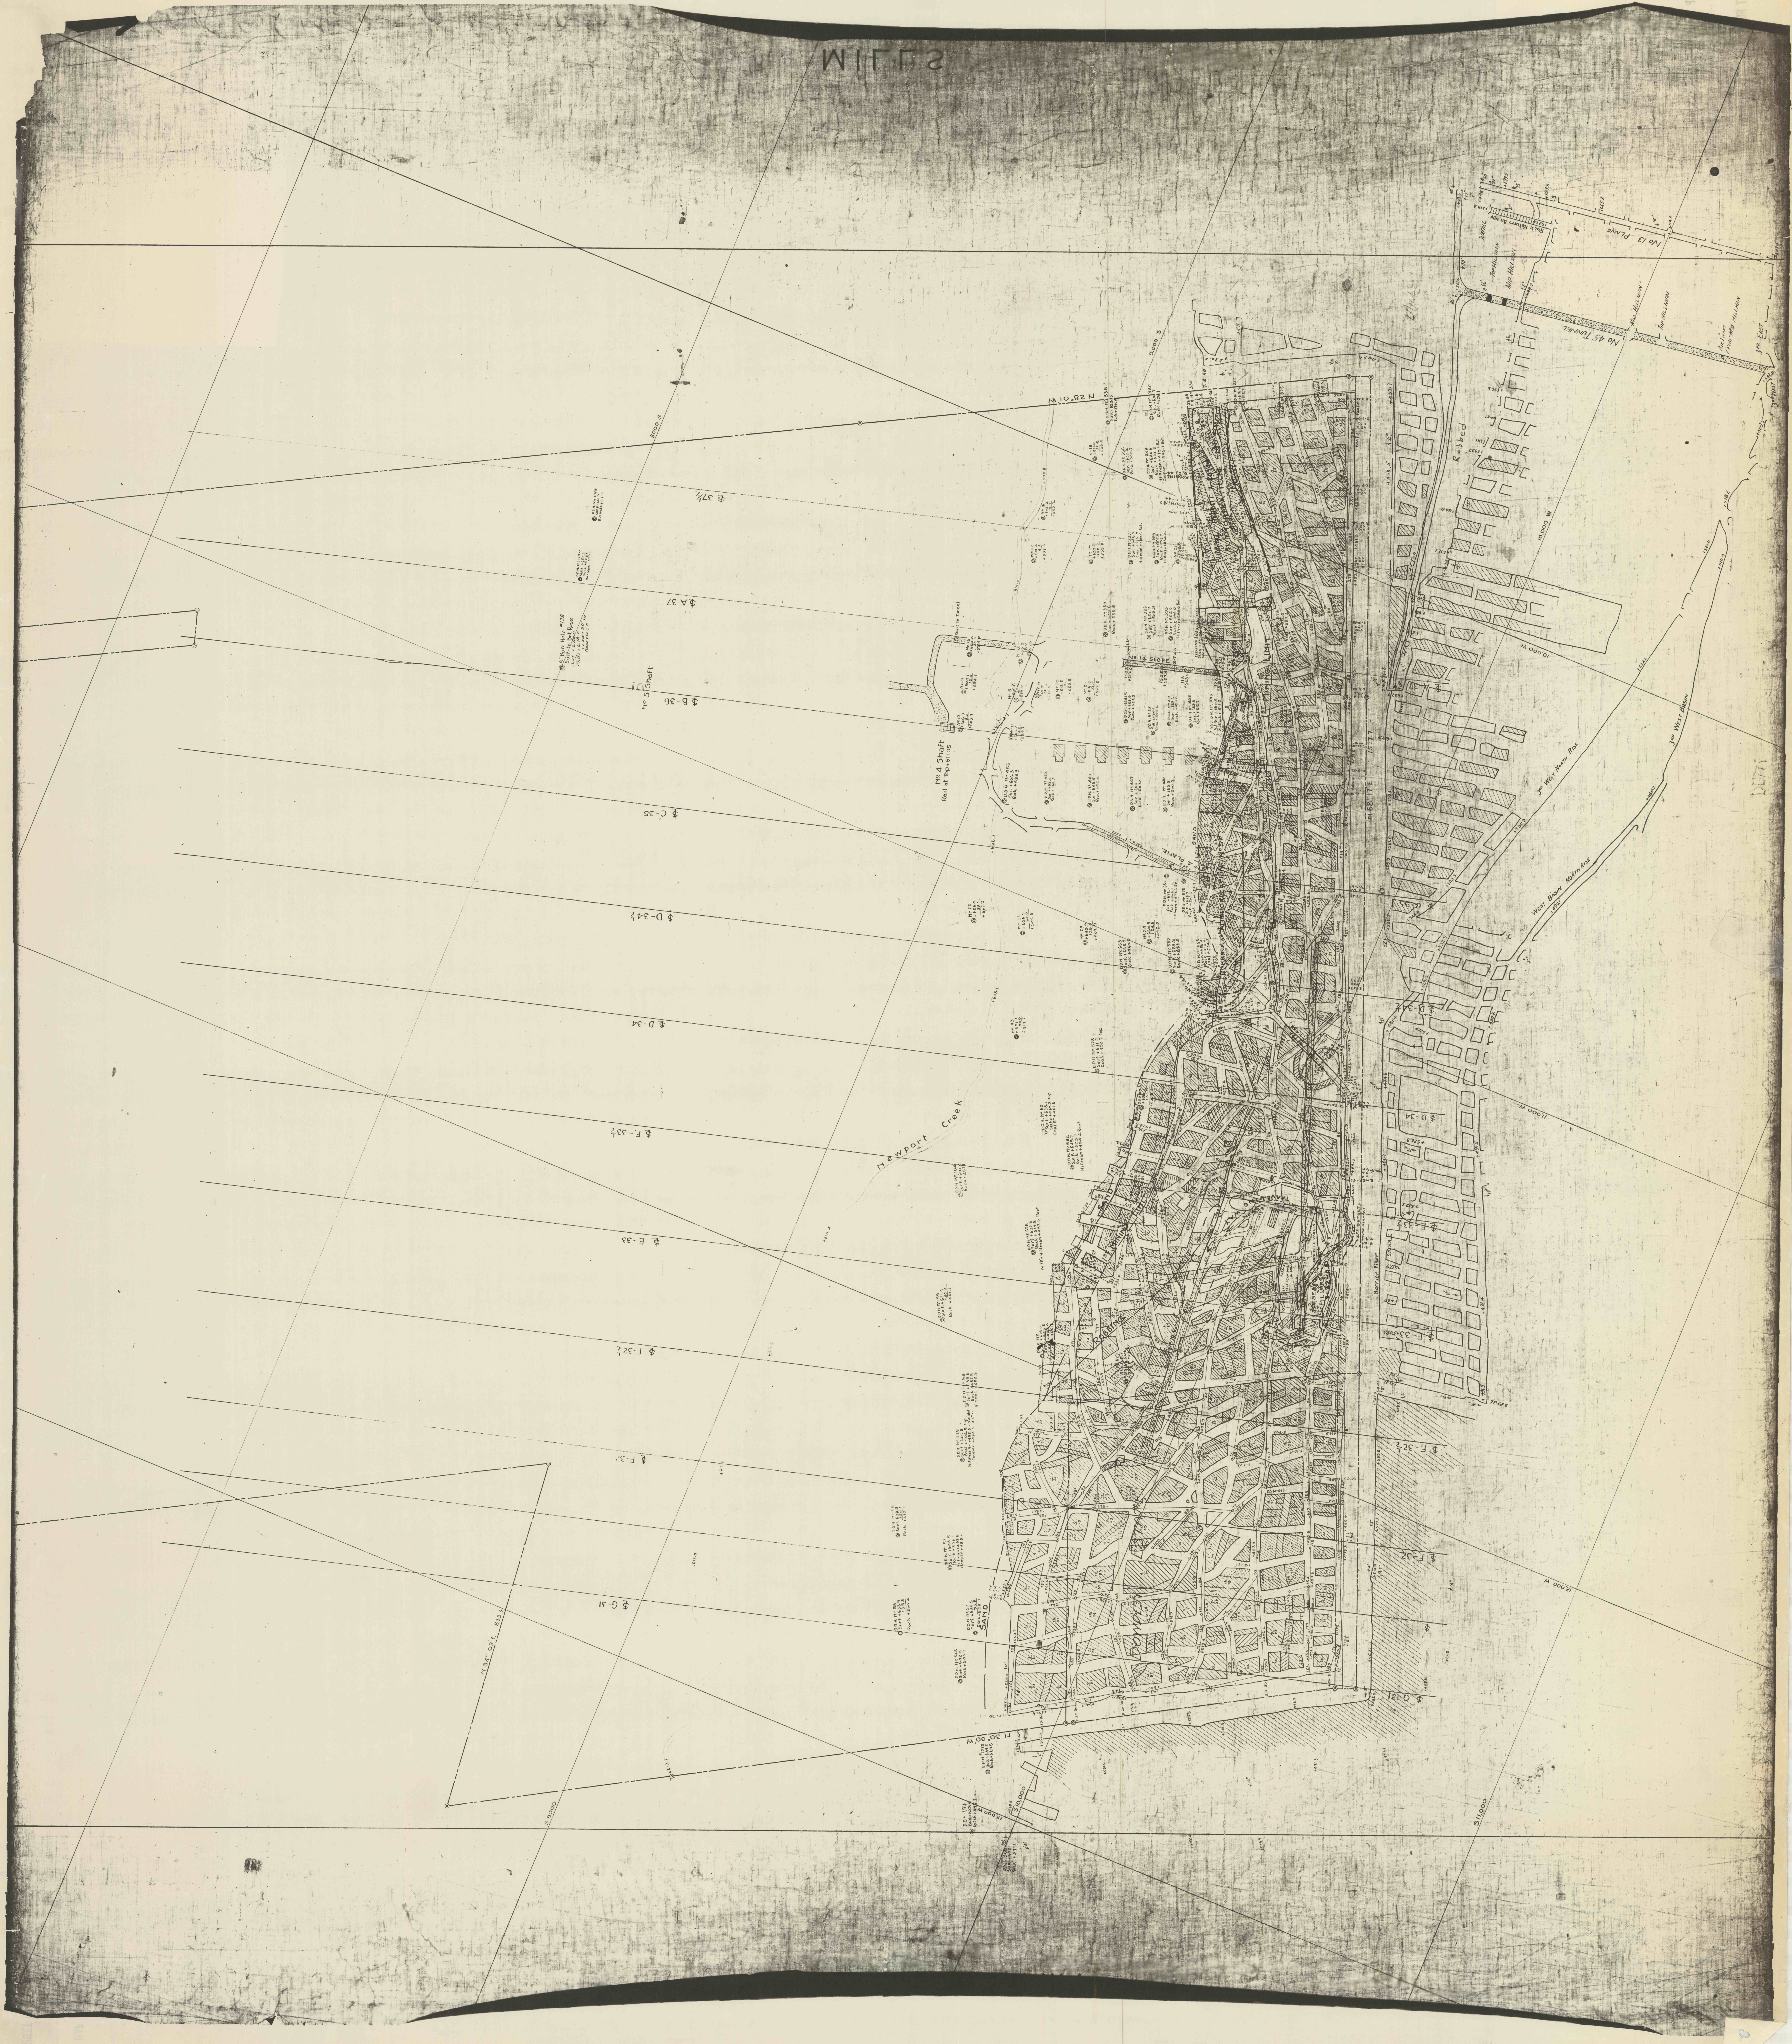
N 28°01' W
9000 S
8000 S
℄ 37½
℄ A-37
8" Bore Hole #138 Surf to Bot Ross
No 5 Shaft
℄ B-36
℄ C-35
℄ D-34½
℄ D-34
℄ E-33½
℄ E-33
℄ F-32½
℄ F-32
℄ G-31
N 84° 03' E 833.3
S 9000
S 10,000
S 11,000
N 30°00' W
10,000 W
11,000 W
12,000 W
13,000 W
Newport Creek
Shaft To Tunnel
No 4 Shaft
Rail at Top +611.95
No 14 Slope
A Plane
Sand
Mining Limit
Robbing
Barrier Pillar
Saddle
N 68°17' E
No 13 Plane
Rock Return Airway
Surface
Top Hillman
Mid Hillman
No 45 Tunnel
Air Shaft From Mid Hillman
3rd East
3rd West
Robbed
3rd West Basin
3rd West North Rise
West Basin North Rise
DDH No 56 Surf +638.9 Rock +500.4
DDH No 57 Surf +642.5 Rock +528.7
DDH No 548 Surf +642.0 Rock +545.9
DDH No 1578 Surf +649.5 Rock +589.6
DDH No 59 Surf +621.4 Rock +481.1
DDH No 58 Surf +633.6 Rock +486.6
DDH No 104 Surf +610.4 Rock +461.1
DDH No 582 Surf +630.7 Hillman +484.4 Roof
DDH No 578 Surf +621.2 Coal +492.7 Top
DDH No 415 Surf +651.9 Rock +521.3
No 43
No 23
No 24
No 22
No 26
No 20
No 15
No 16
No 17
No 18
No 19