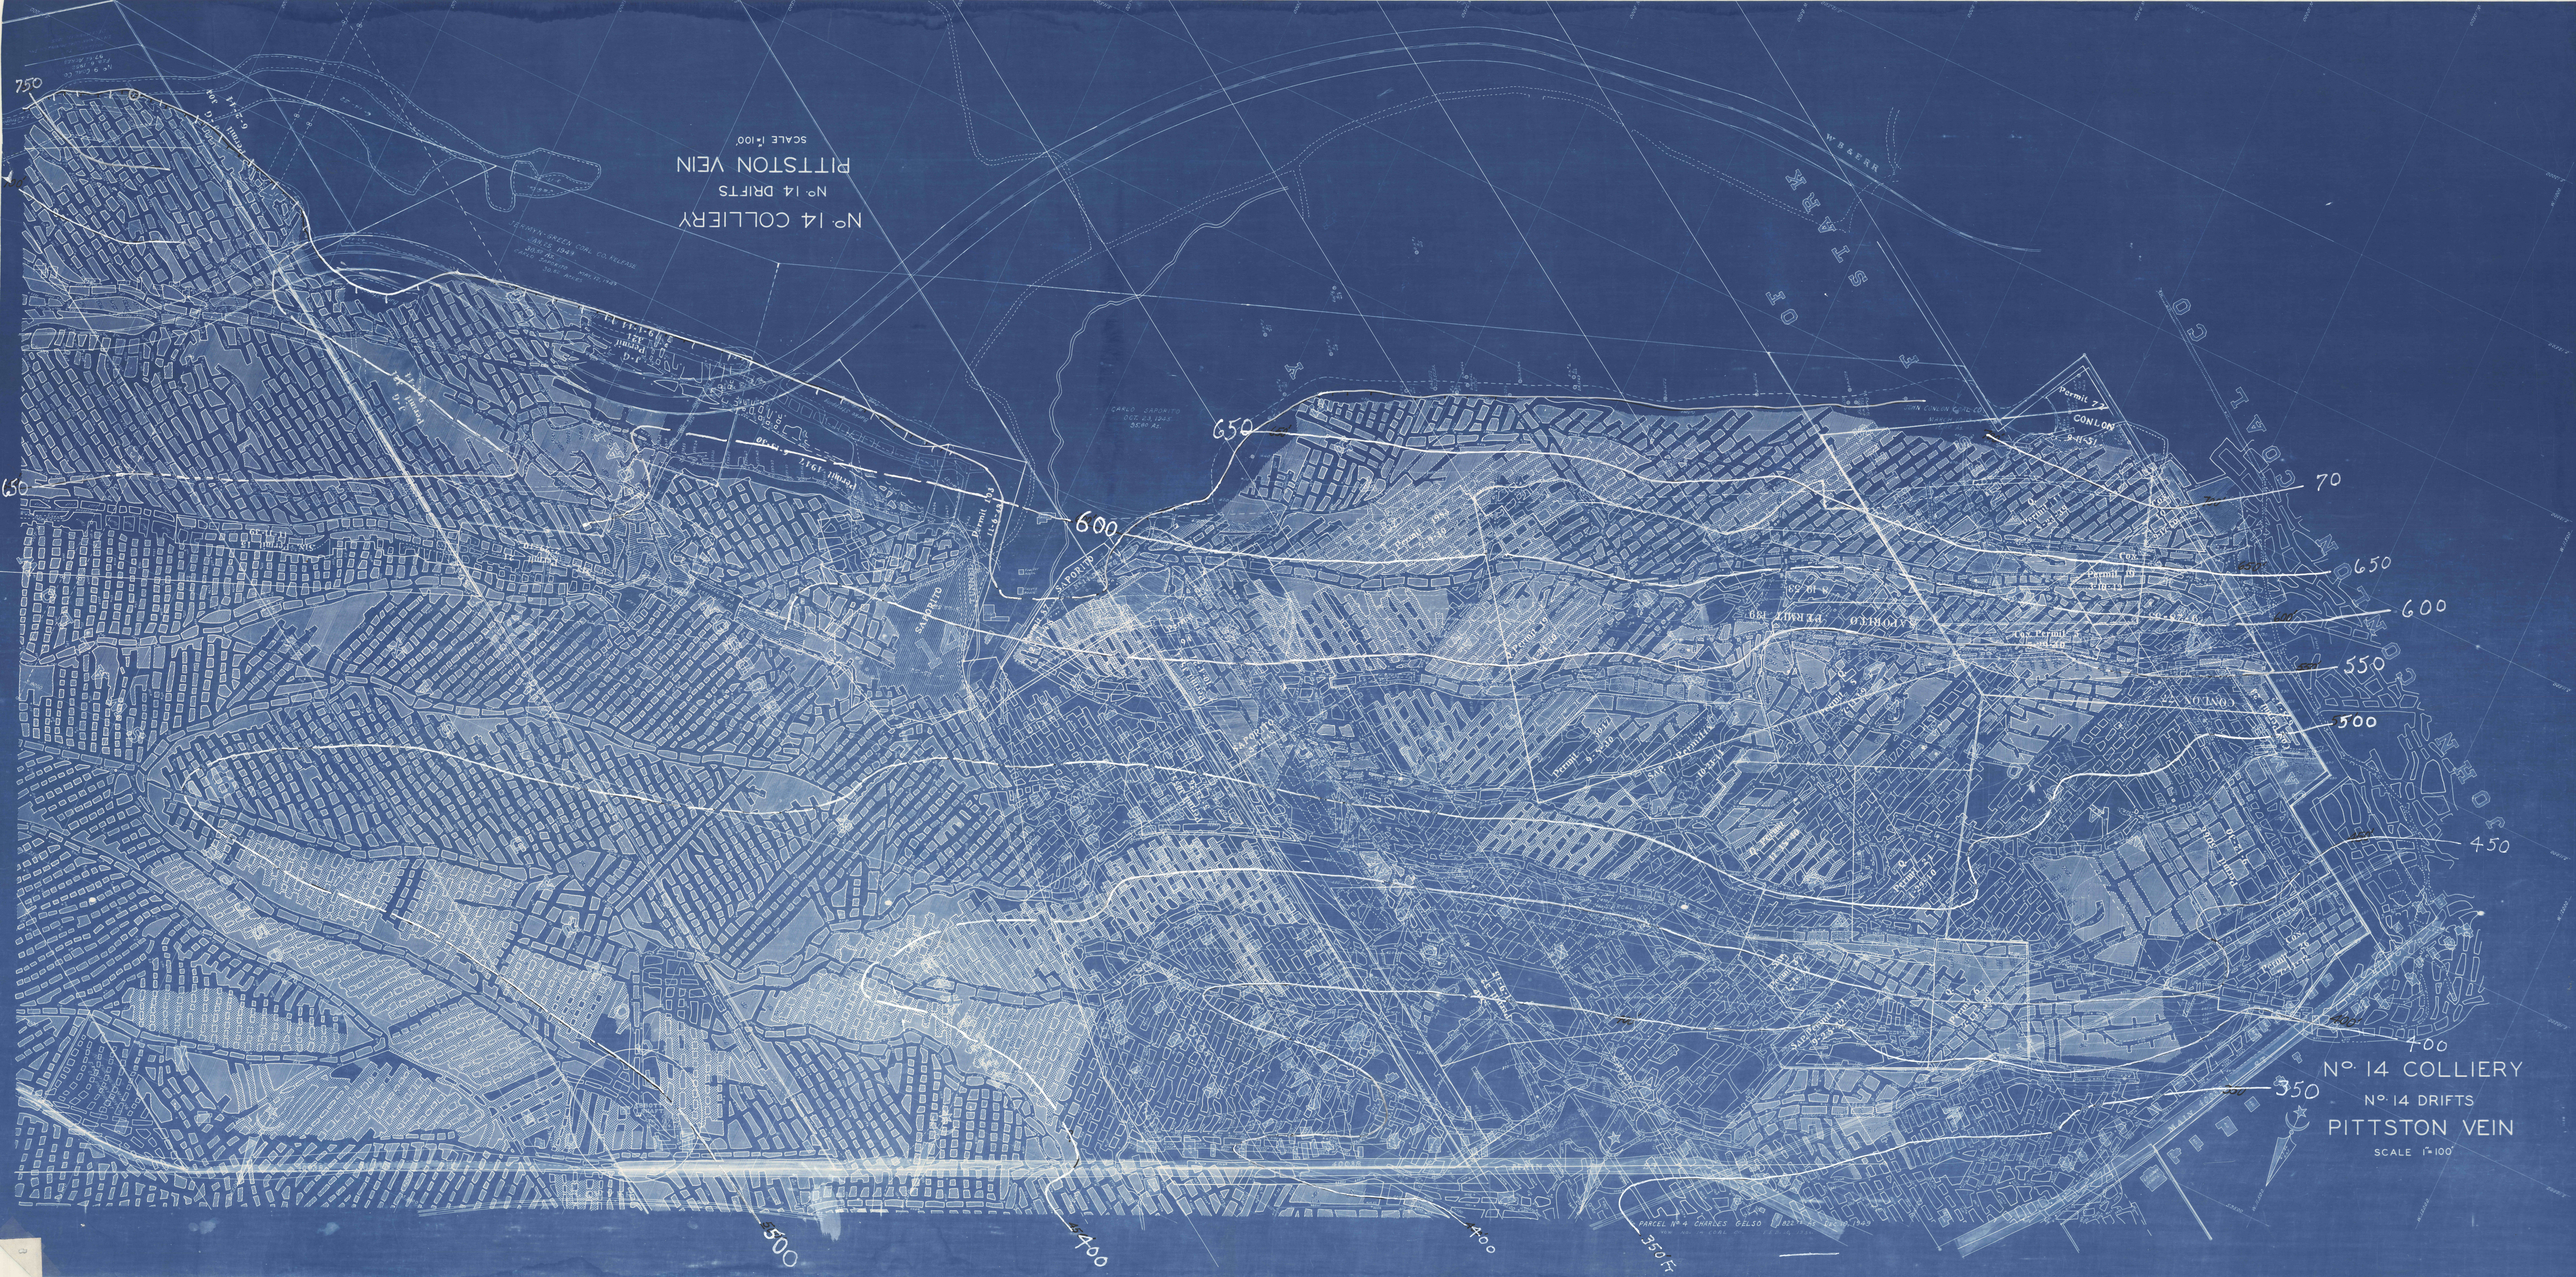

No. 14 COLLIERY

No. 14 DRIFTS

PITTSTON VEIN

SCALE 1"=100'

350
400
450
500
550
600
650
700
70
CONLON
SAPORITO PERMIT 139
STARK
COAL CO
No. 14 COLLIERY
No. 14 DRIFTS
PITTSTON VEIN
SCALE 1"=100'