BOT. STARK VN. BUTLER COUNTY BOT. STARK VN.

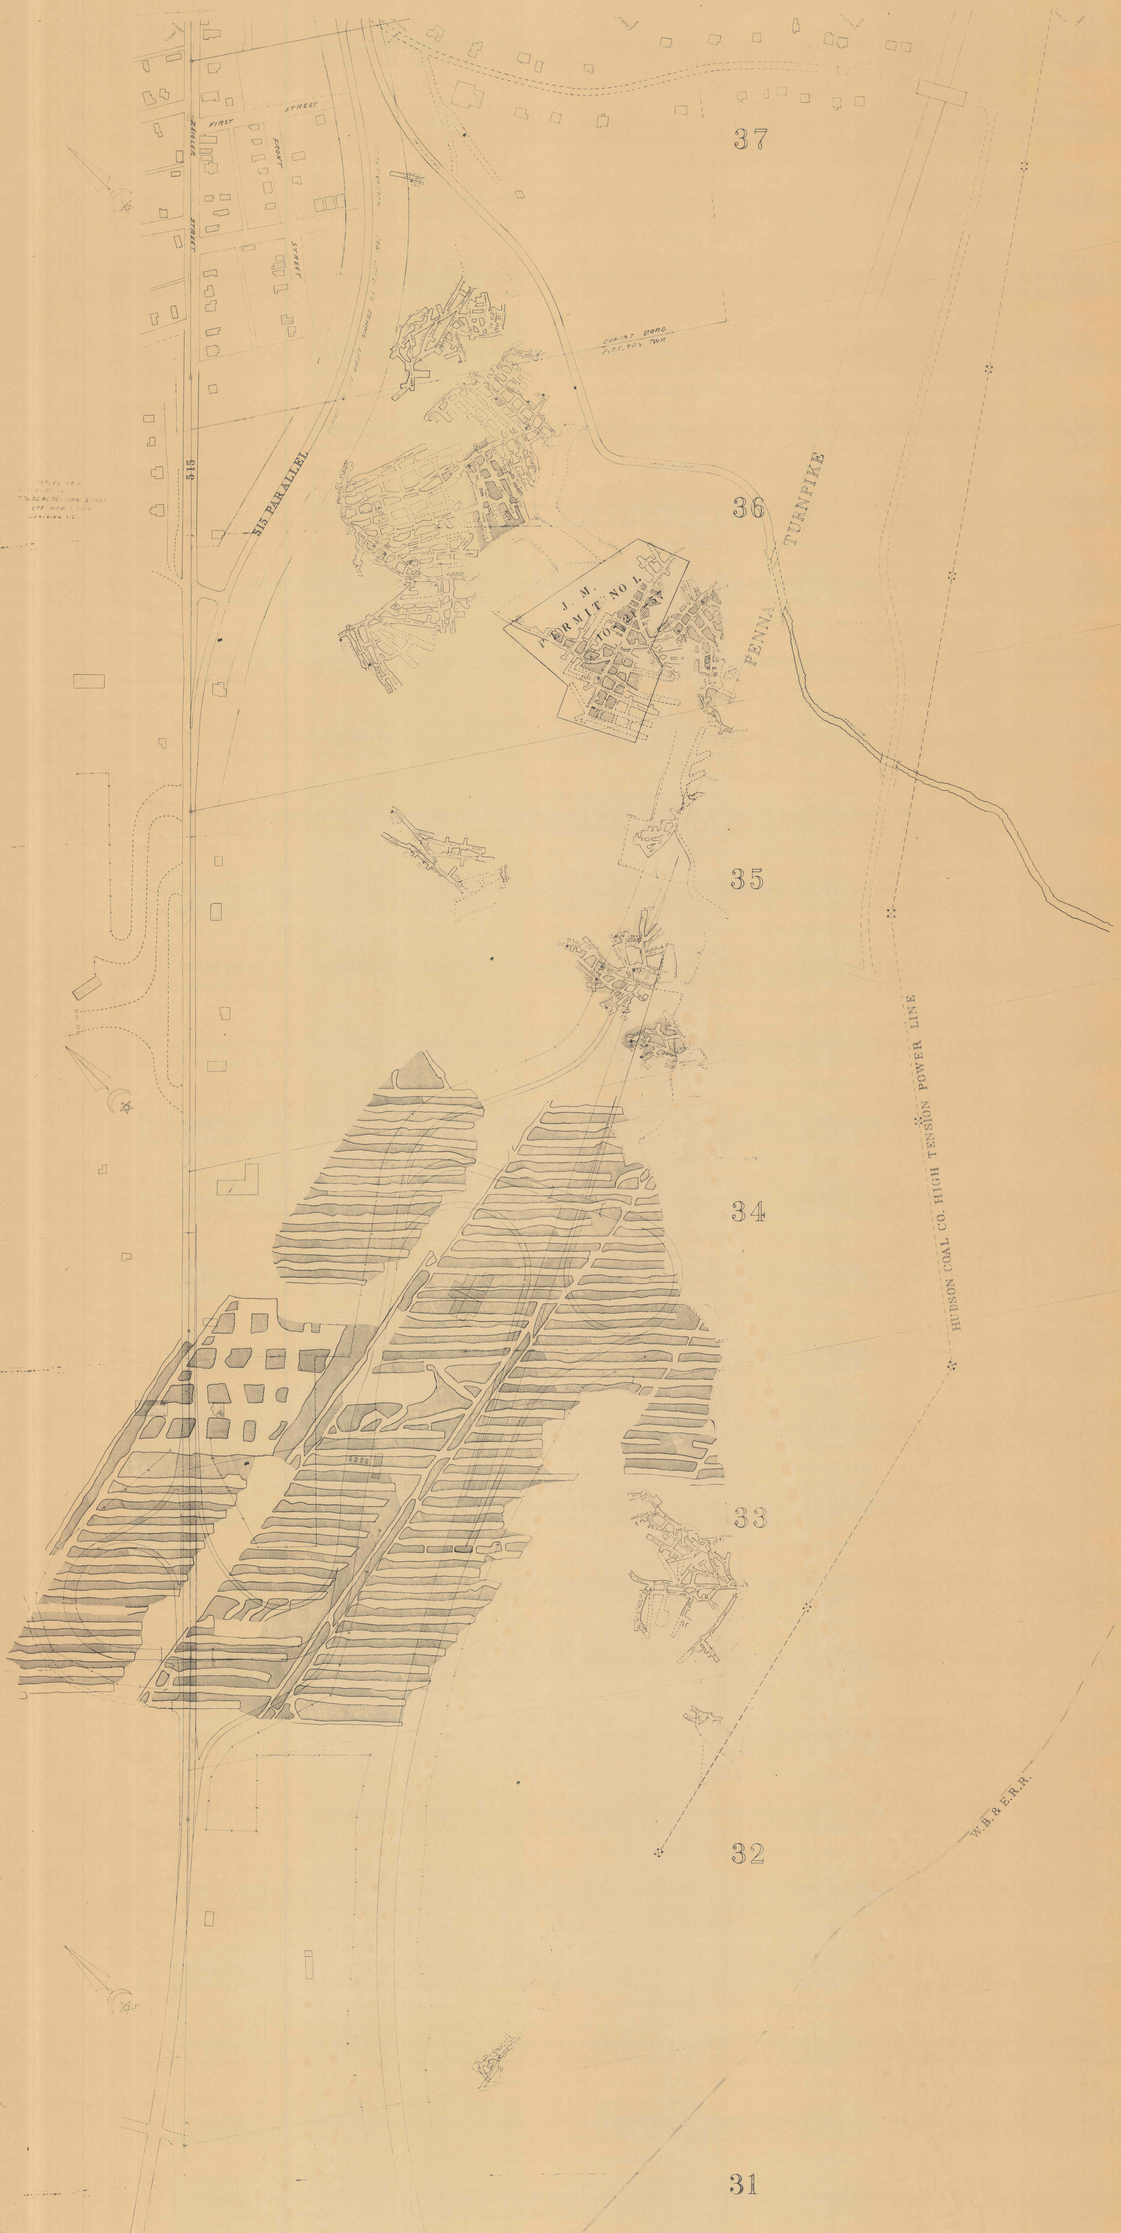

BOT. STARK VN. BUTLER COUNTY. BOT. STARK VN.