



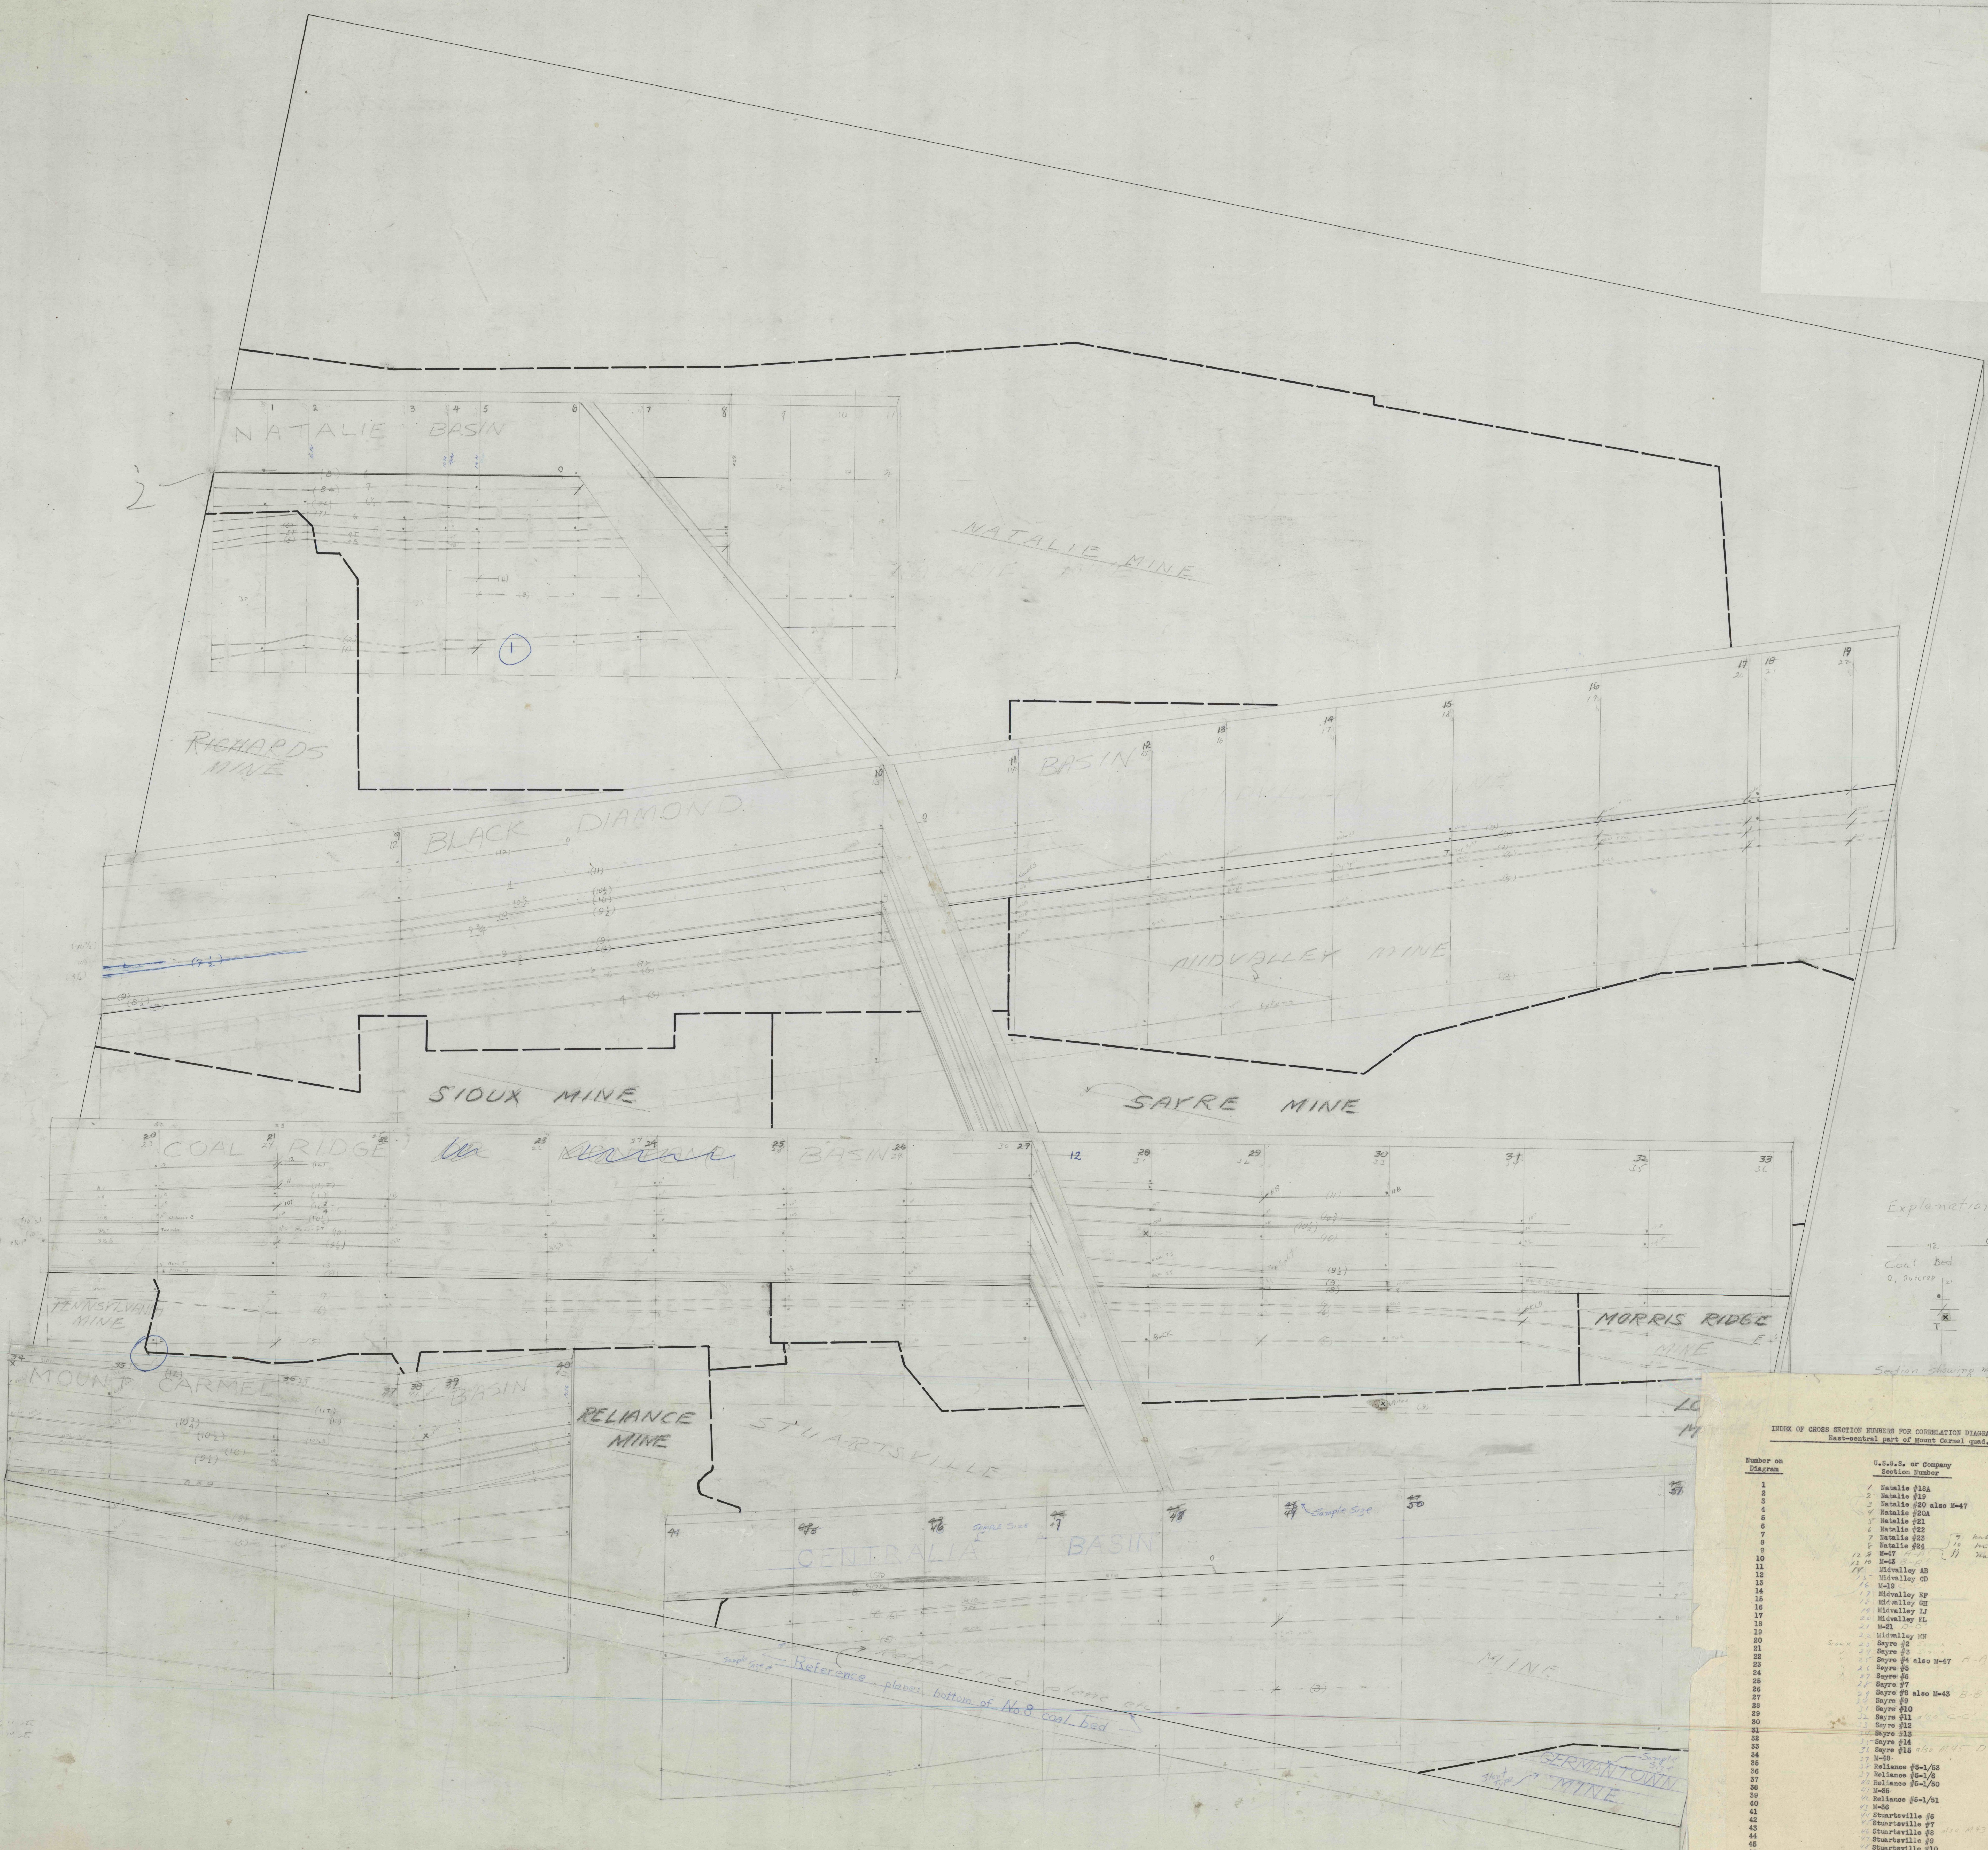

Explanation

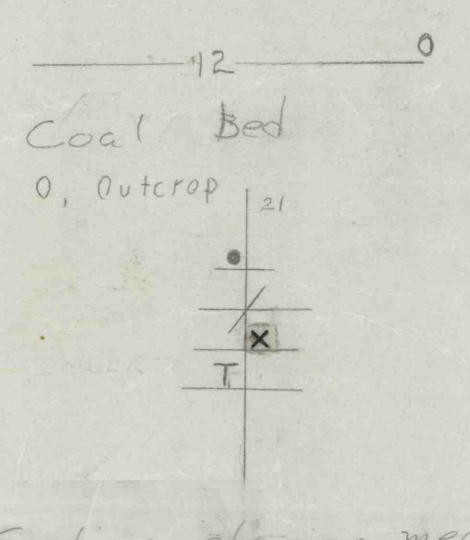

INDEX OF CROSS SECTION NUMBERS FOR CORRELATION DIAGRAM.

Number on Diagram	U.S.G.S. or Company Section Number
1	Natalie #12a
2	Natalie #19
3	Natalie #20 also M-47
4	Natalie #20a
5	Natalie #21
6	Natalie #22
7	Natalie #23
8	Natalie #24
9	M-47
10	M-48
11	Midway AB
12	Midway CD
13	Midway
14	Midway SP
15	Midway SE
16	Midway L2
17	Midway L1
18	Midway
19	Midway
20	Midway
21	Sayre #2
22	Sayre #3
23	Sayre #4 also M-47 A-A'
24	Sayre #5
25	Sayre #6
26	Sayre #7
27	Sayre #8 also M-45 B-B'
28	Sayre #9
29	Sayre #10
30	Sayre #11
31	Sayre #12
32	Sayre #13
33	Sayre #14
34	Sayre #15
35	M-48
36	Reliance #6-1/33
37	Reliance #6-1/34
38	Reliance #6-1/35
39	Reliance #6-1/36
40	Reliance #6-1/37
41	M-48
42	Stuartville #6
43	Stuartville #7
44	Stuartville #8 also M-45
45	Stuartville #9
46	Stuartville #10
47	Stuartville #11
48	Stuartville #12
49	Logan #1

Eliminate thickness of reference plane
adjusting dashed line accordingly.
Most mine names parallel to base of platform.
Change all mine names to match.

985 4/11
101 4/11

Mt. Carmel E.C. 101 4/11