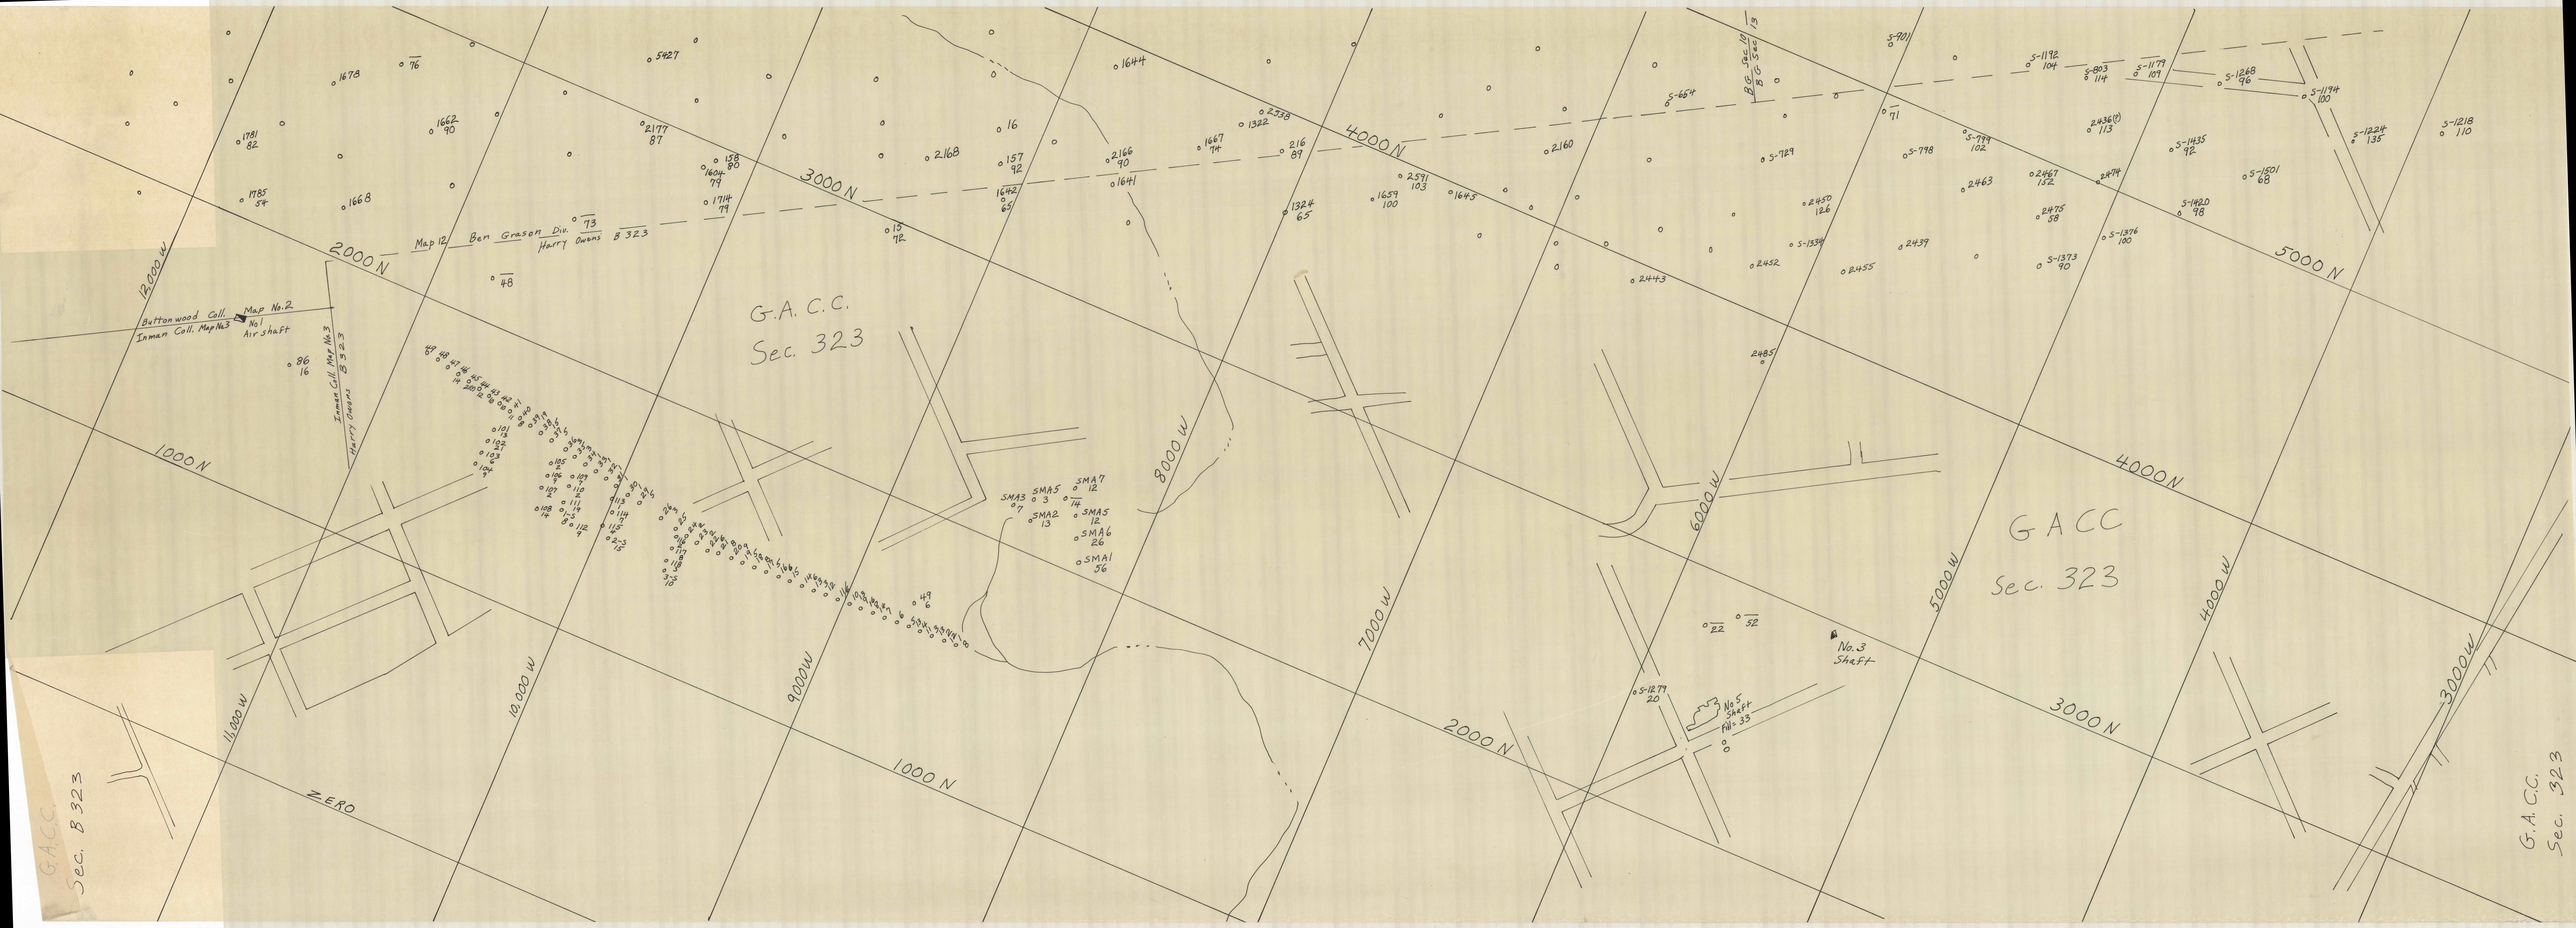
G.A.C.C.
Sec. 323
GACC
Sec. 323
G.A.C.C.
Sec. 323
GACC
Sec. B 323
Map 12 Ben Grason Div.
Harry Owens B 323
Buttonwood Coll
Inman Coll. Map No.3
Map No. 2
No. 1 Air Shaft
Inman Coll. Map No.3
Harry Owens
B 323
No. 3 Shaft
No. 5 Shaft
Fall 33
ZERO
1000 N
2000 N
3000 N
4000 N
5000 N
12,000 W
11,000 W
10,000 W
9000 W
8000 W
7000 W
6000 W
5000 W
4000 W
3000 W