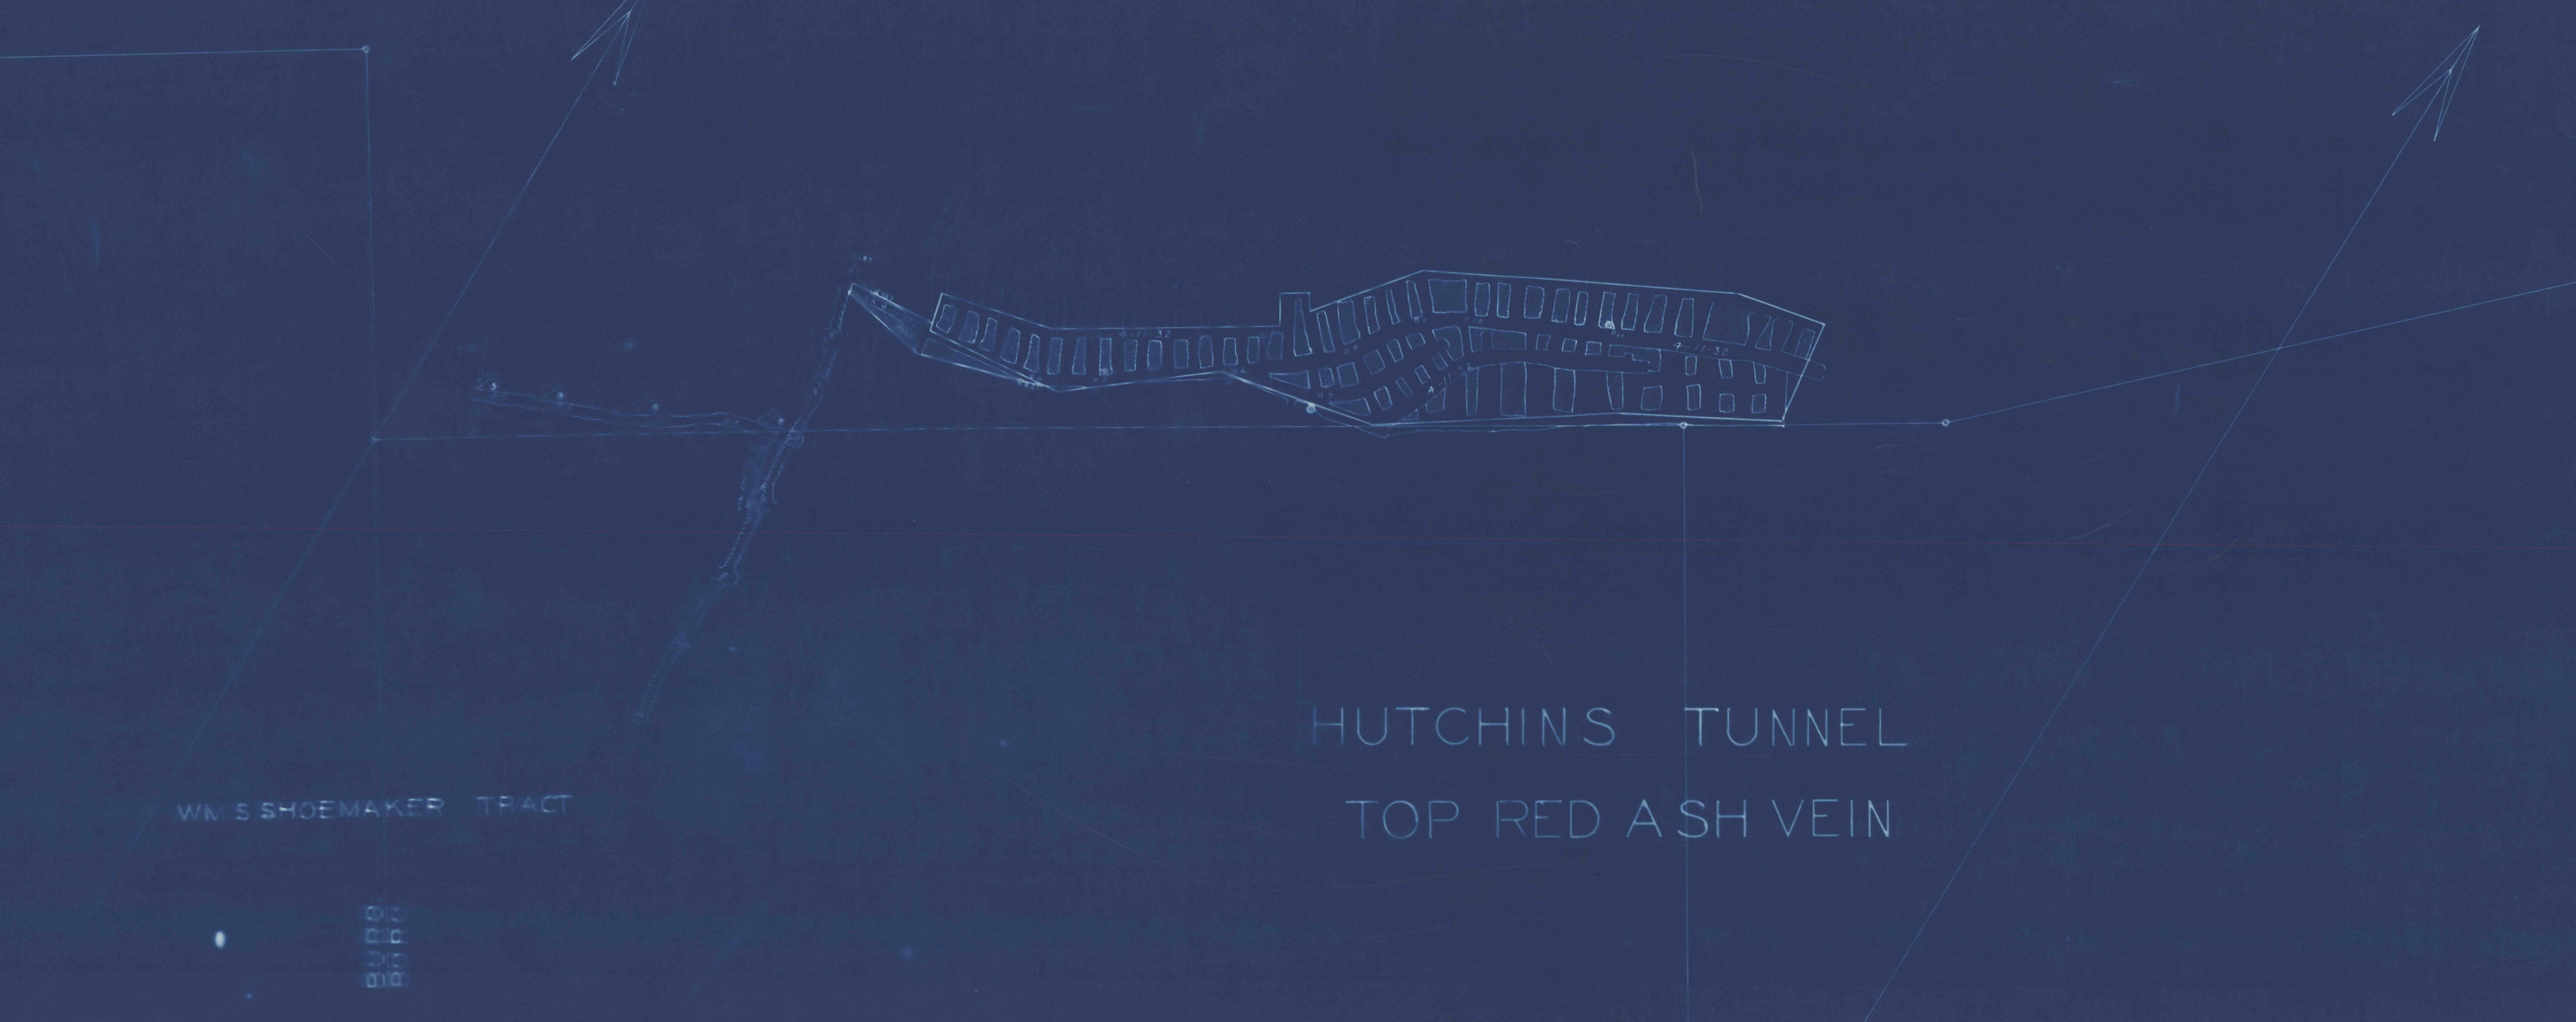
HUTCHINS TUNNEL
TOP RED ASH VEIN
WM S SHOEMAKER TRACT