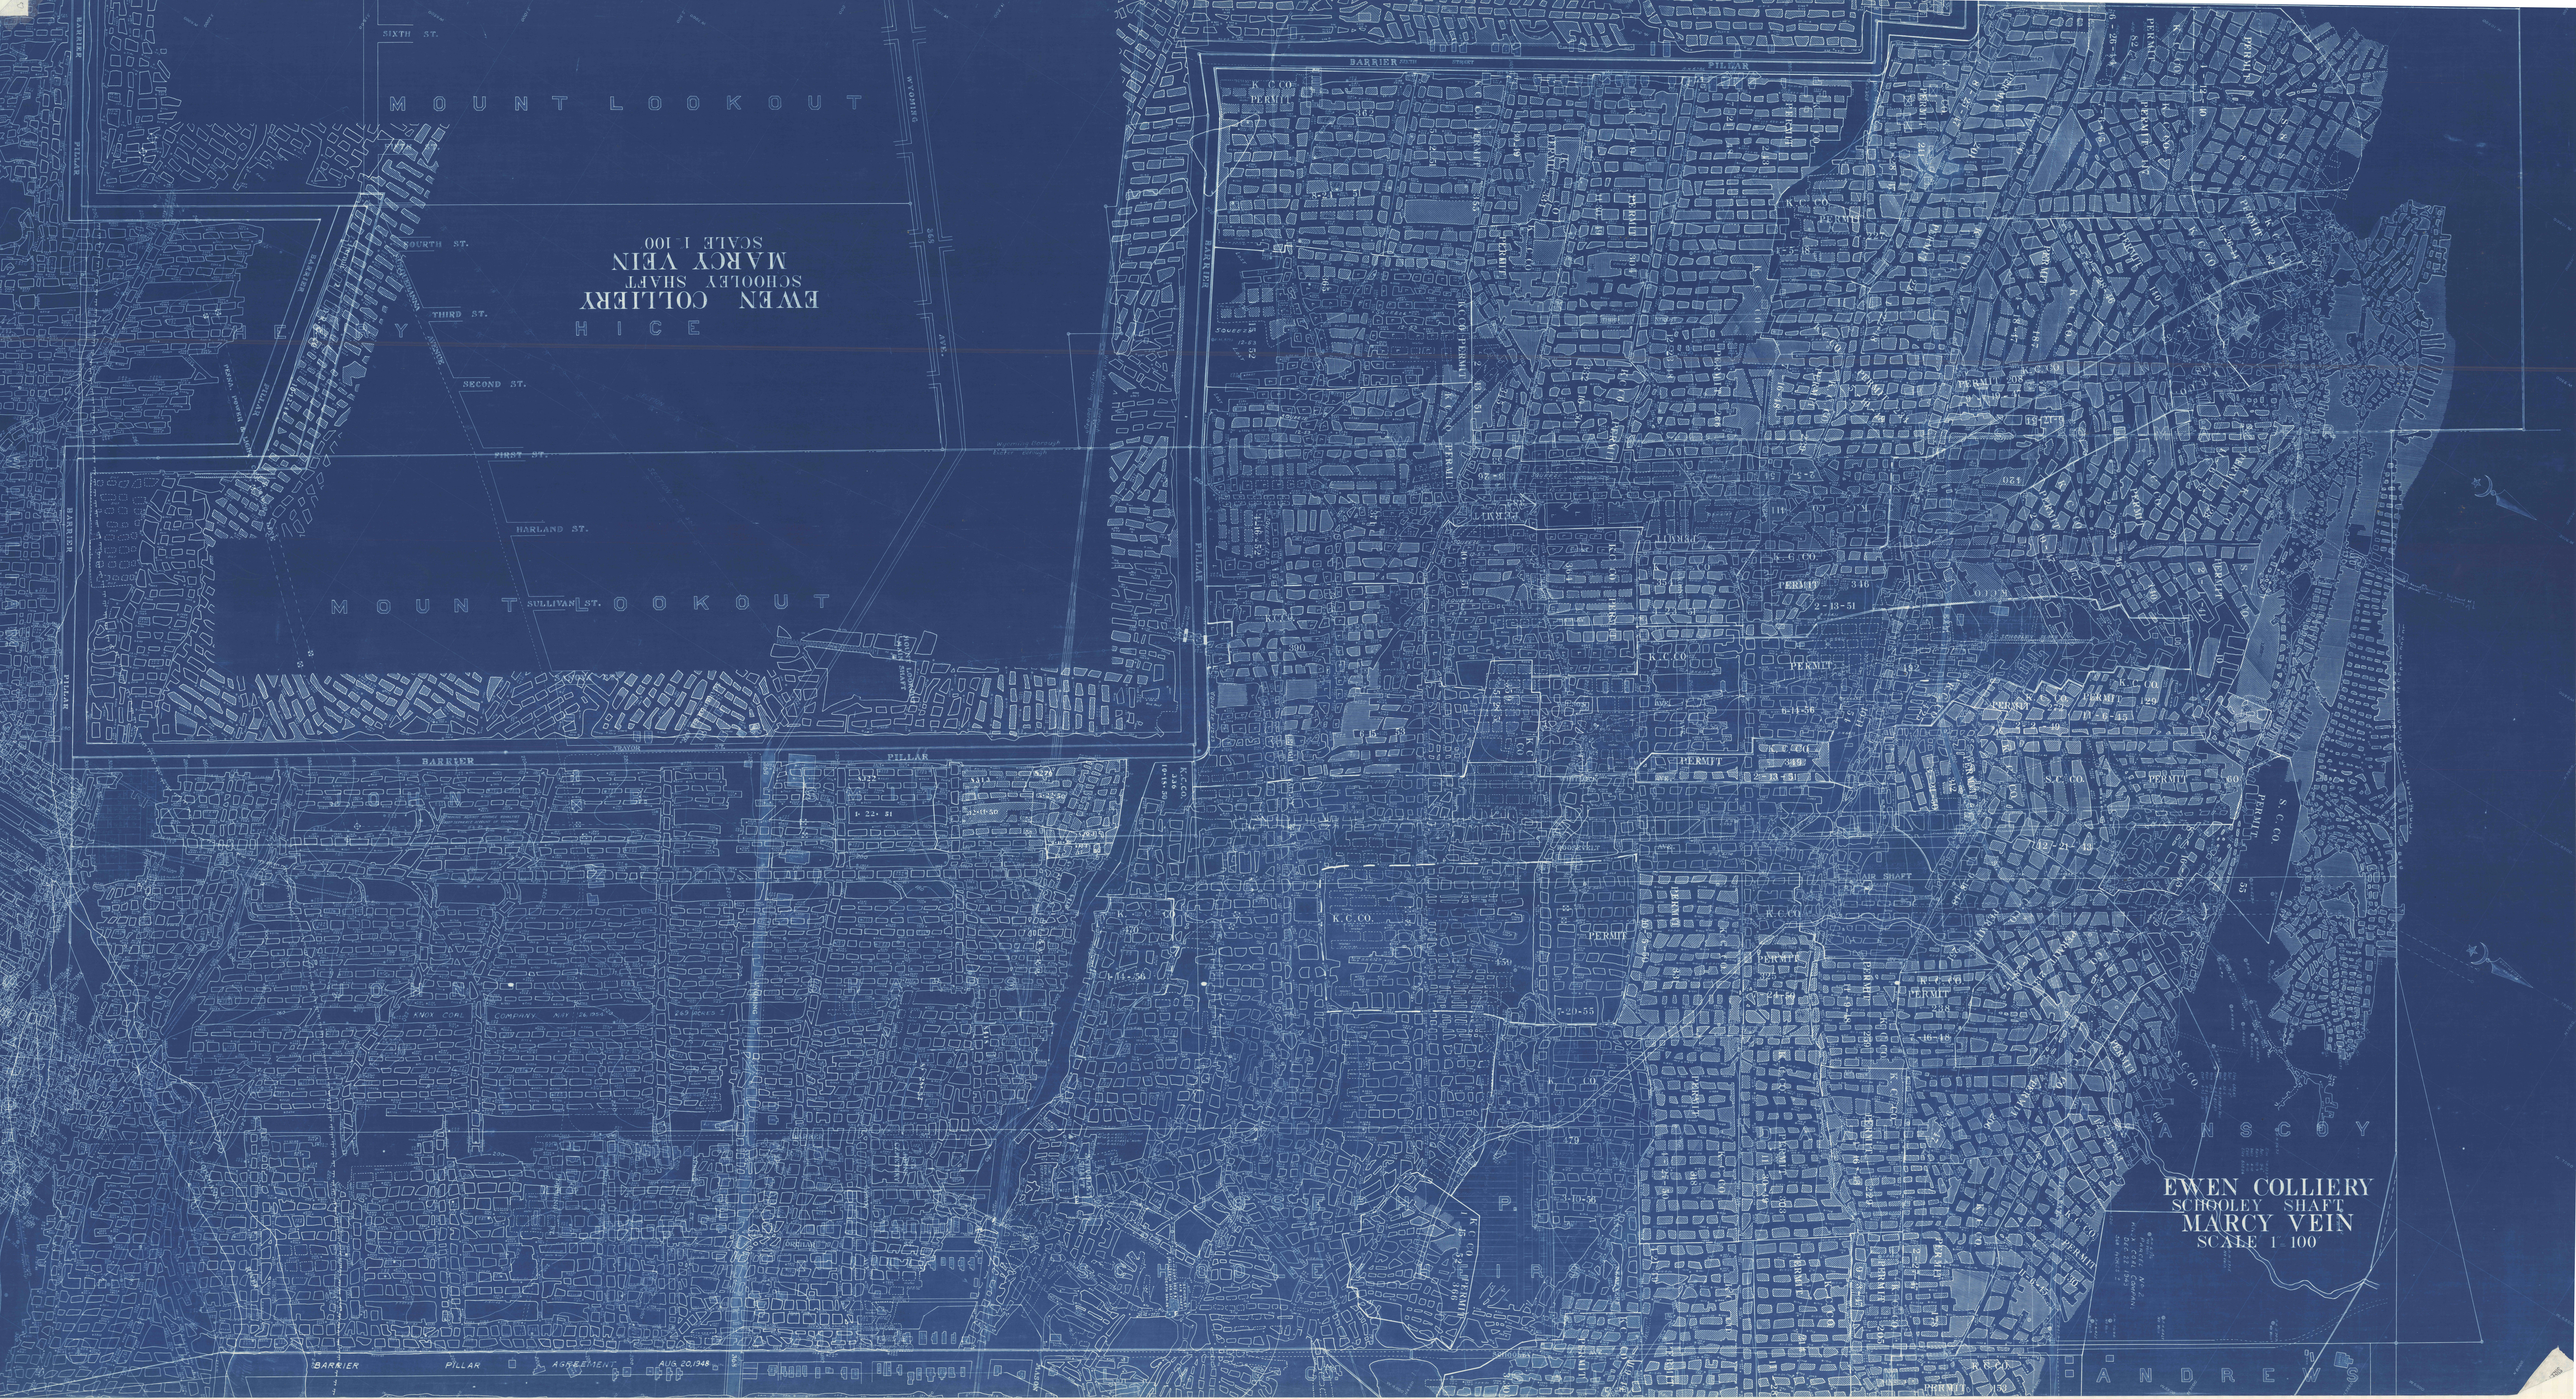

EWEN COLLIERY
SCHOOLEY SHAFT
MARCY VEIN
SCALE 1 100
MOUNT LOOKOUT
SIXTH ST.
FOURTH ST.
THIRD ST.
SECOND ST.
FIRST ST.
HARLAND ST.
SULLIVAN ST.
BARRIER
PILLAR
K.C.CO. PERMIT
PERMIT
AIR SHAFT
S.C. CO.
AGREEMENT AUG. 20, 1948
EWEN COLLIERY
SCHOOLEY SHAFT
MARCY VEIN
SCALE 1 100