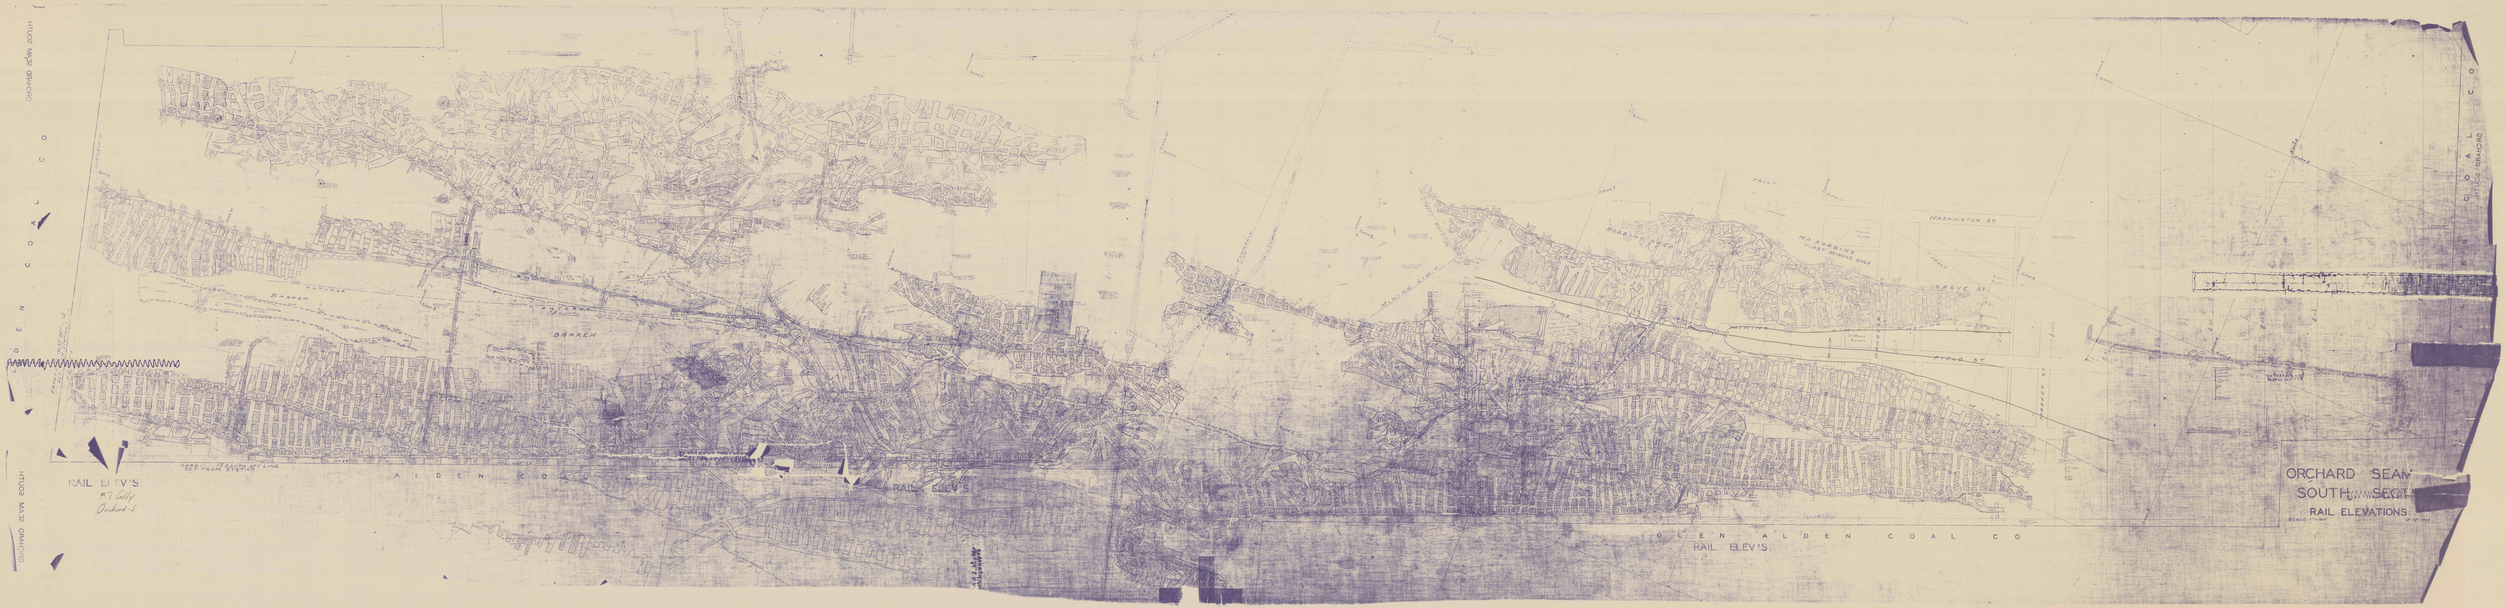
ORCHARD SEAM
SOUTH SECT.
RAIL ELEVATIONS
RAIL ELEV'S
RAIL ELEV'S
RAIL ELEV'S
RAIL ELEV'S
GLEN ALDEN COAL CO
BARREN
WASHINGTON ST
GROVE ST
PINE ST
HUDSON ST
