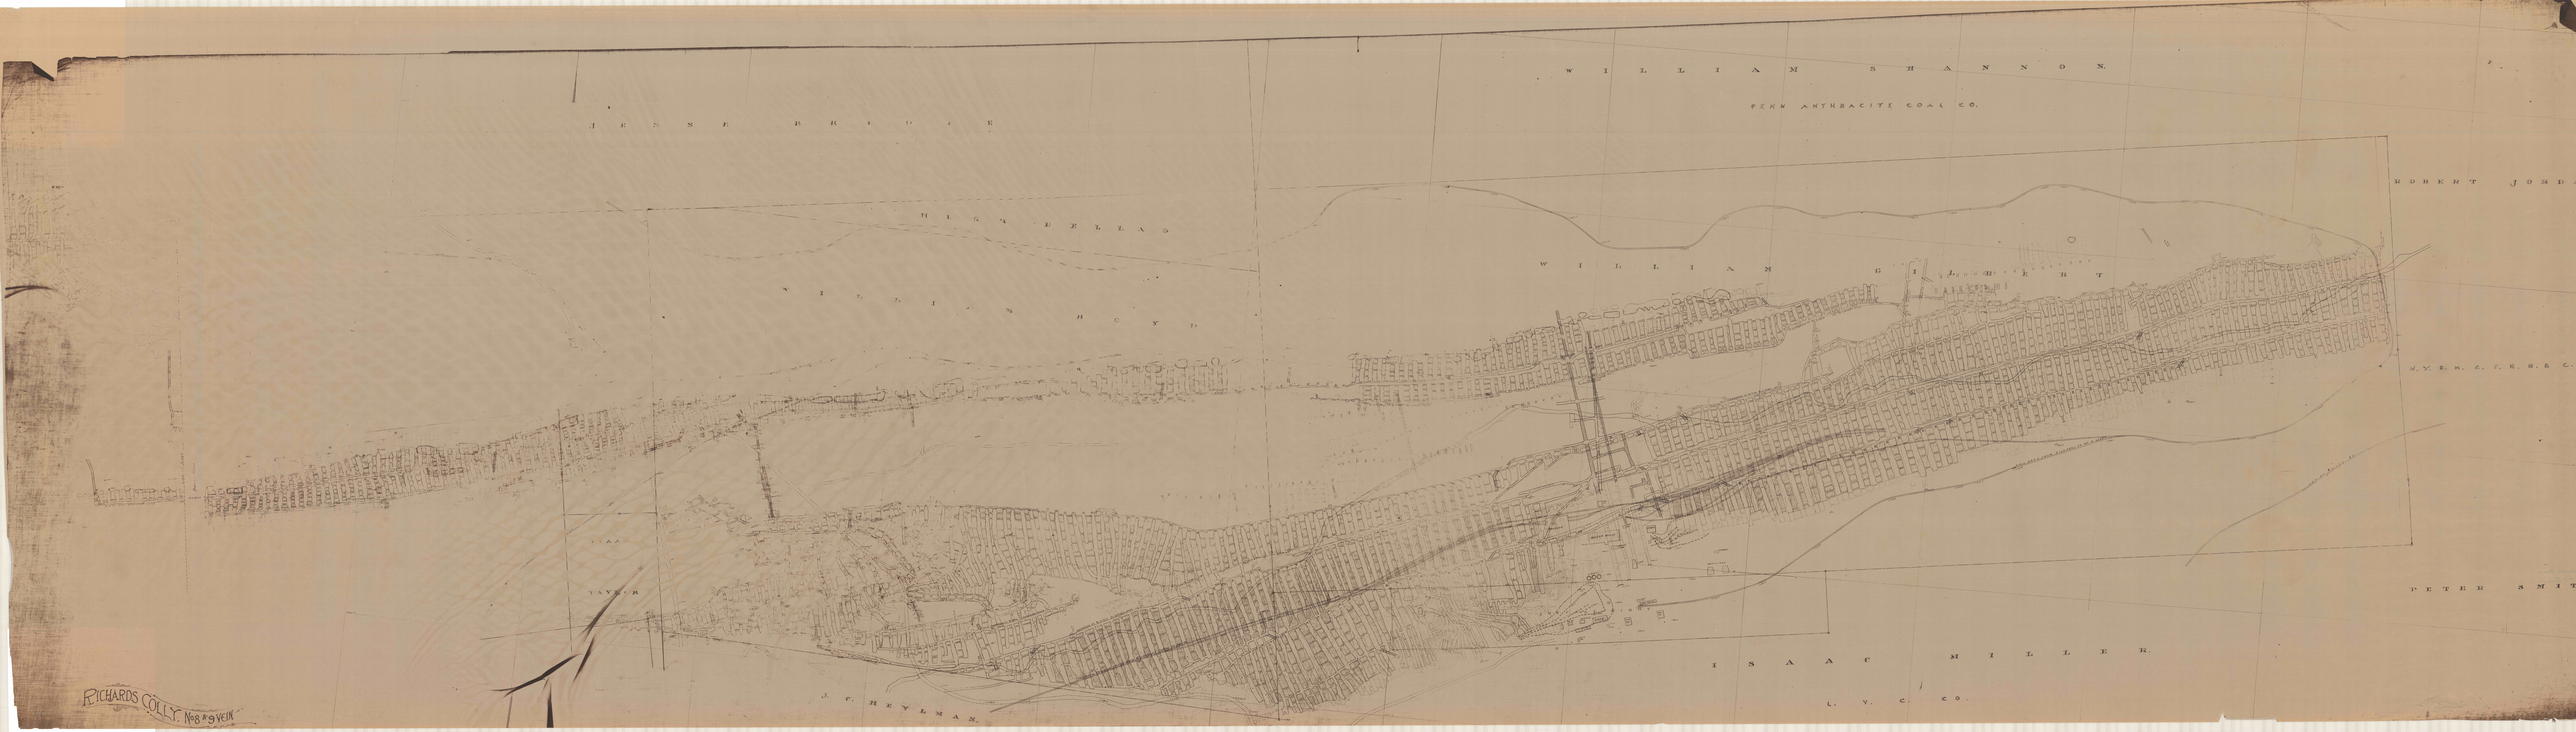

WILLIAM SHANNON
PENN ANTHRACITE COAL CO.
JESSE BRIDGE
ROBERT JORD
WILLIAM GILBERT
L.V.R.R. C.T.R.R.N.J.C.
PETER SMIT
ISAAC MILLER
L. V. C. CO.
J. C. REYLMAN.
RICHARDS COLLY. NOS 8 & 9 VEIN