


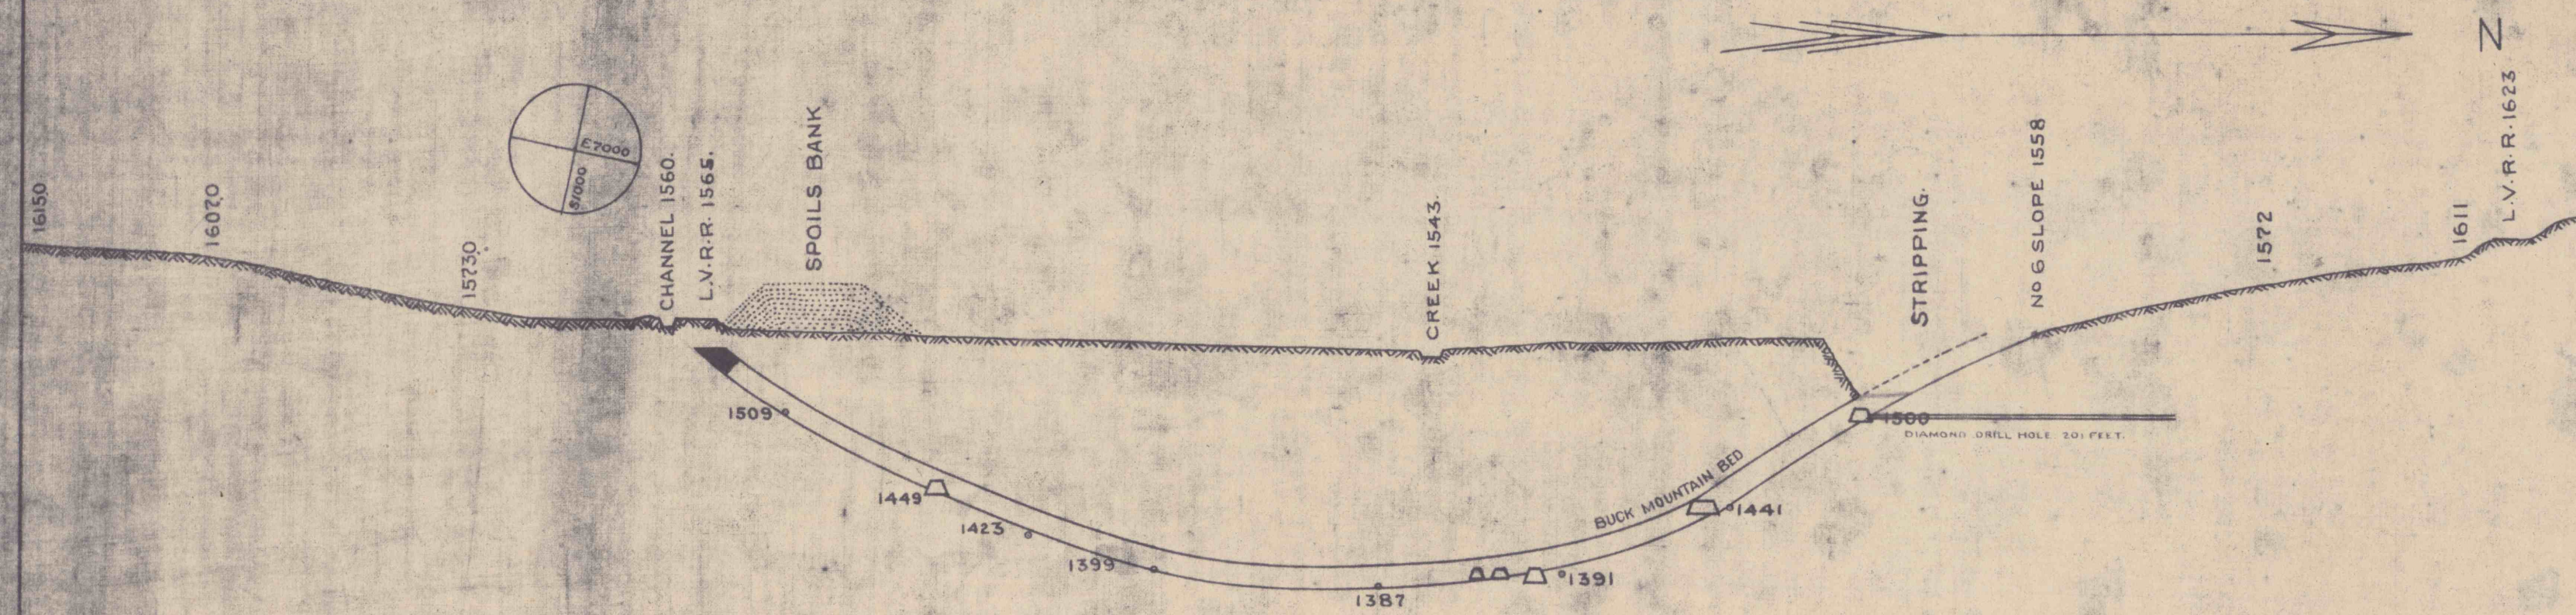

DATUM 1000

MIDDLE LEHIGH COLLIERY
SECTION THROUGH N°6 SLOPE
SCALE 100 FEET PER INCH.
FEBRUARY-9-1929.

N° 111