


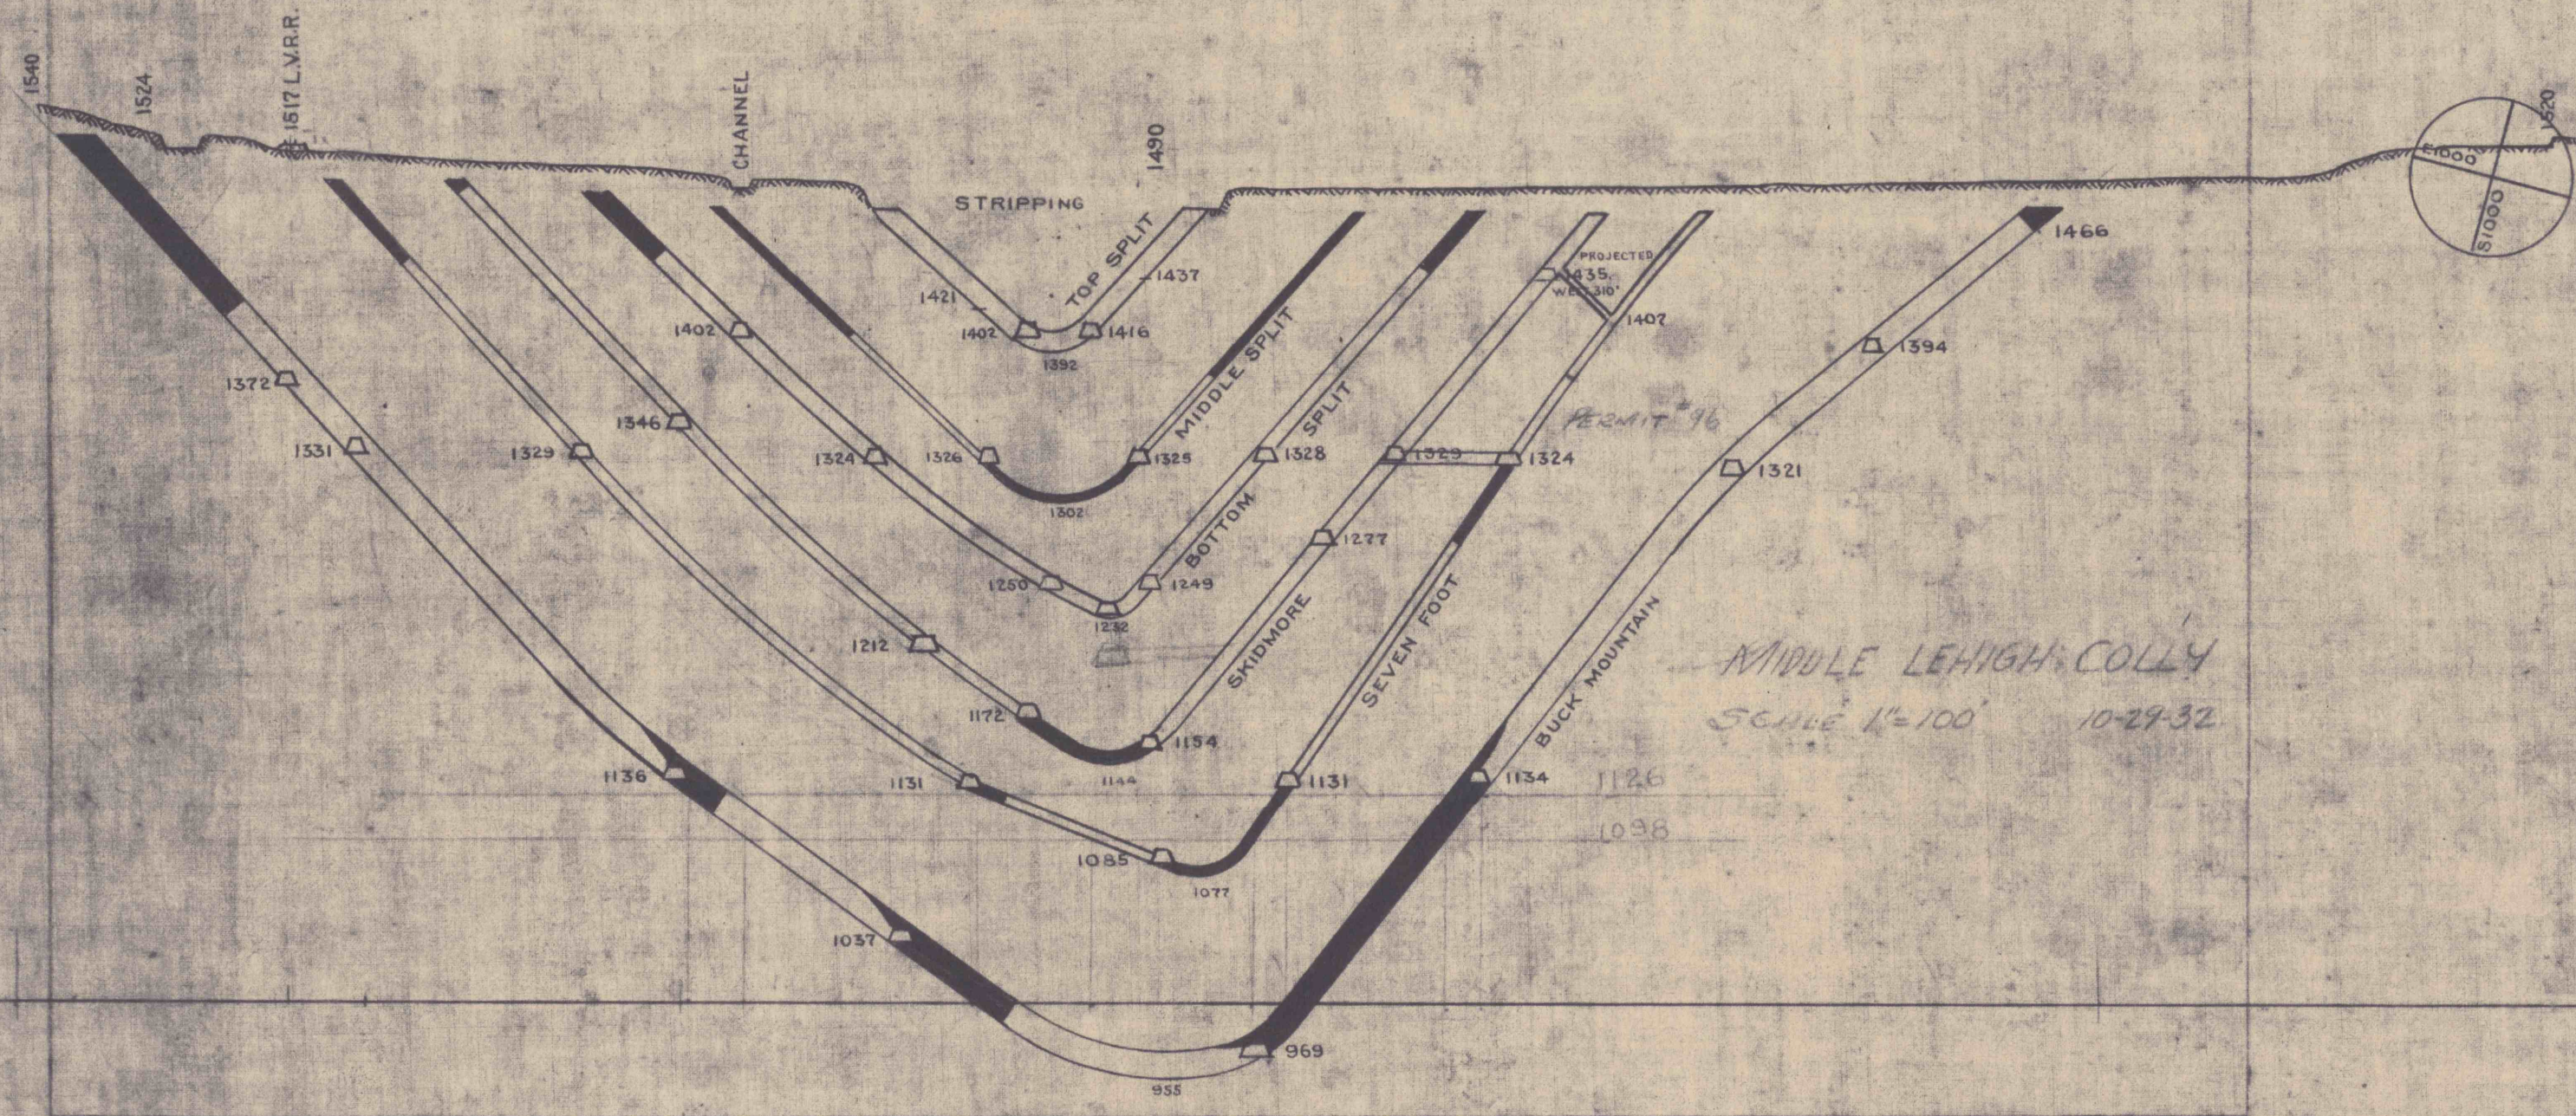

DATUM 1000 FEET.

Nº 110

MIDDLE LEHIGH COLLIERY
 SECTION 1080 FEET EAST OF WEST LINE.
 SCALE 1-INCH PER 100 FEET, FEB-25-1929.

