


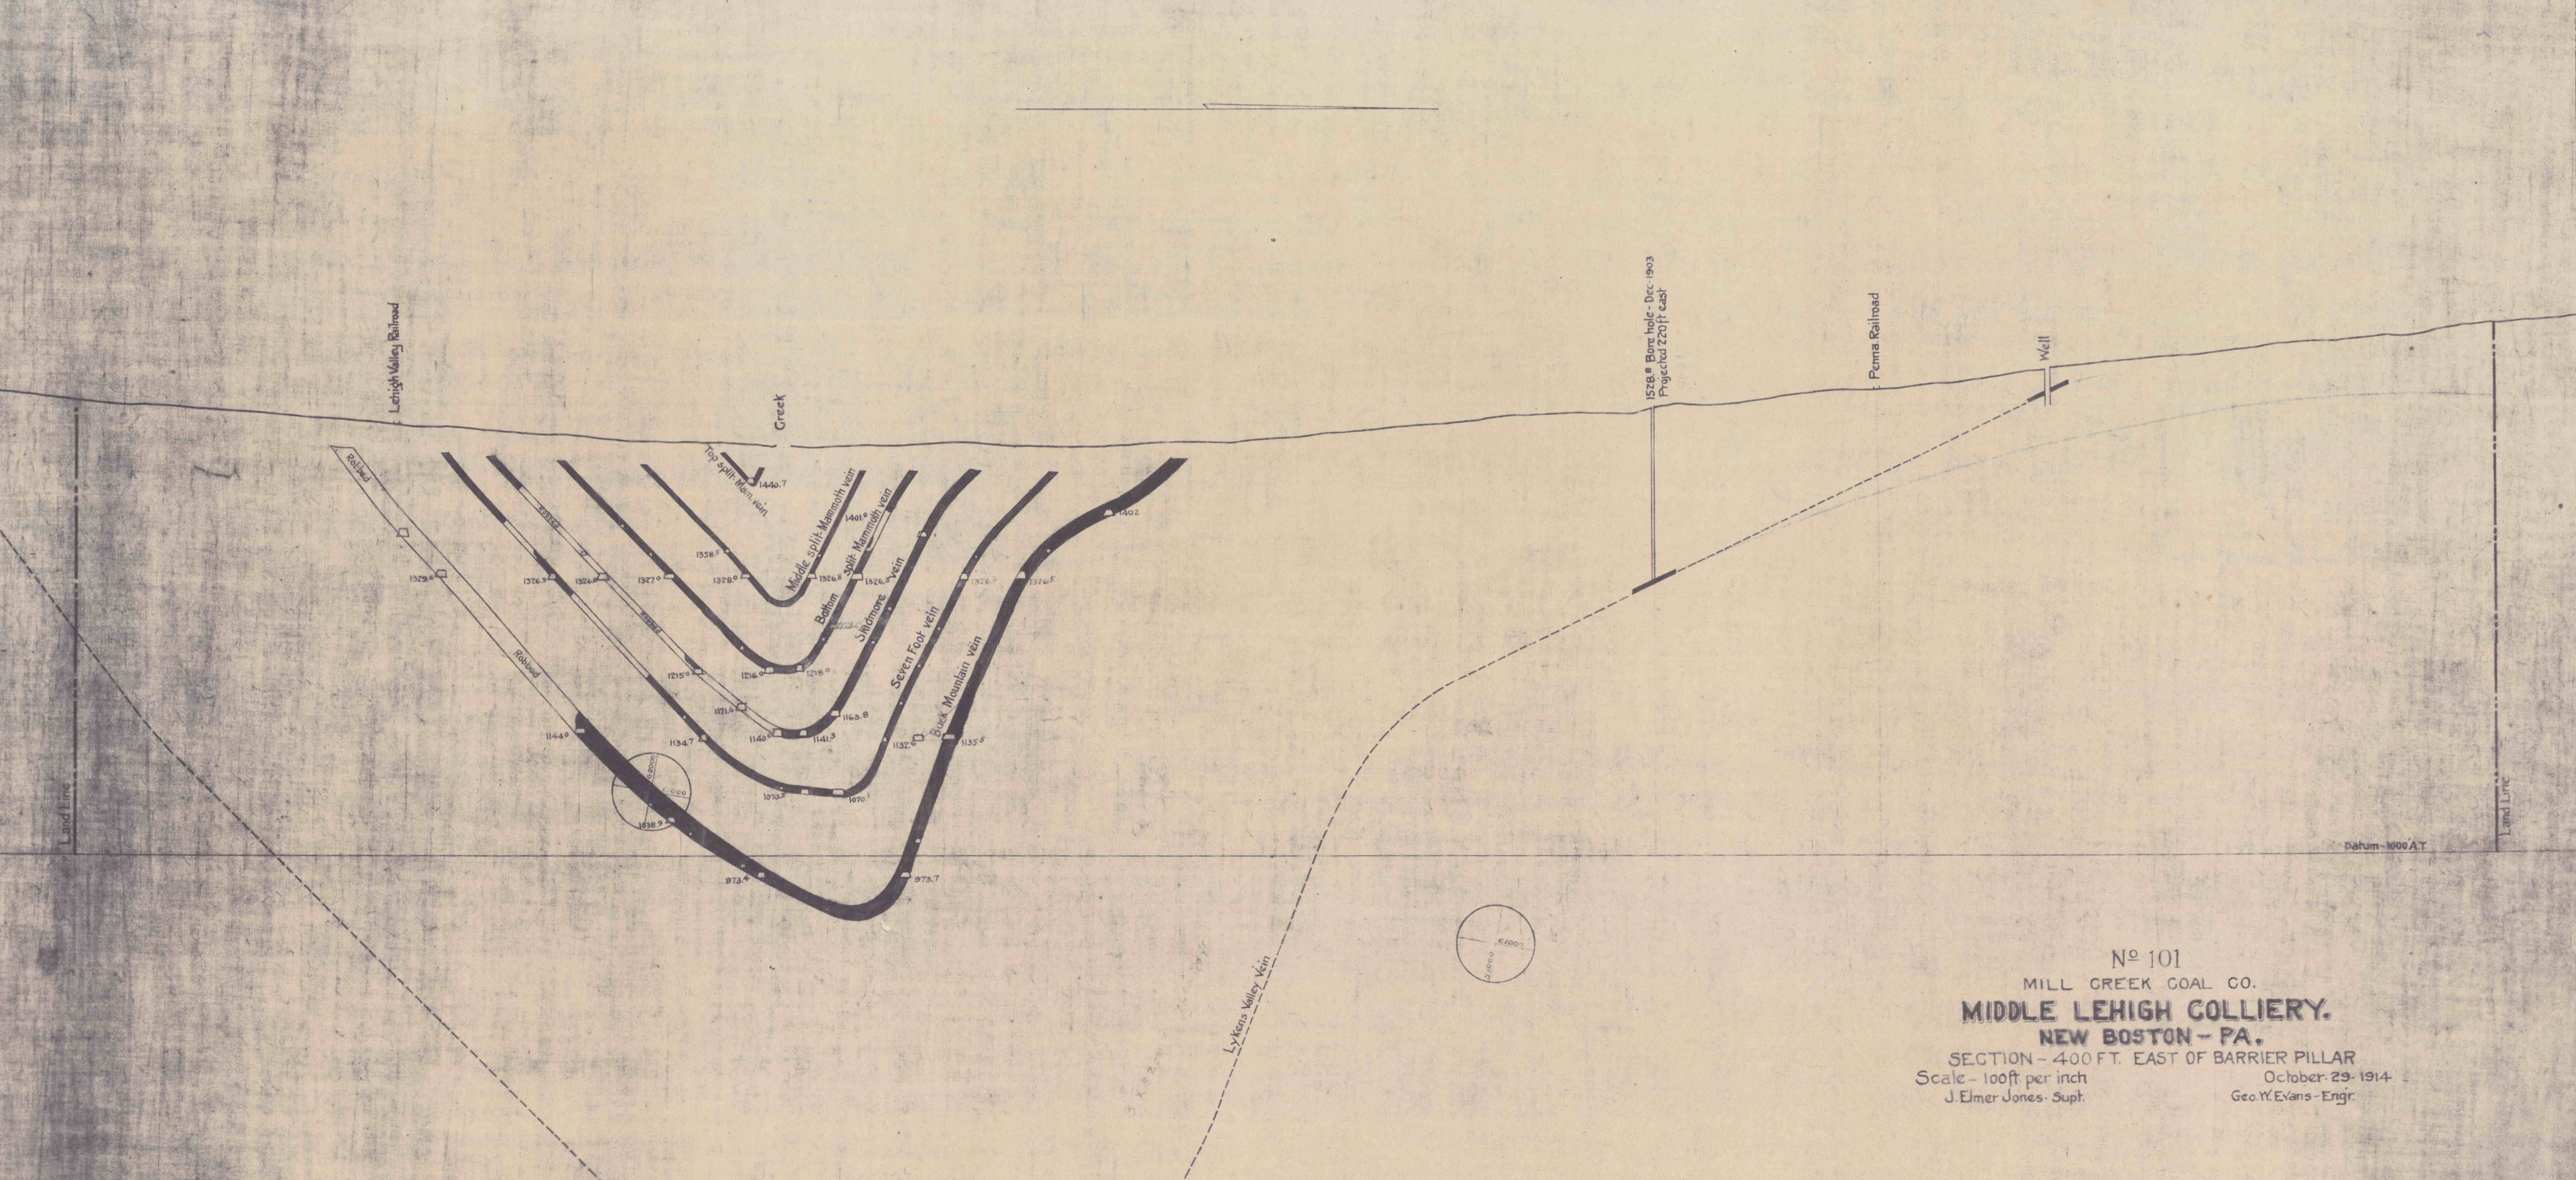

No 101
MILL CREEK COAL CO.
MIDDLE LEHIGH COLLIERY.
NEW BOSTON - PA.
SECTION - 400 FT. EAST OF BARRIER PILLAR
Scale - 100ft. per inch
J. Elmer Jones - Supt.
October 29, 1914
Geo. W. Evans - Engr.