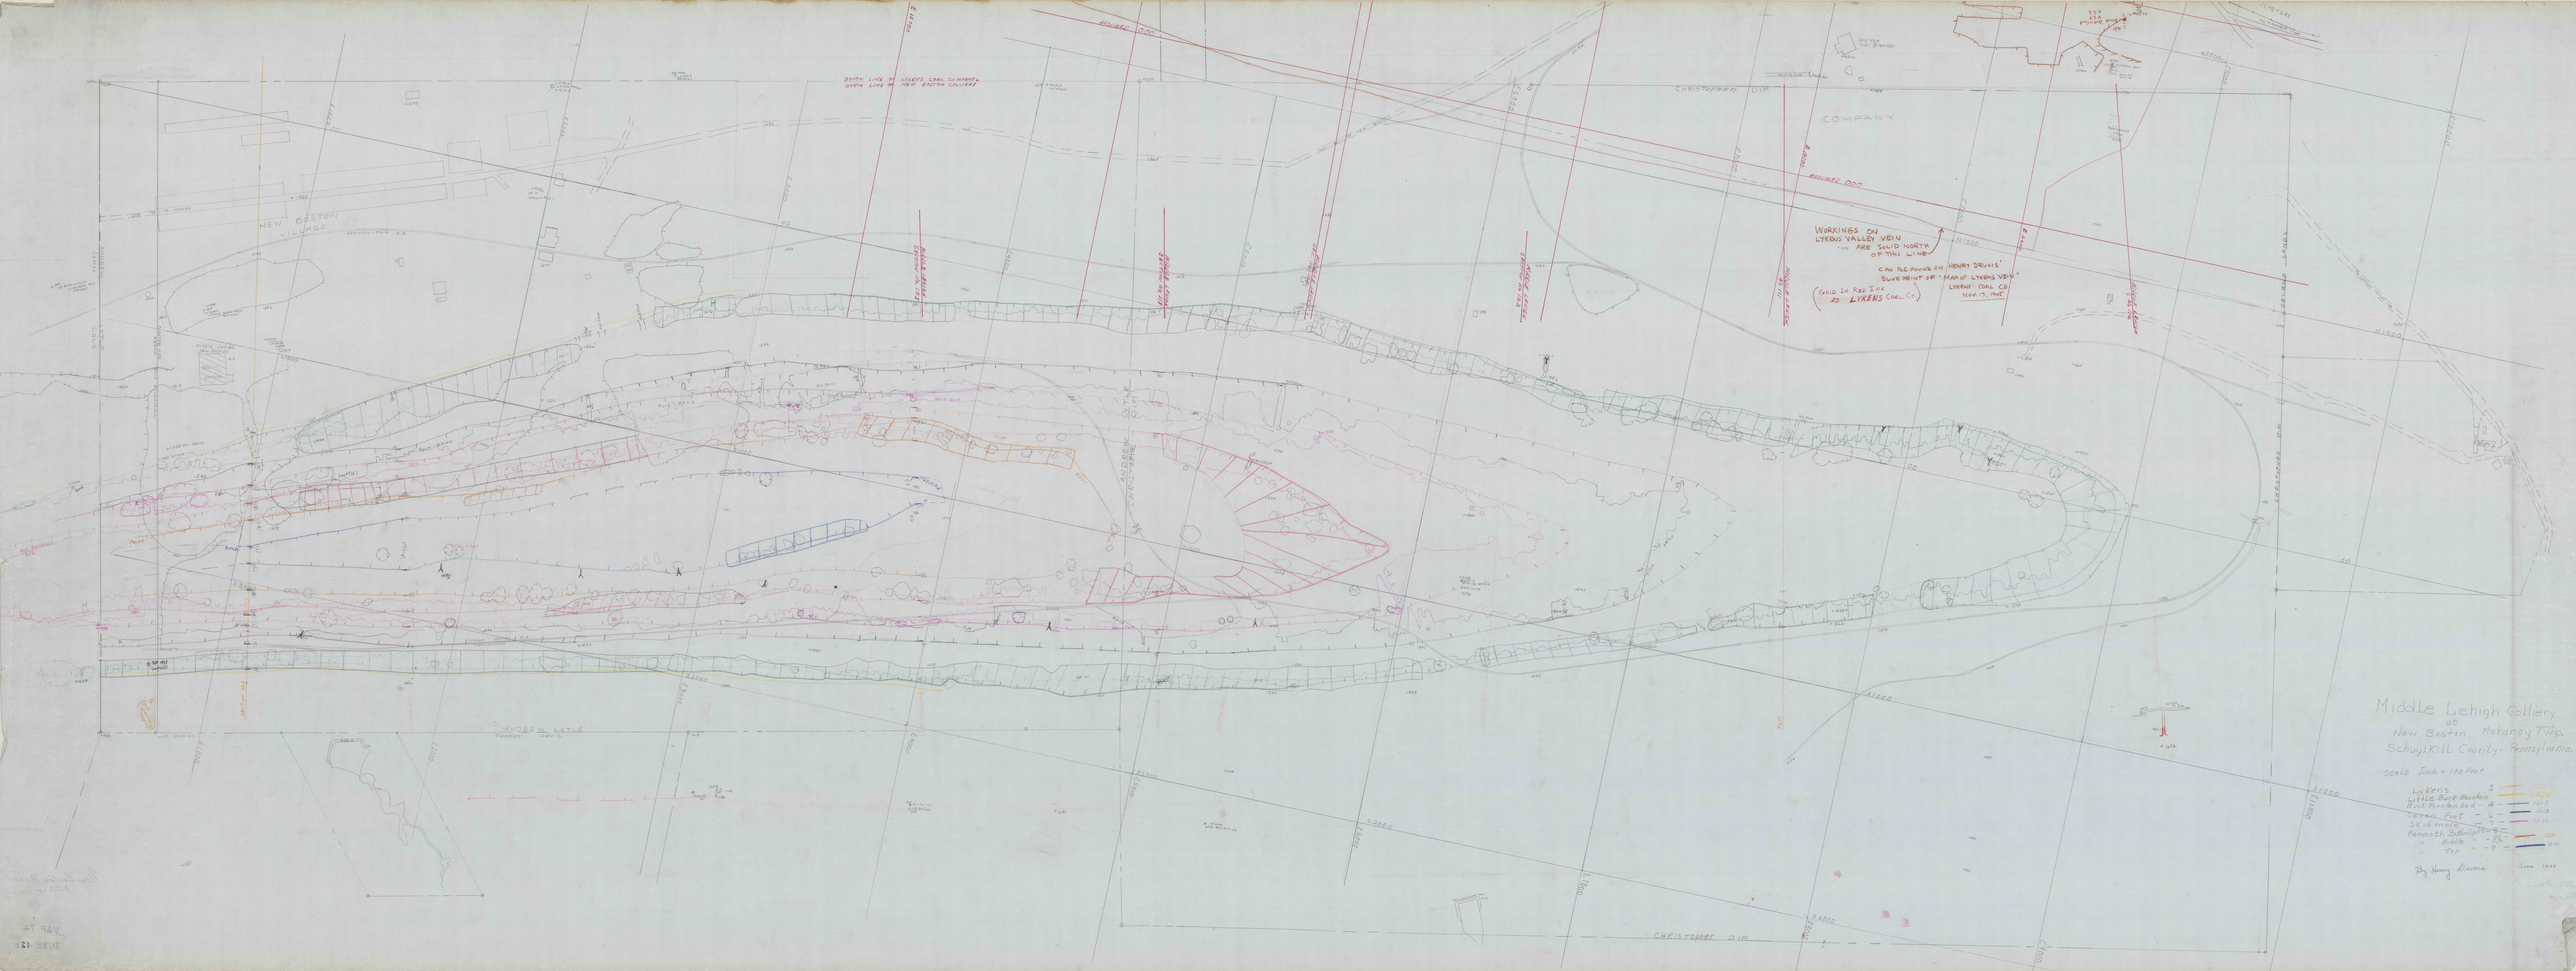
SOUTH LINE OF LYKENS COAL CO. PROPERTY
NORTH LINE OF NEW BOSTON COLLIERY
WORKINGS ON LYKENS VALLEY VEIN ARE SOLID NORTH OF THIS LINE
(SHOWN IN RED INK AS LYKENS COAL CO.)
NEW BOSTON VILLAGE
COMPANY
CHRISTOPHER DIM
CHRISTOPHER DIM
Middle Lehigh Colliery
at
New Boston, Mahanoy Twp.
Schuylkill County - Pennsylvania
scale Inch = 100 Feet
Lykens
Little Buck Mountain
Buck Mountain Bed
Seven Foot
Skidmore
Mammoth Bottom
" Middle "
" Top "
By Henry Davies
June 1949