


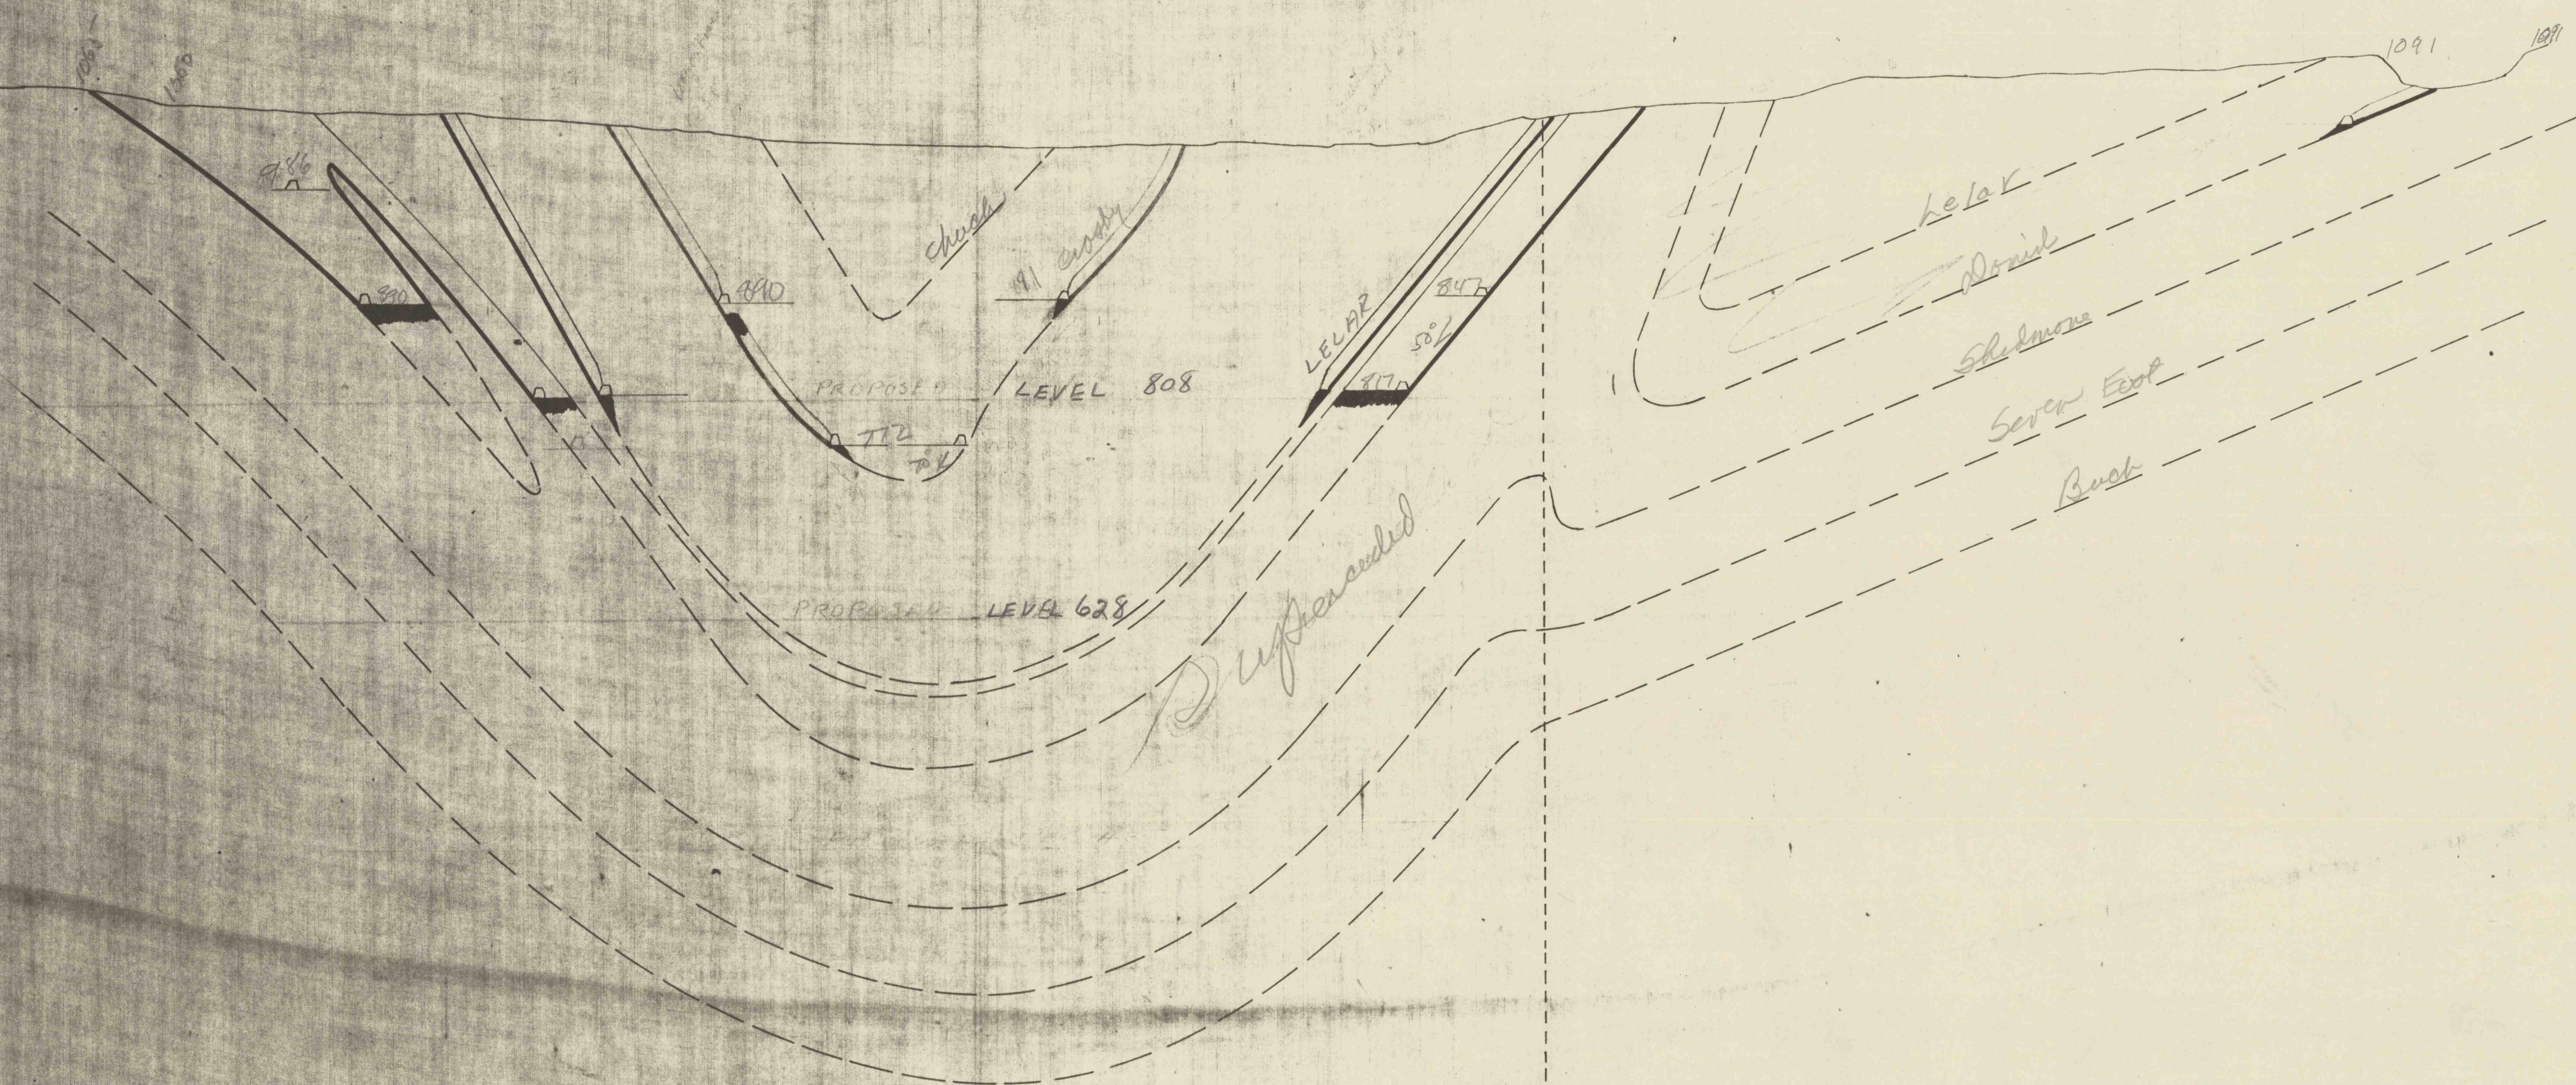

Pine Knot 6

#6