


Pine Knot 5

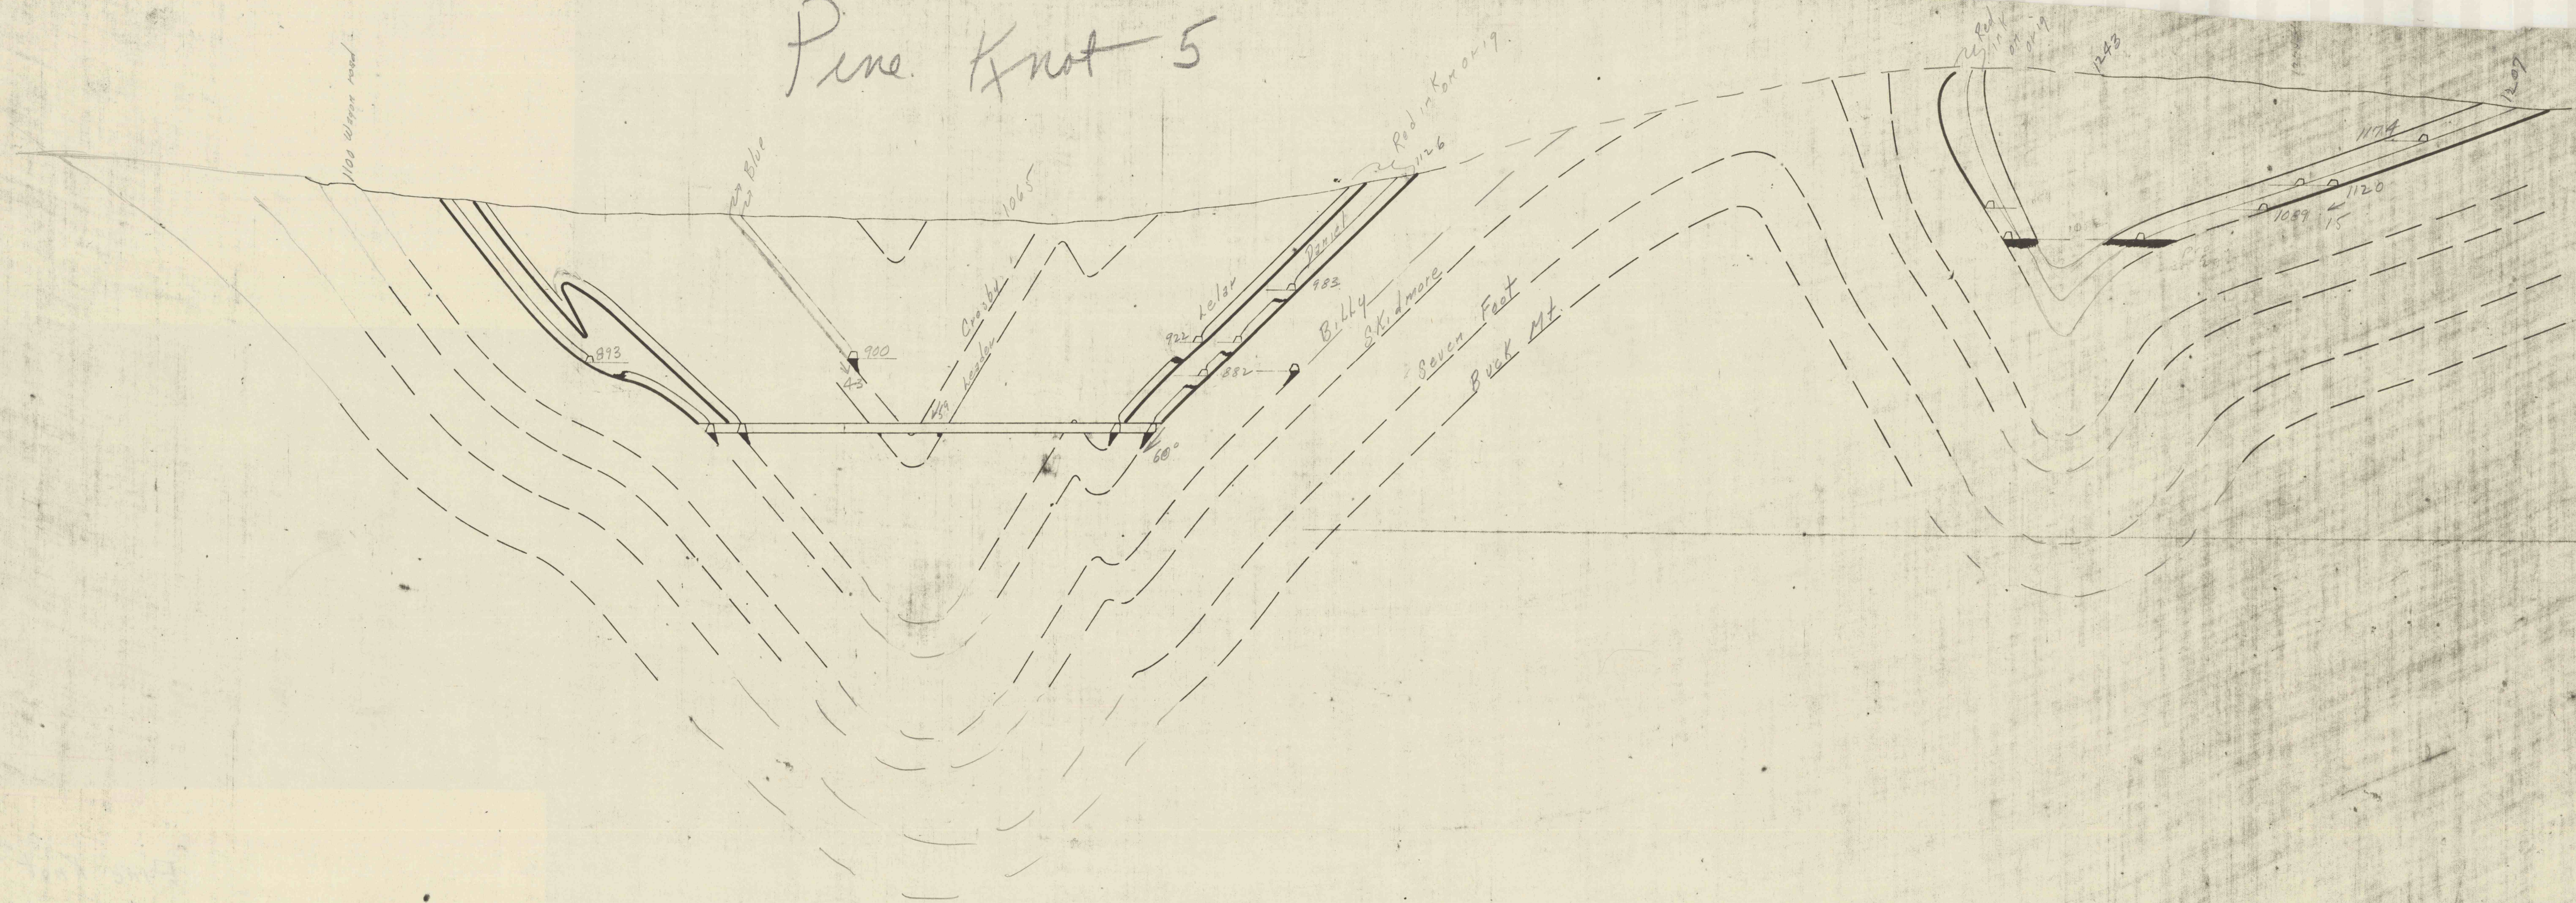

SECTION #5

72920

Pine Knot #5