


LOOKING WESTWARD

N

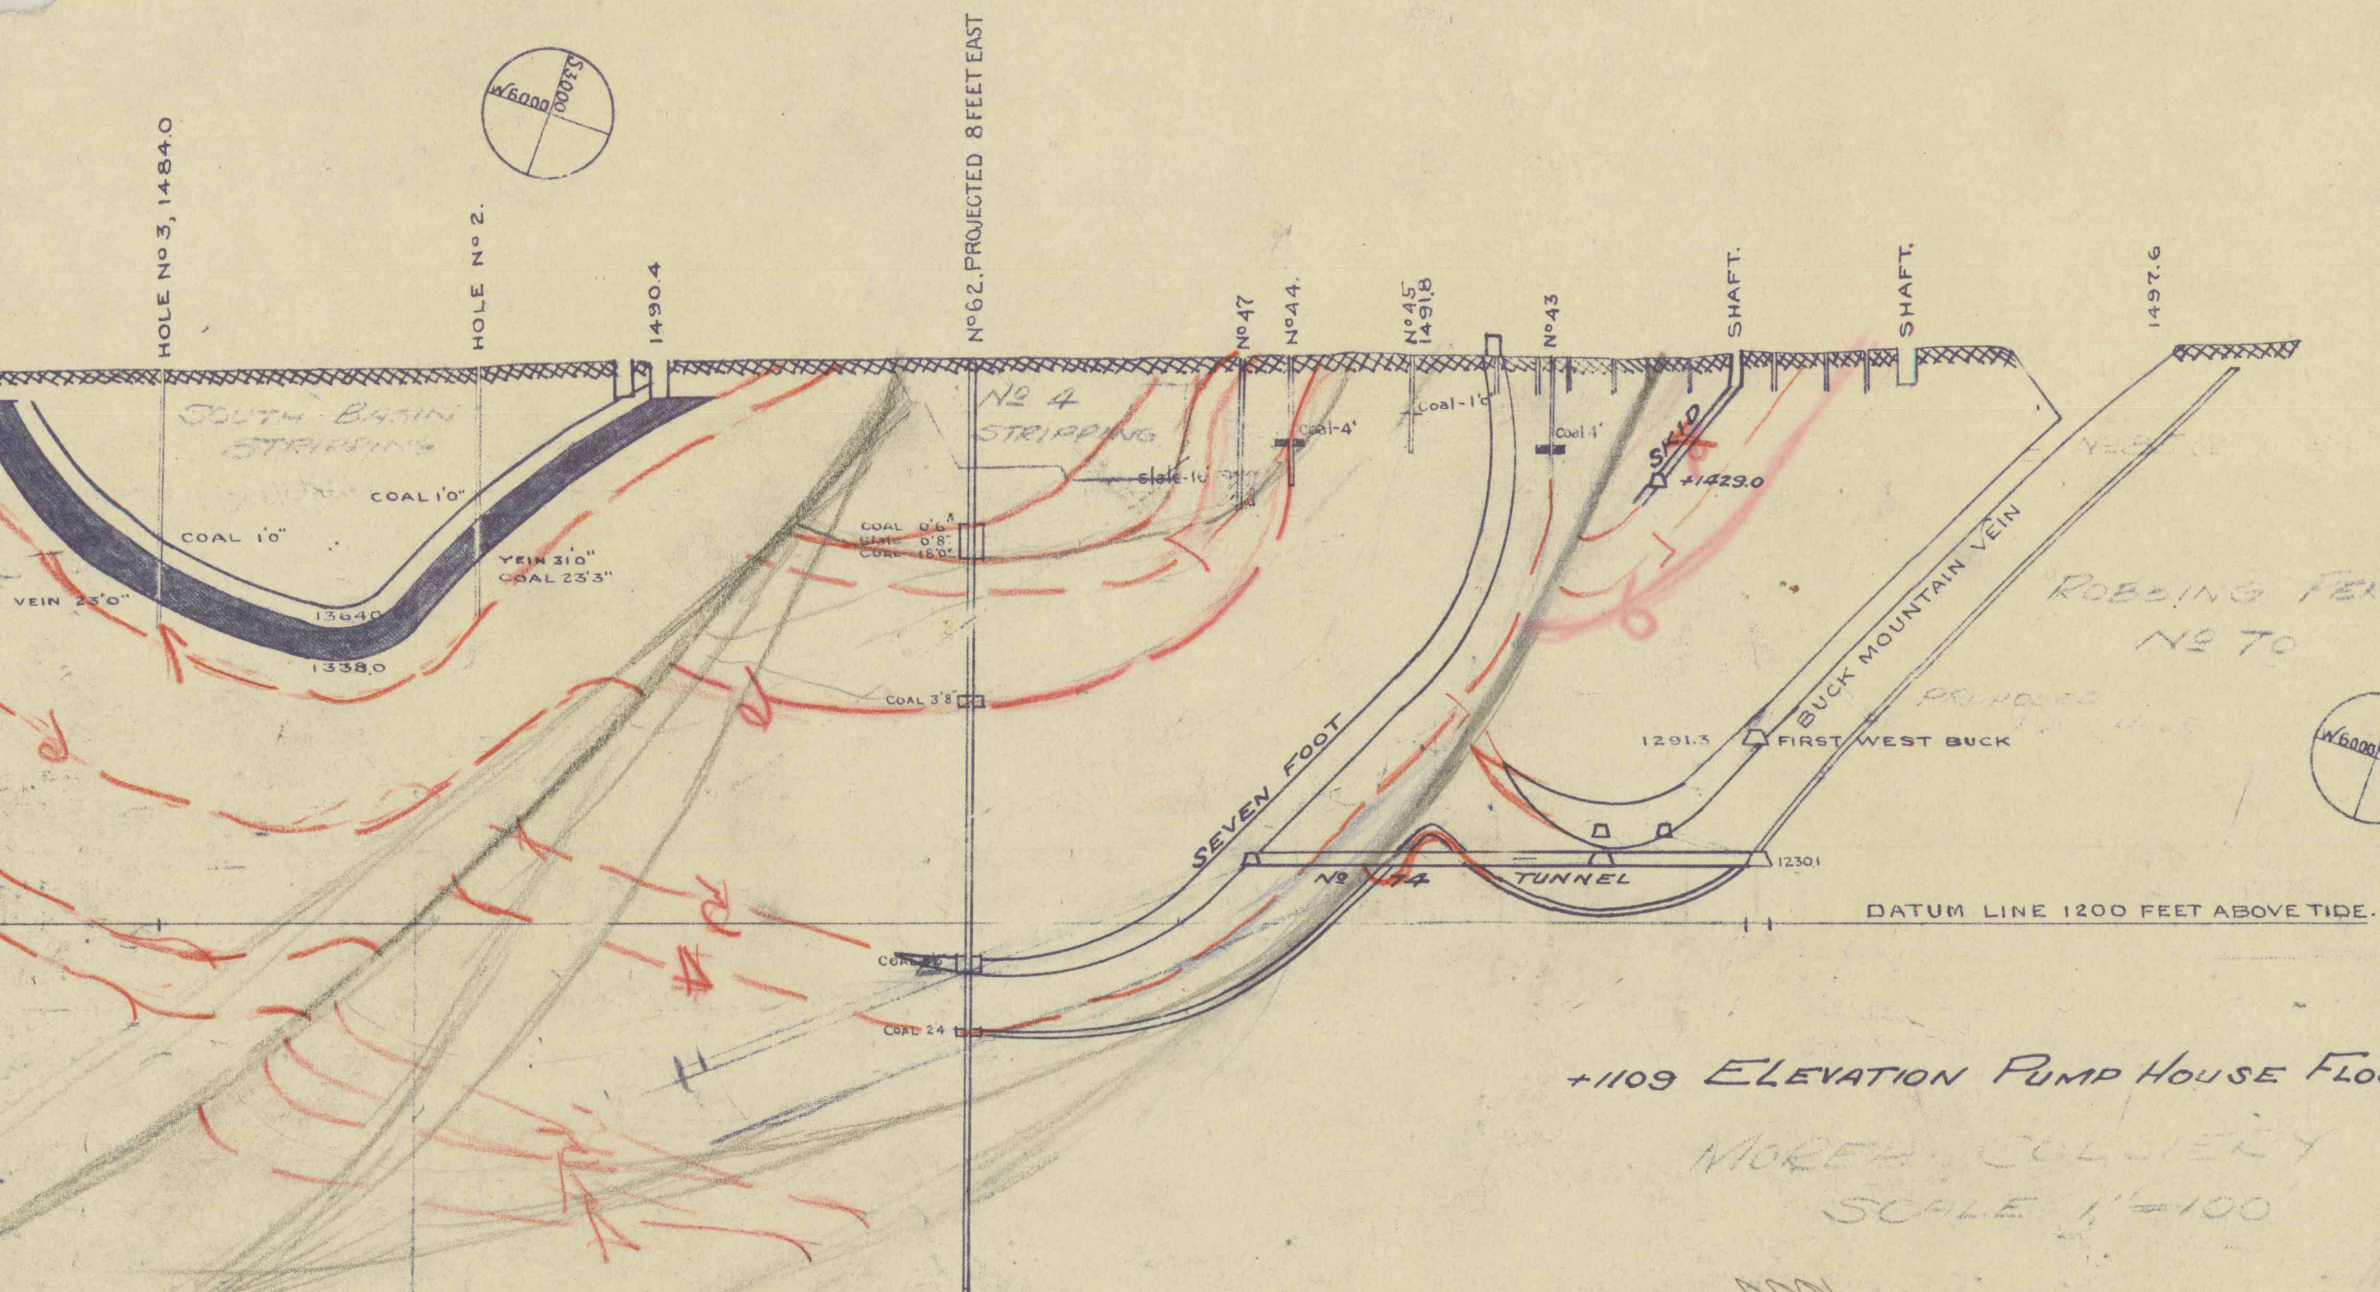

+1109 ELEVATION PUMP HOUSE FLOOR

MOREA COLLIERY
SCALE 1"=100

0001

— No 6 —

— MOREA COLLIERY —

SECTION 3500 FEET WEST OF THE
DELANO WEST LINE

OR THROUGH BREAST No 21 IN THE

FIRST WEST SOUTH DIP

BUCK MOUNTAIN VEIN GANGWAY

— 100 FOOT SCALE —

42° 25' 30"