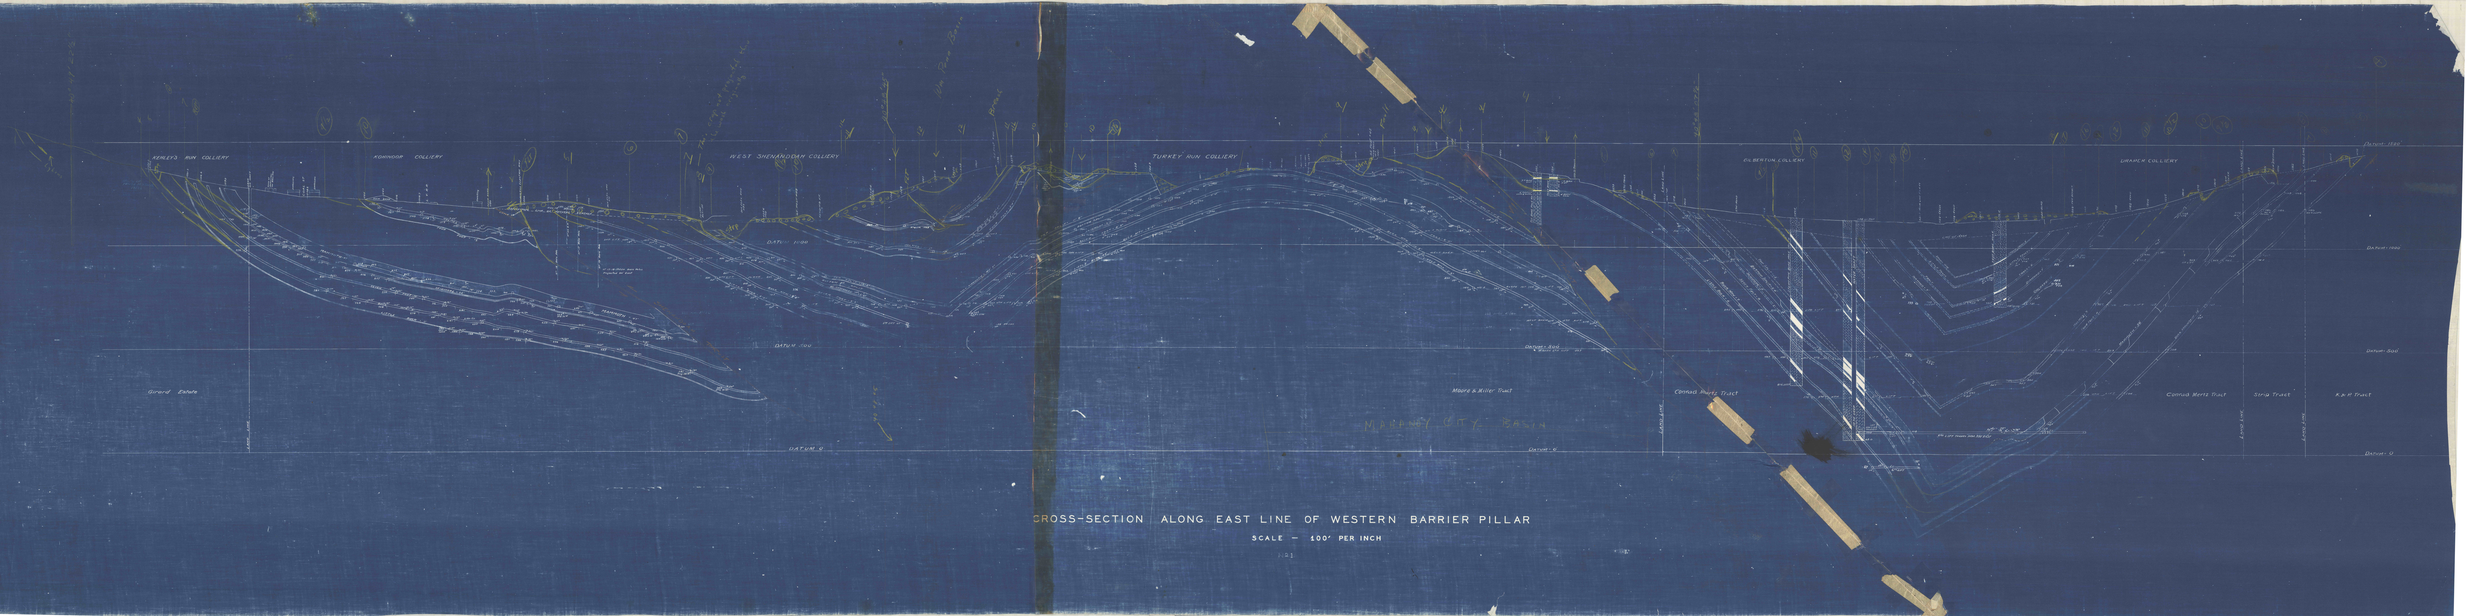


CROSS-SECTION ALONG EAST LINE OF WESTERN BARRIER PILLAR

SCALE — 100' PER INCH