


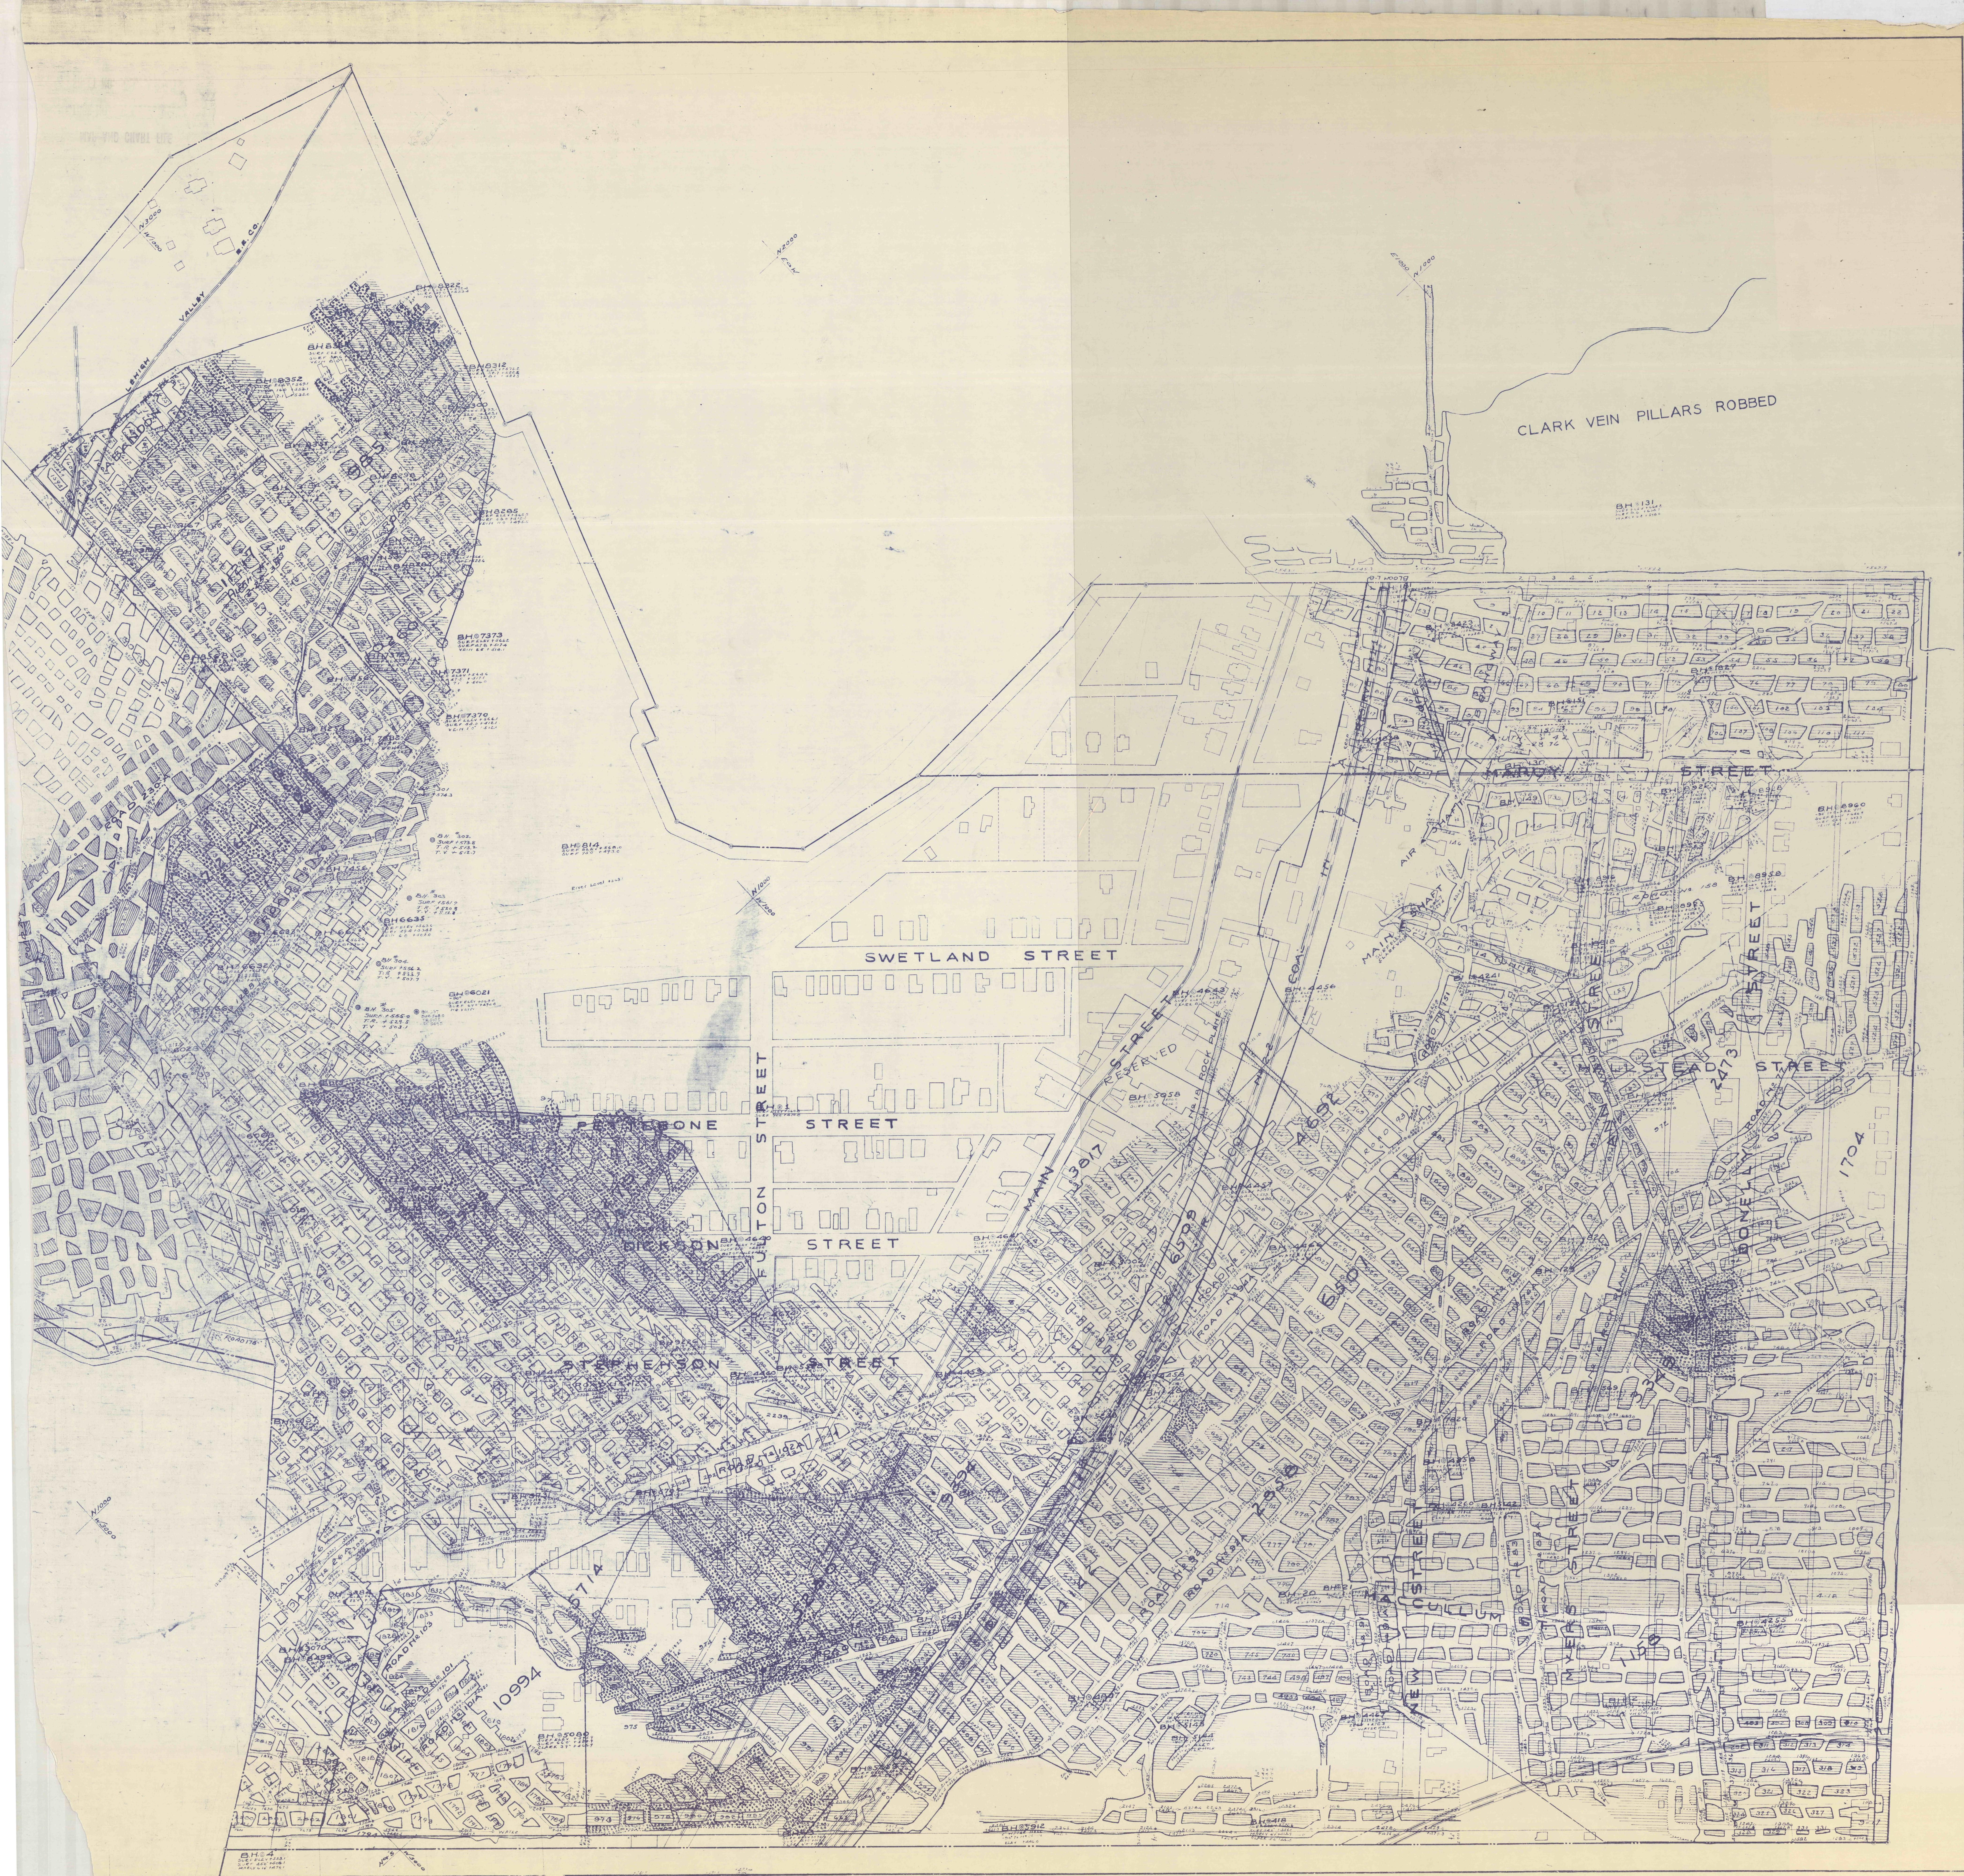

CLARK VEIN