


— LOOKING WEST —

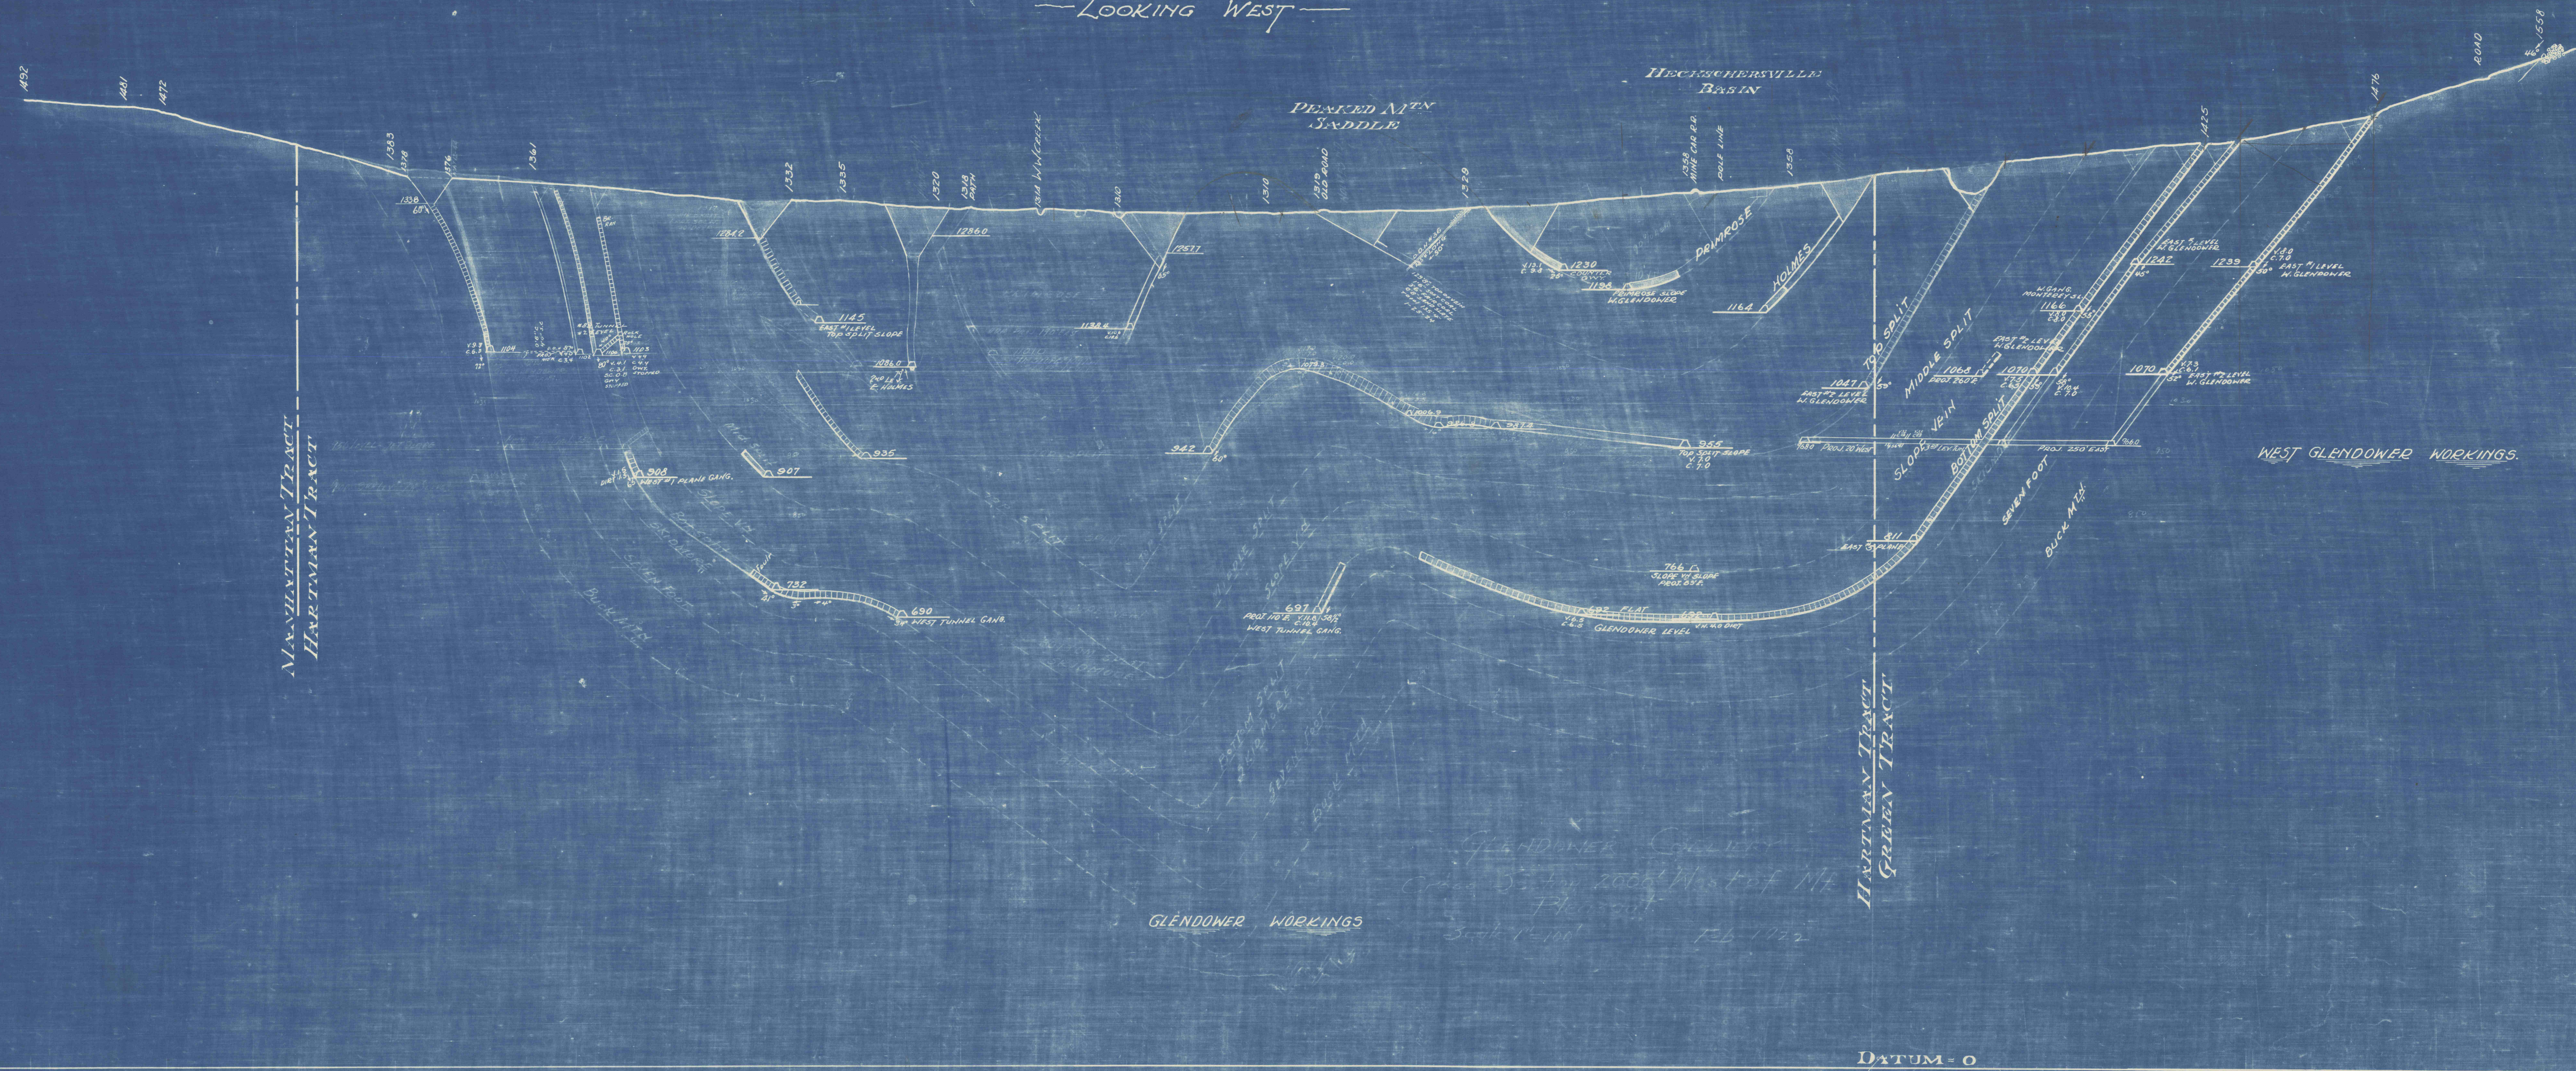

GLENDOWER COLLY

CROSS SECTION 2000' WEST OF MOUNT PLEASANT

SCALE 1"=100' FEB 1922
— TO COMPS. —
— DIV. ENG'G. —

#41

CROSS SECTION #41