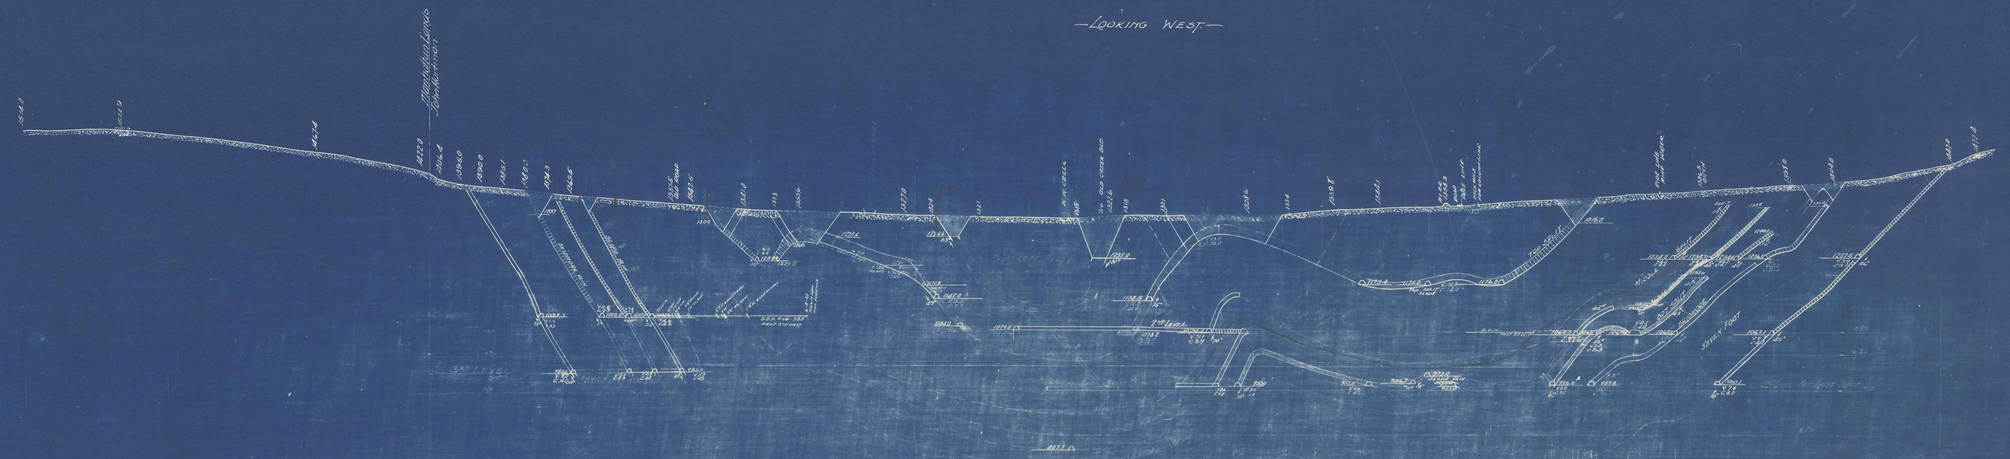

GLENDOWER COLLY.

CROSS SECTION THRU W. GLENDOWER 500' EAST OF #89½ TUNNEL.

SCALE 1"=100'

JANUARY, 1925.

#50

#50