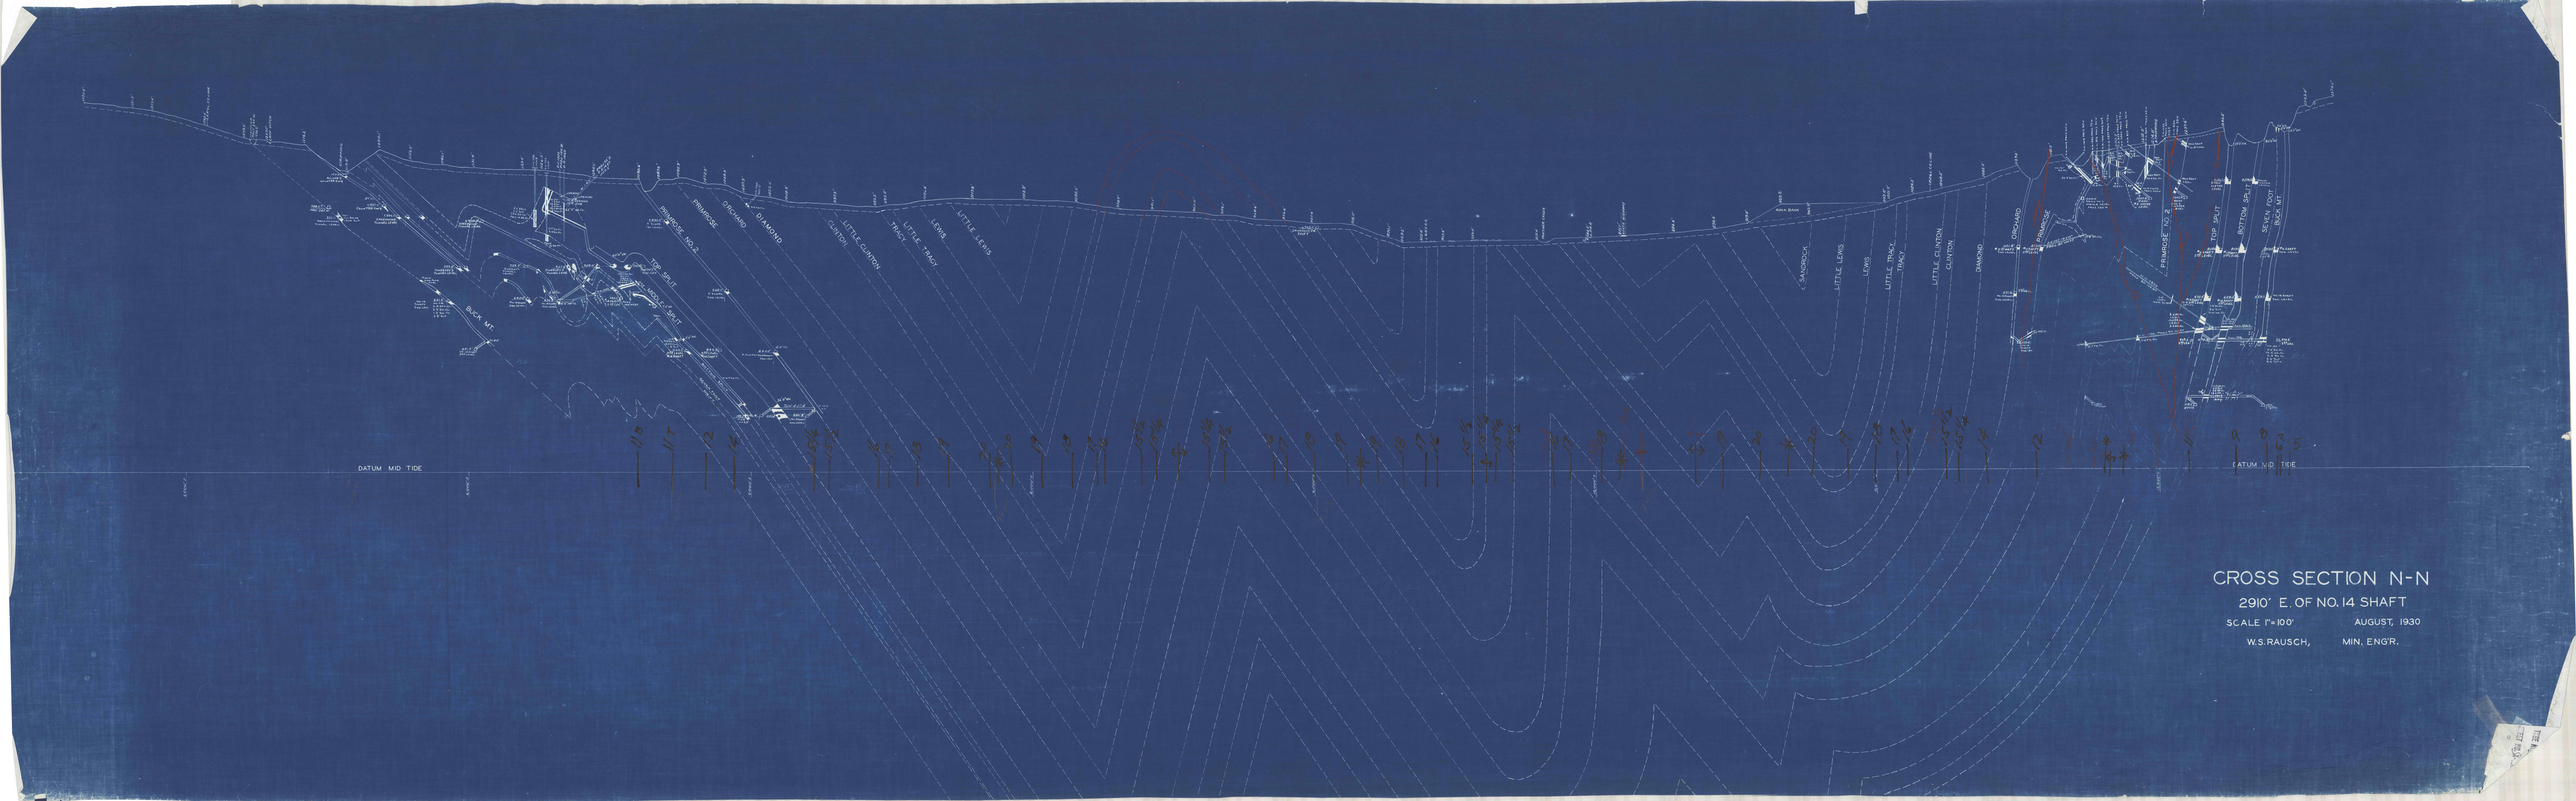

CROSS SECTION N-N

2910' E. OF NO. 14 SHAFT

SCALE 1"=100' AUGUST, 1930

W.S. RAUSCH, MIN. ENG'R.