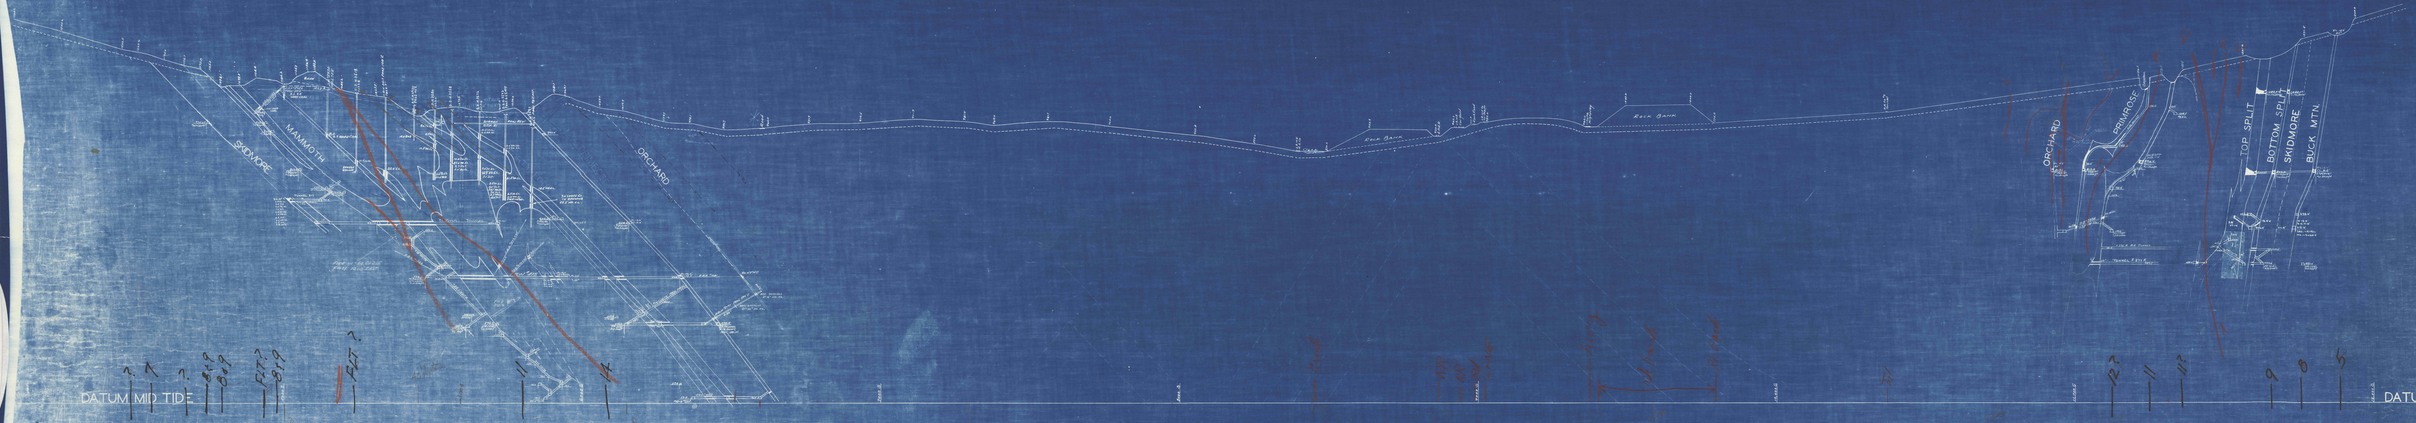

CROSS SECTION ON LINE M

2250' W. OF NO.10 SHAFT.

2800' W. " " 11 "

SCALE 1:100 OCT. 1925

W.S. RAUSCH, MIN. ENG'R.