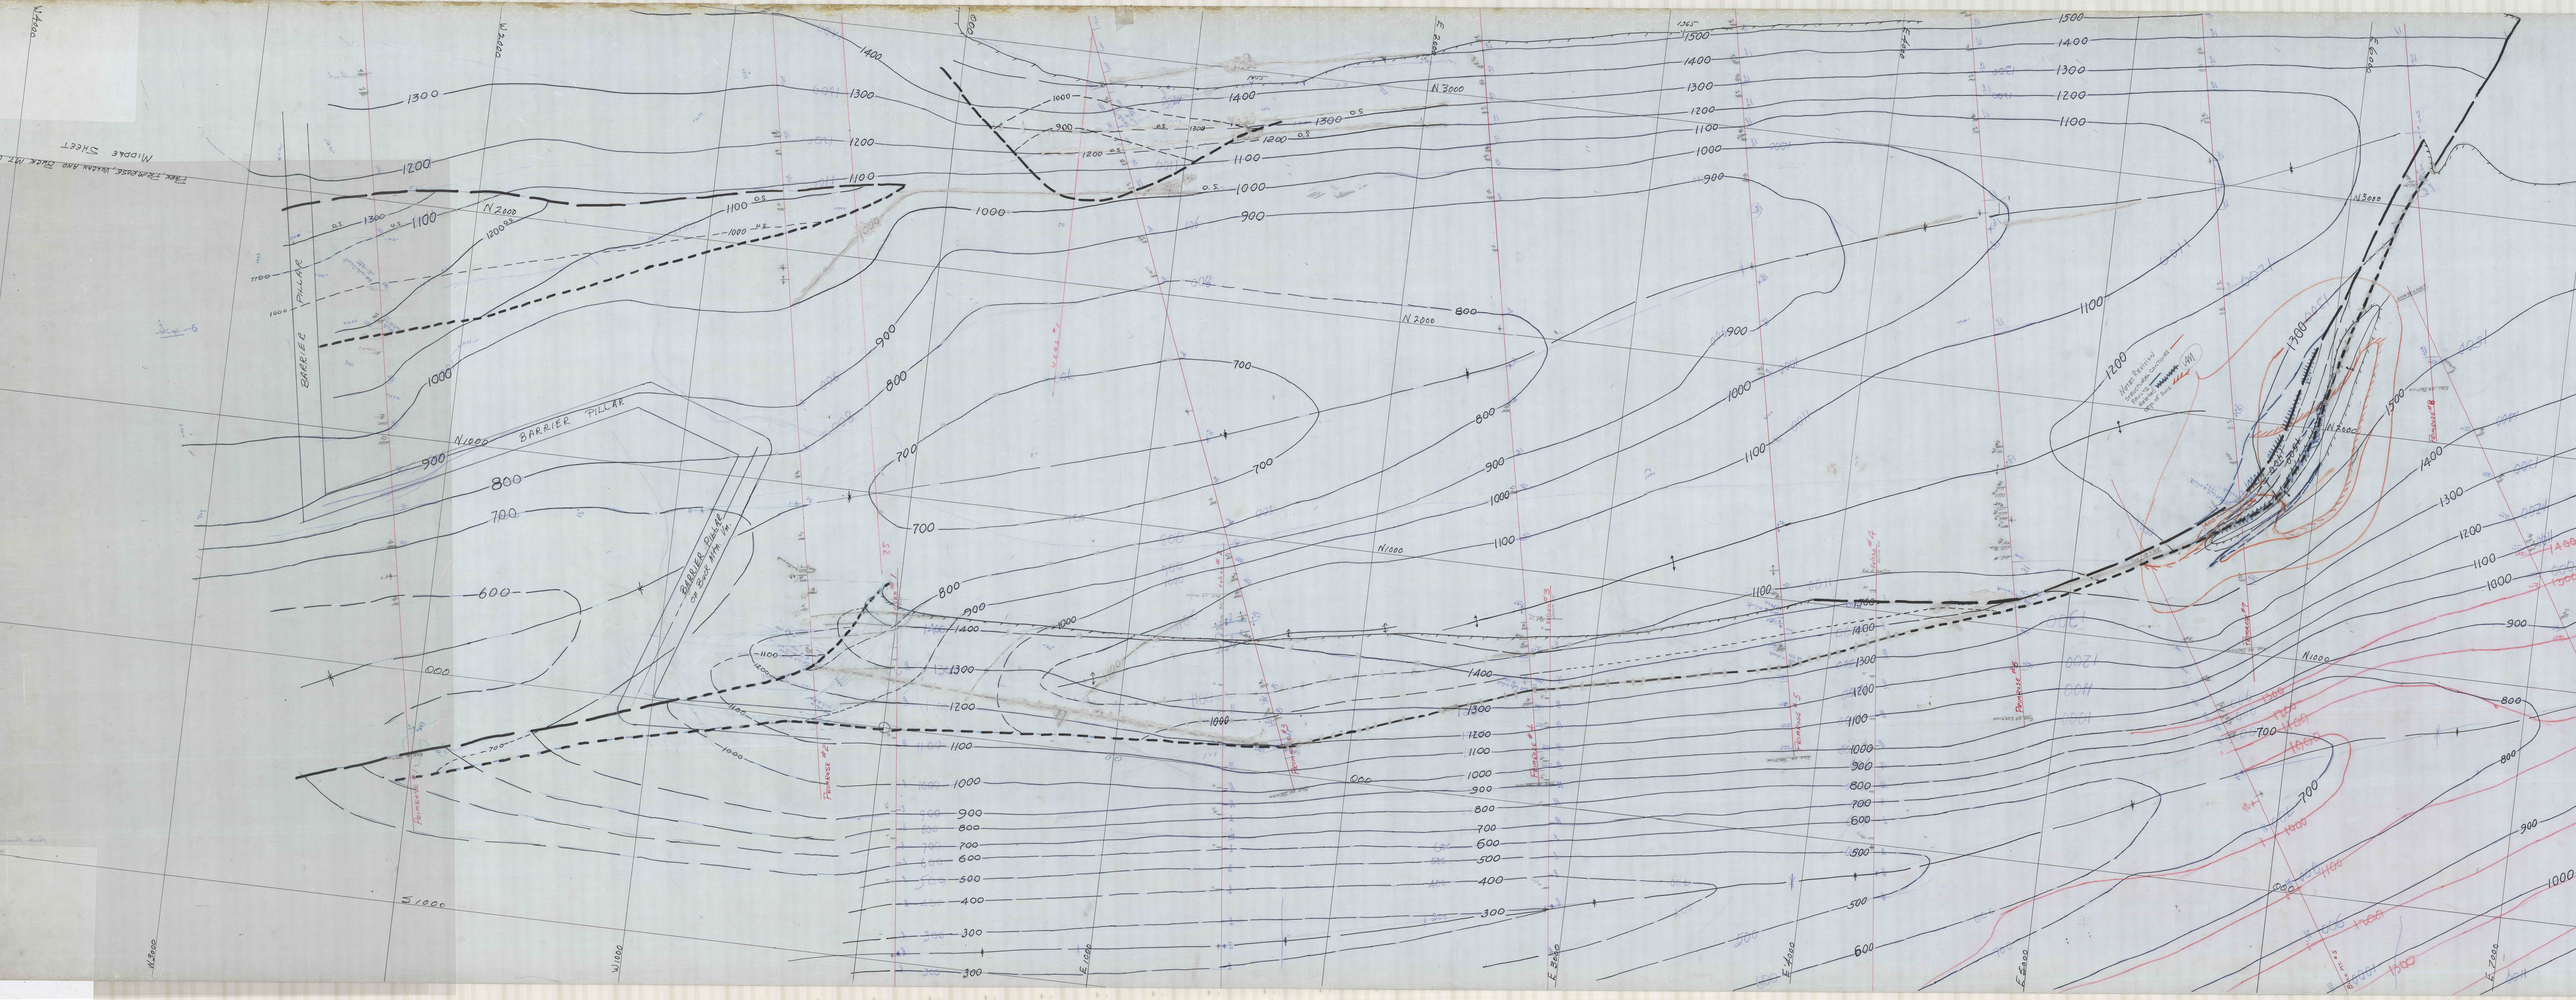
BARRIER PILLAR
BARRIER PILLAR
