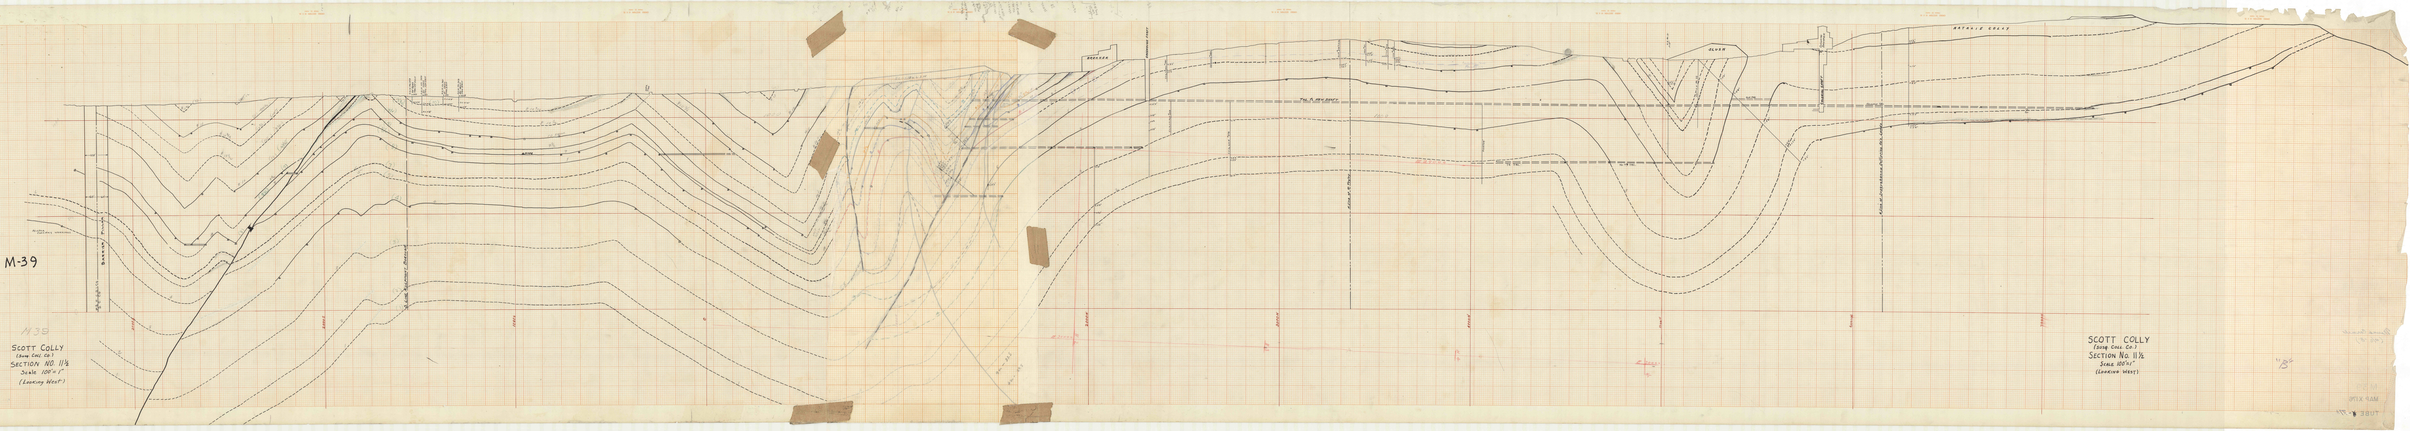
M-39
SCOTT COLLY
(Long Cmz. Co.)
SECTION NO. 11½
Scale 100'= 1"
(Looking West)
SCOTT COLLY
(Long Cmz. Co.)
SECTION No. 11½
Scale 100'= 1"
(Looking West)