

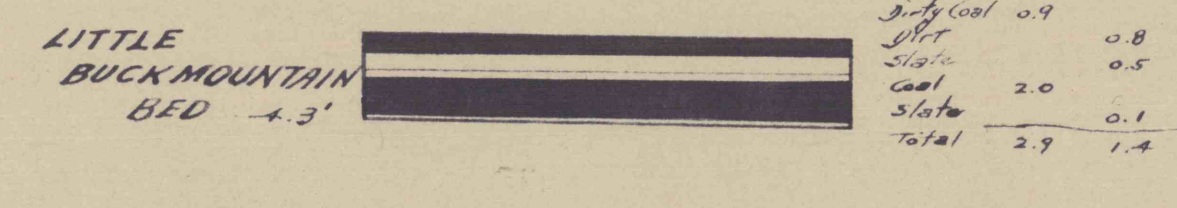
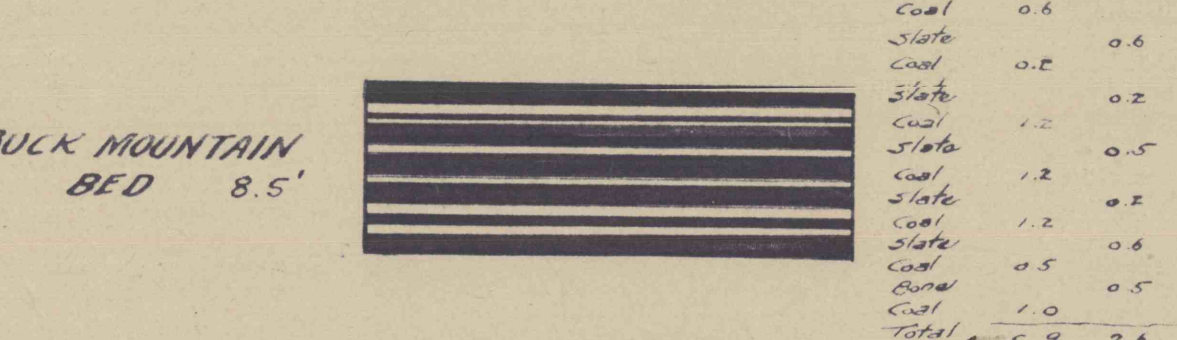
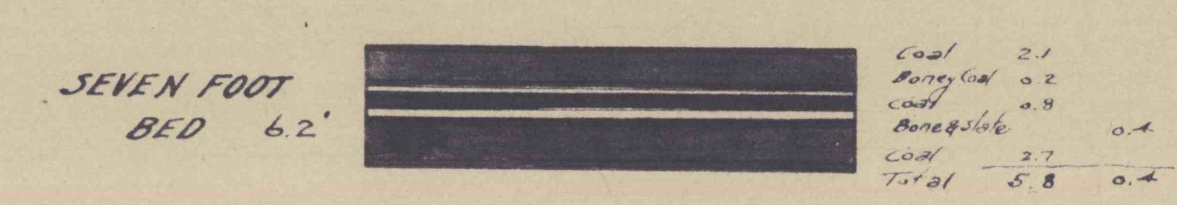
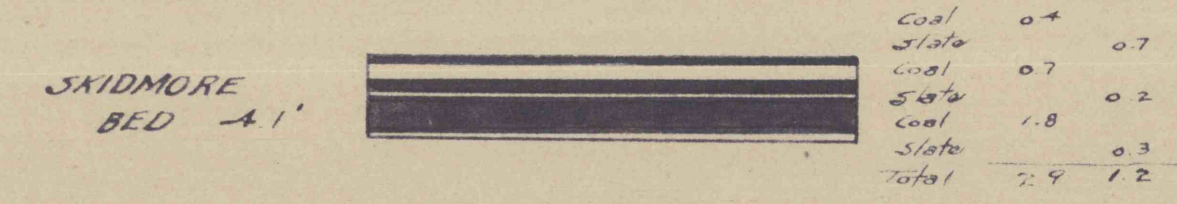
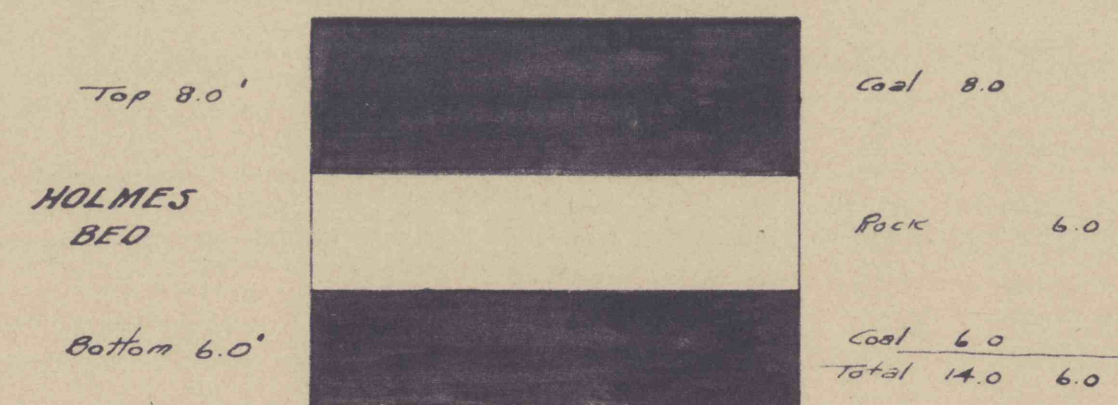
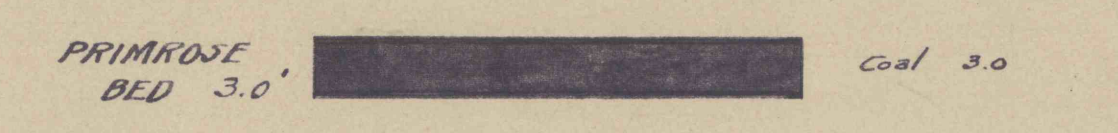
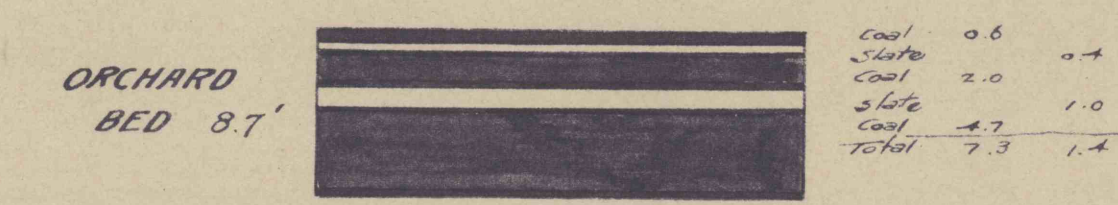
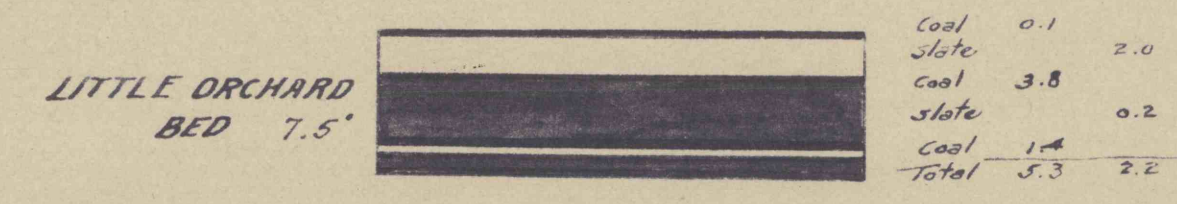
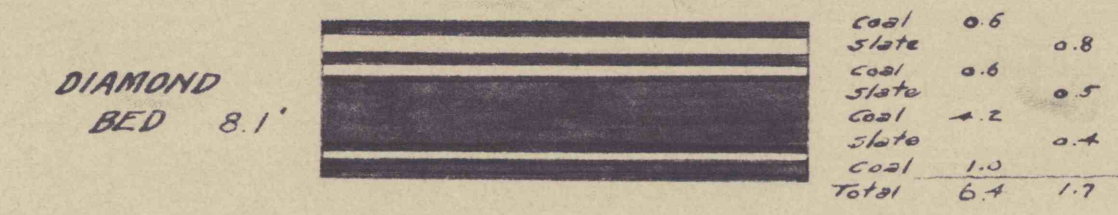
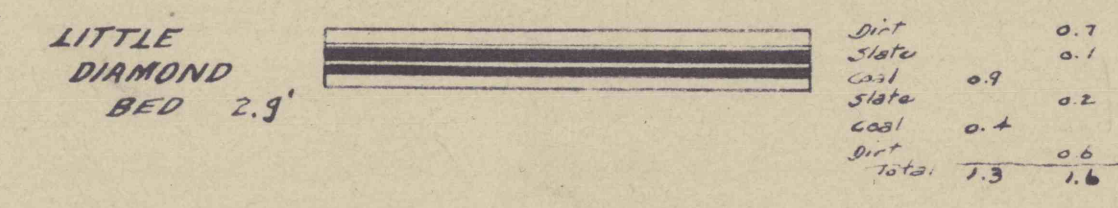
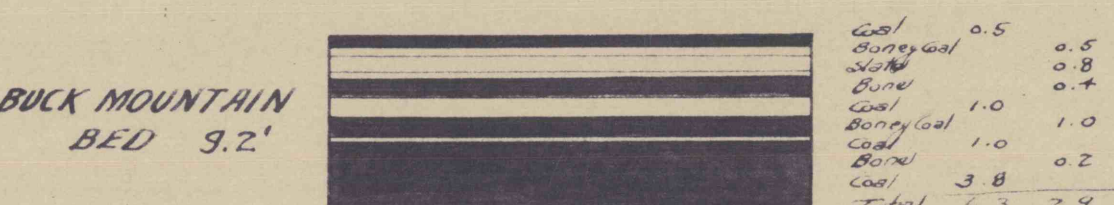
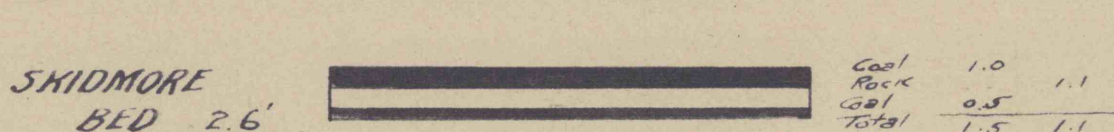
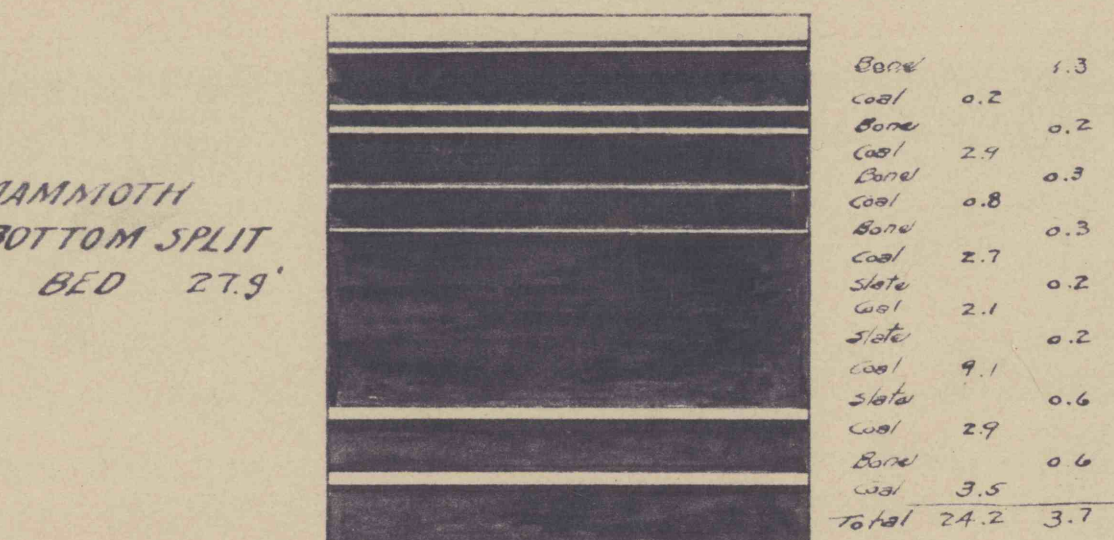
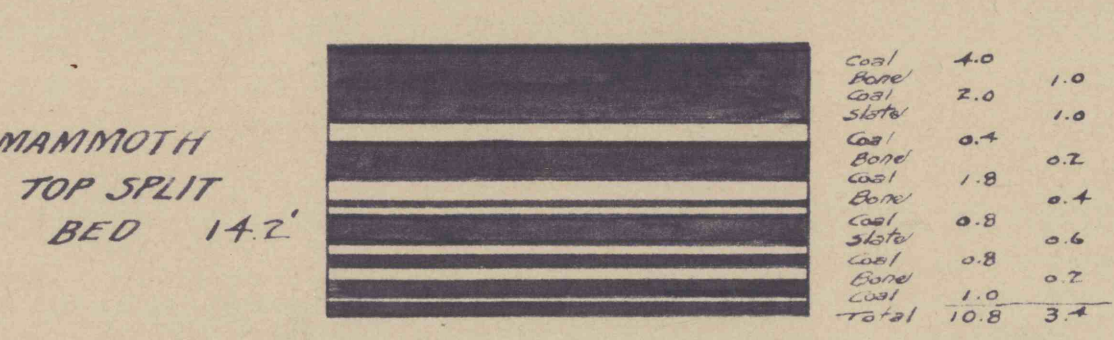
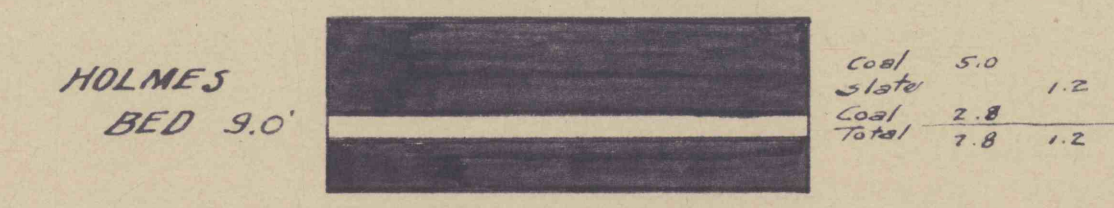
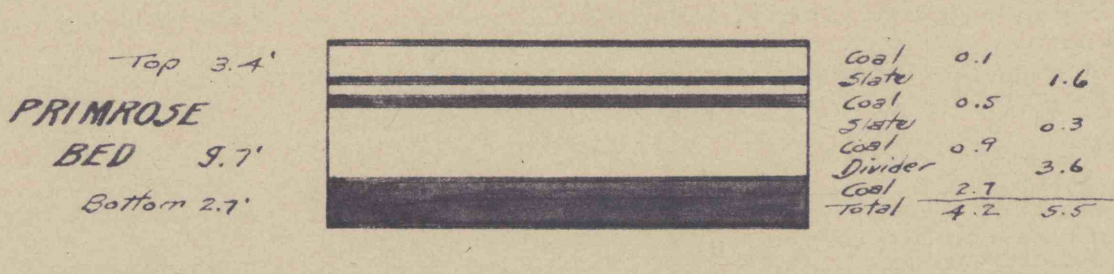
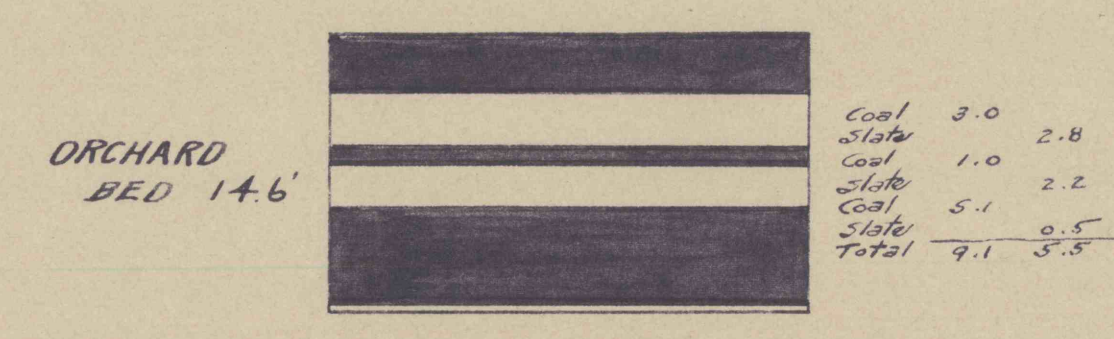










PACKER NO. 5

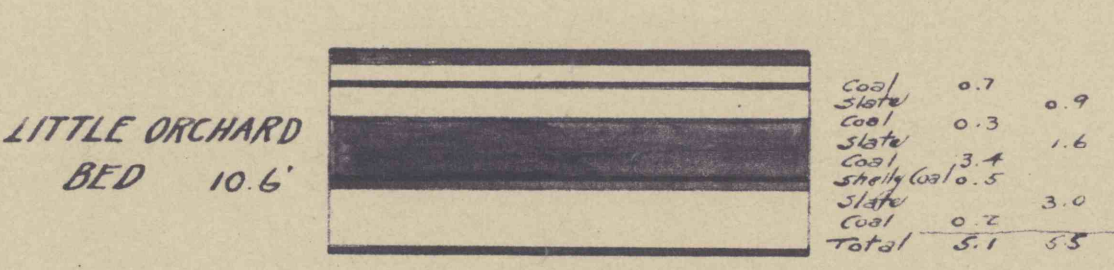



PACKER NO. 2

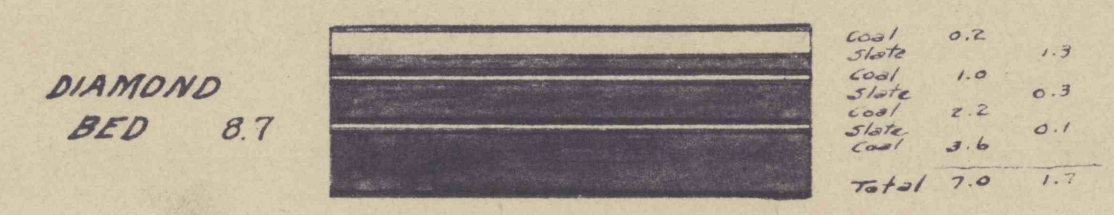

PACKER NO. 4

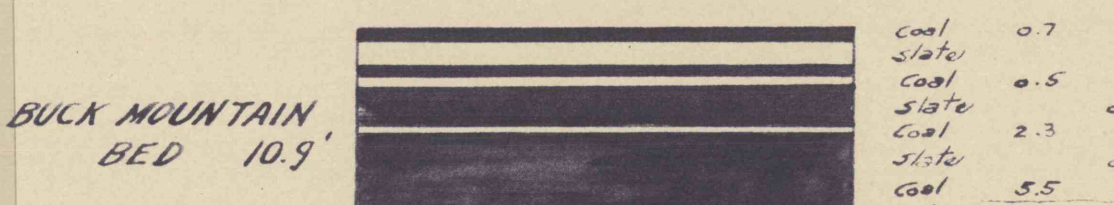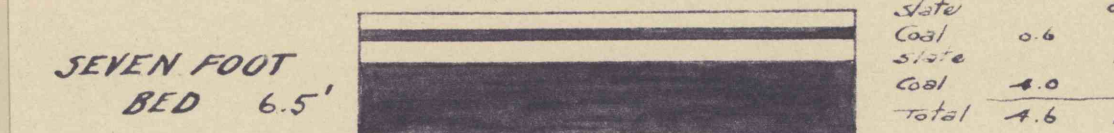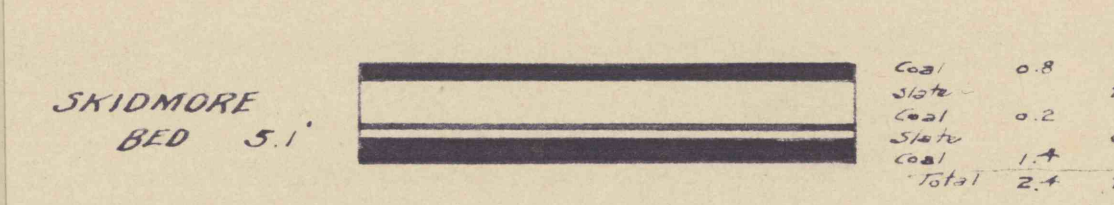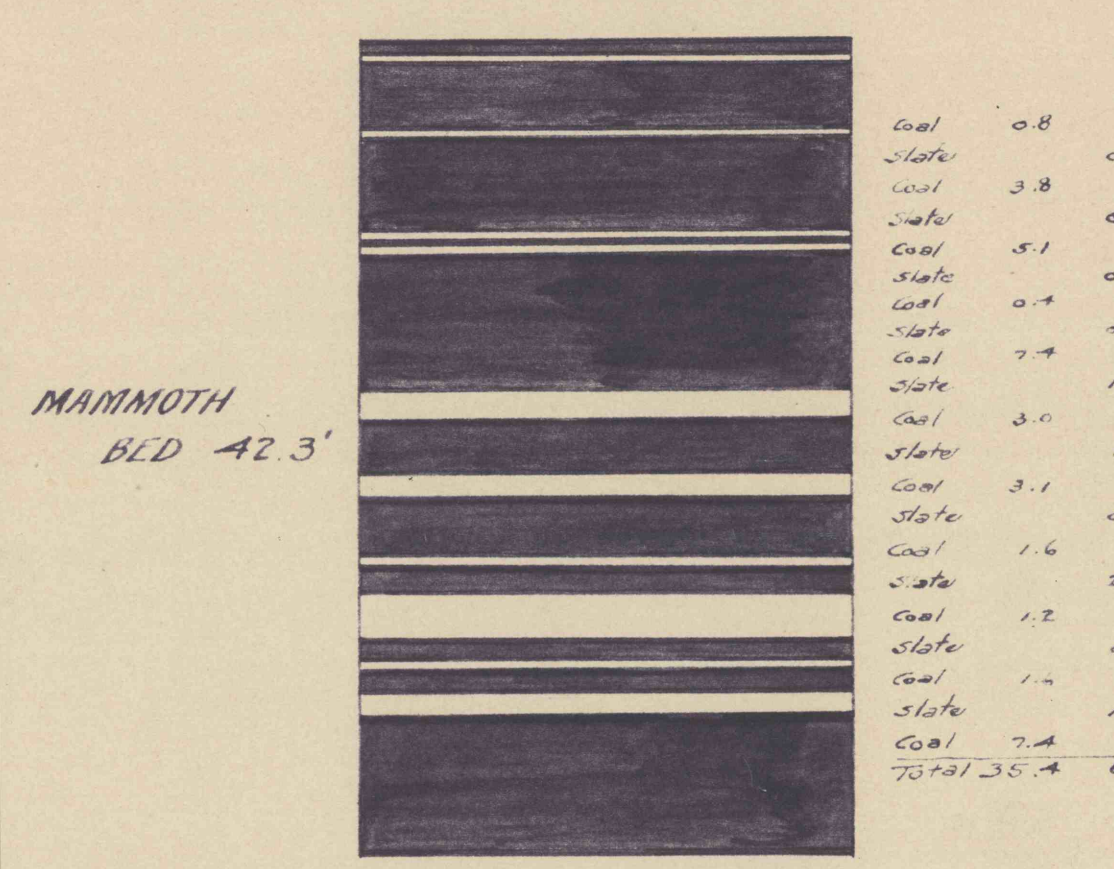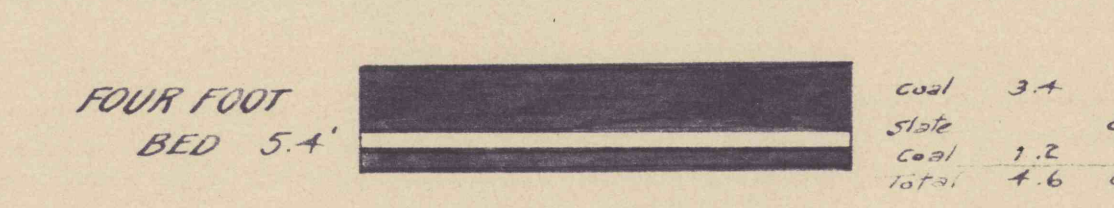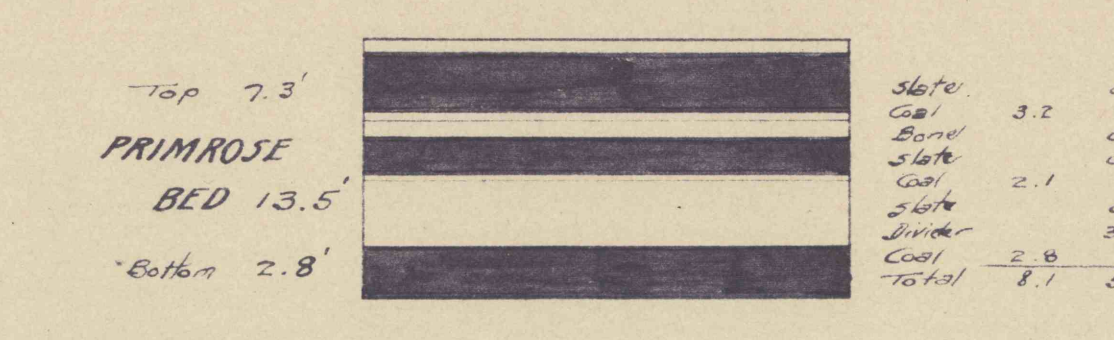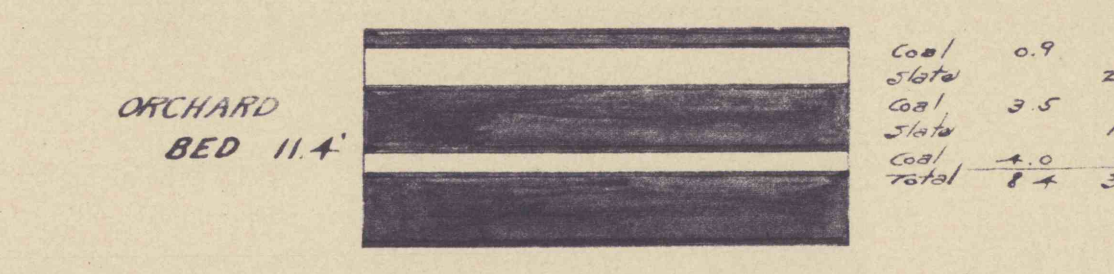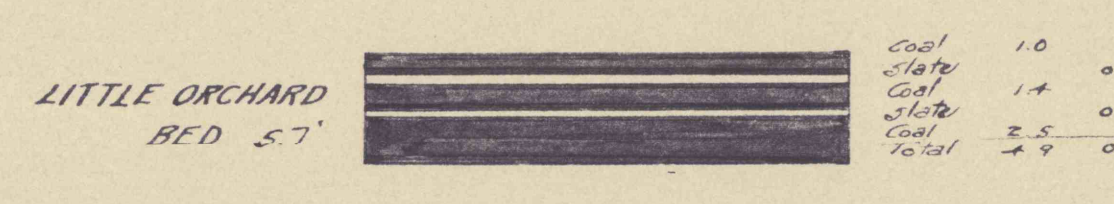

PACKER NO. 3

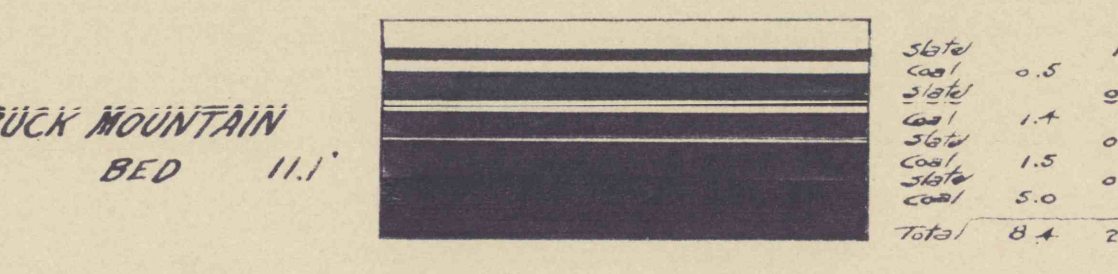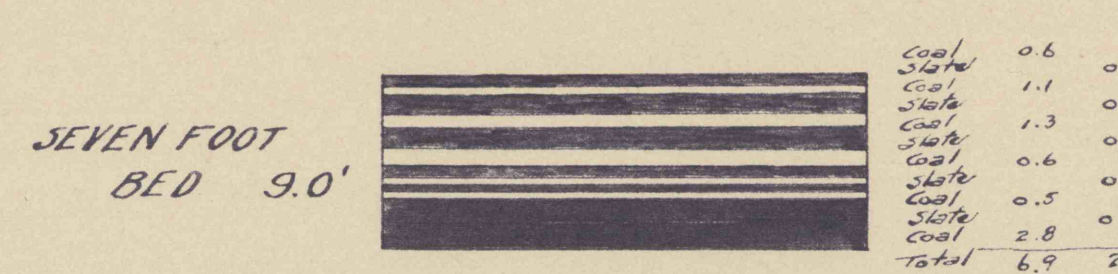

CONTINENTAL

