


F-332-S Ø-2-B-S

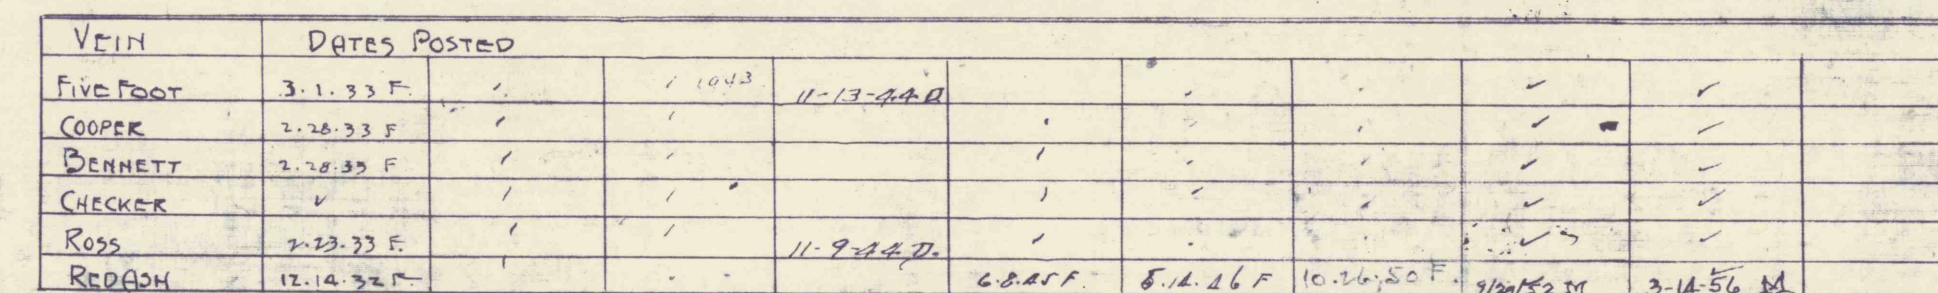

Q-2-B-5 F-332-5