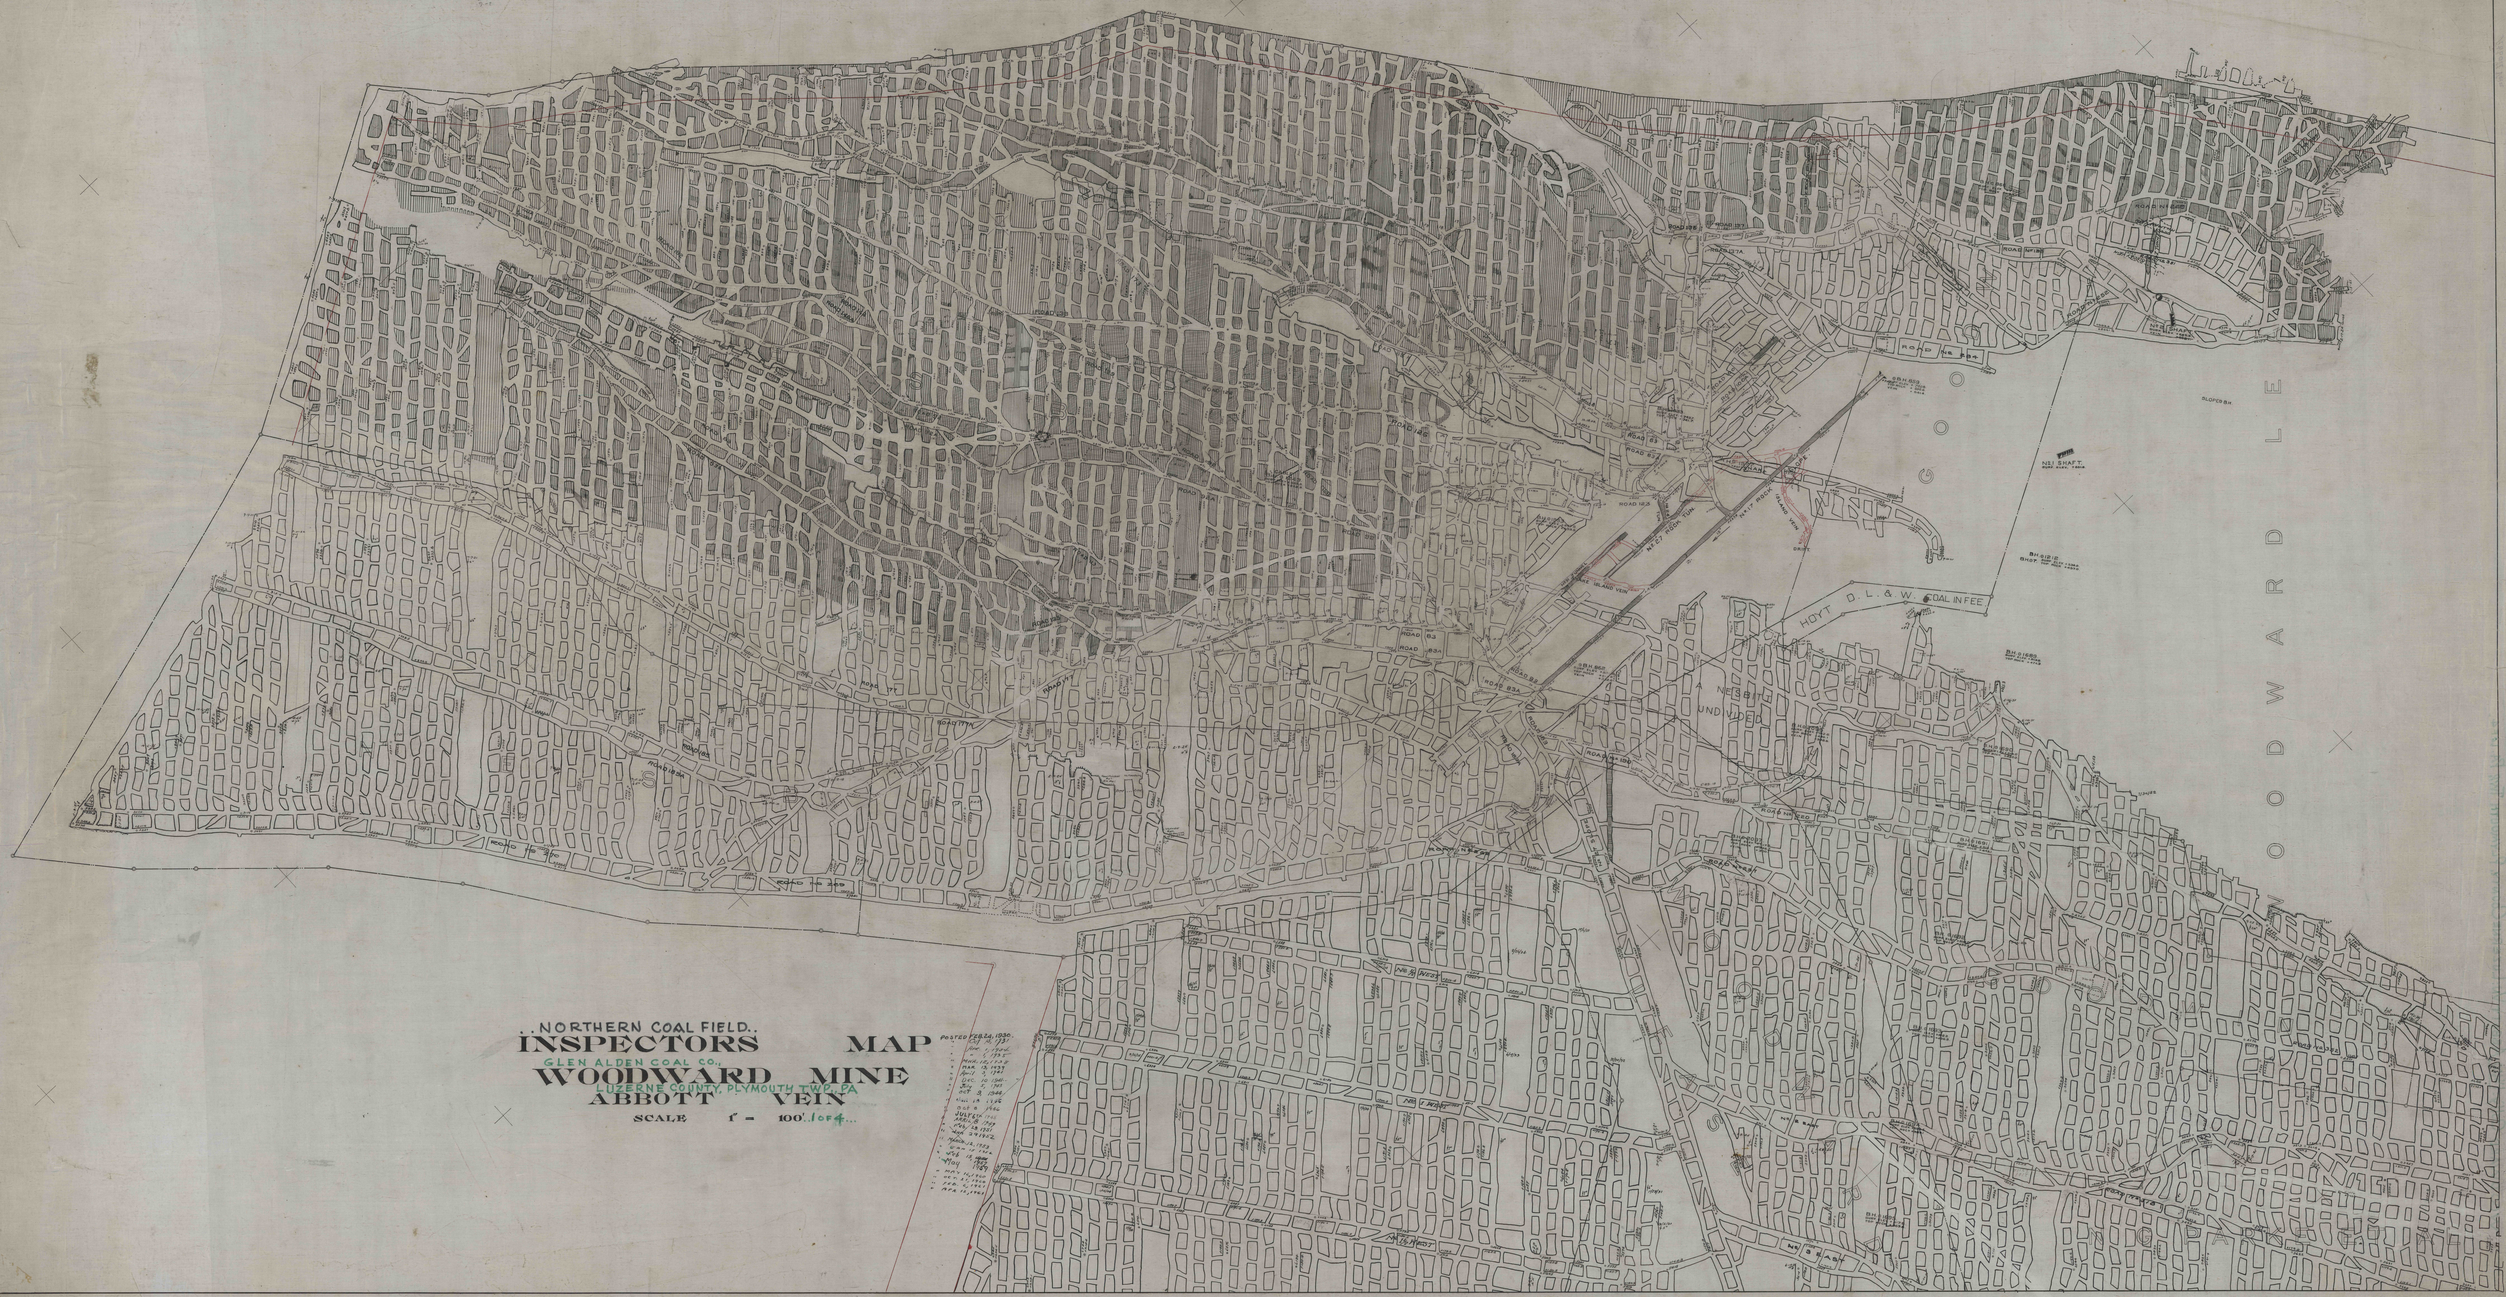

HOYT D.L. & W. COAL IN FEE
A NESBITT UNDIVIDED
WOODWARD LE
GOO
No 1 SHAFT. SURF. ELEV. +651.8
No 2 SHAFT
ROAD No 284
ROAD No 252
ROAD 63
ROAD 123
No 27 ROCK TUN.
No 17 ROCK
SNAKE SLOPE
ISLAND VEIN
DRIFT.
SLOPE B.H.
B.H. 859
B.H. 1212
B.H. 1689
B.H. 1690
B.H. 2093
B.H. 862
ROAD No 190

..NORTHERN COAL FIELD..

INSPECTORS MAP

GLEN ALDEN COAL CO.,

WOODWARD MINE

LUZERNE COUNTY, PLYMOUTH TWP., PA

ABBOTT VEIN

SCALE 1" = 100'. 1 OF 4...

POSTED FEB. 24, 1930.
" Oct 15, 1931
" APR. 1, 1934
" " 1, 1935
" MAR. 12, 1938
" MAR. 13, 1939
" April 3, 1941
" DEC. 10 1941
" July 5, 1943
" OCT 9, 1944
" Jan 18 1946
" Oct 8 1946
" JULY 6TH 1948
" ARRIL 8 1949
" Feb. 28 1951
" Jan 29 1952
" MARCH 12, 1953
" JAN 15 1954
" Feb 15, ~~1956~~ 1957
" May 1959
" MAY 16, 1960
" OCT. 21, 1960
" FEB. 6, 1961
" APR. 12, 1961