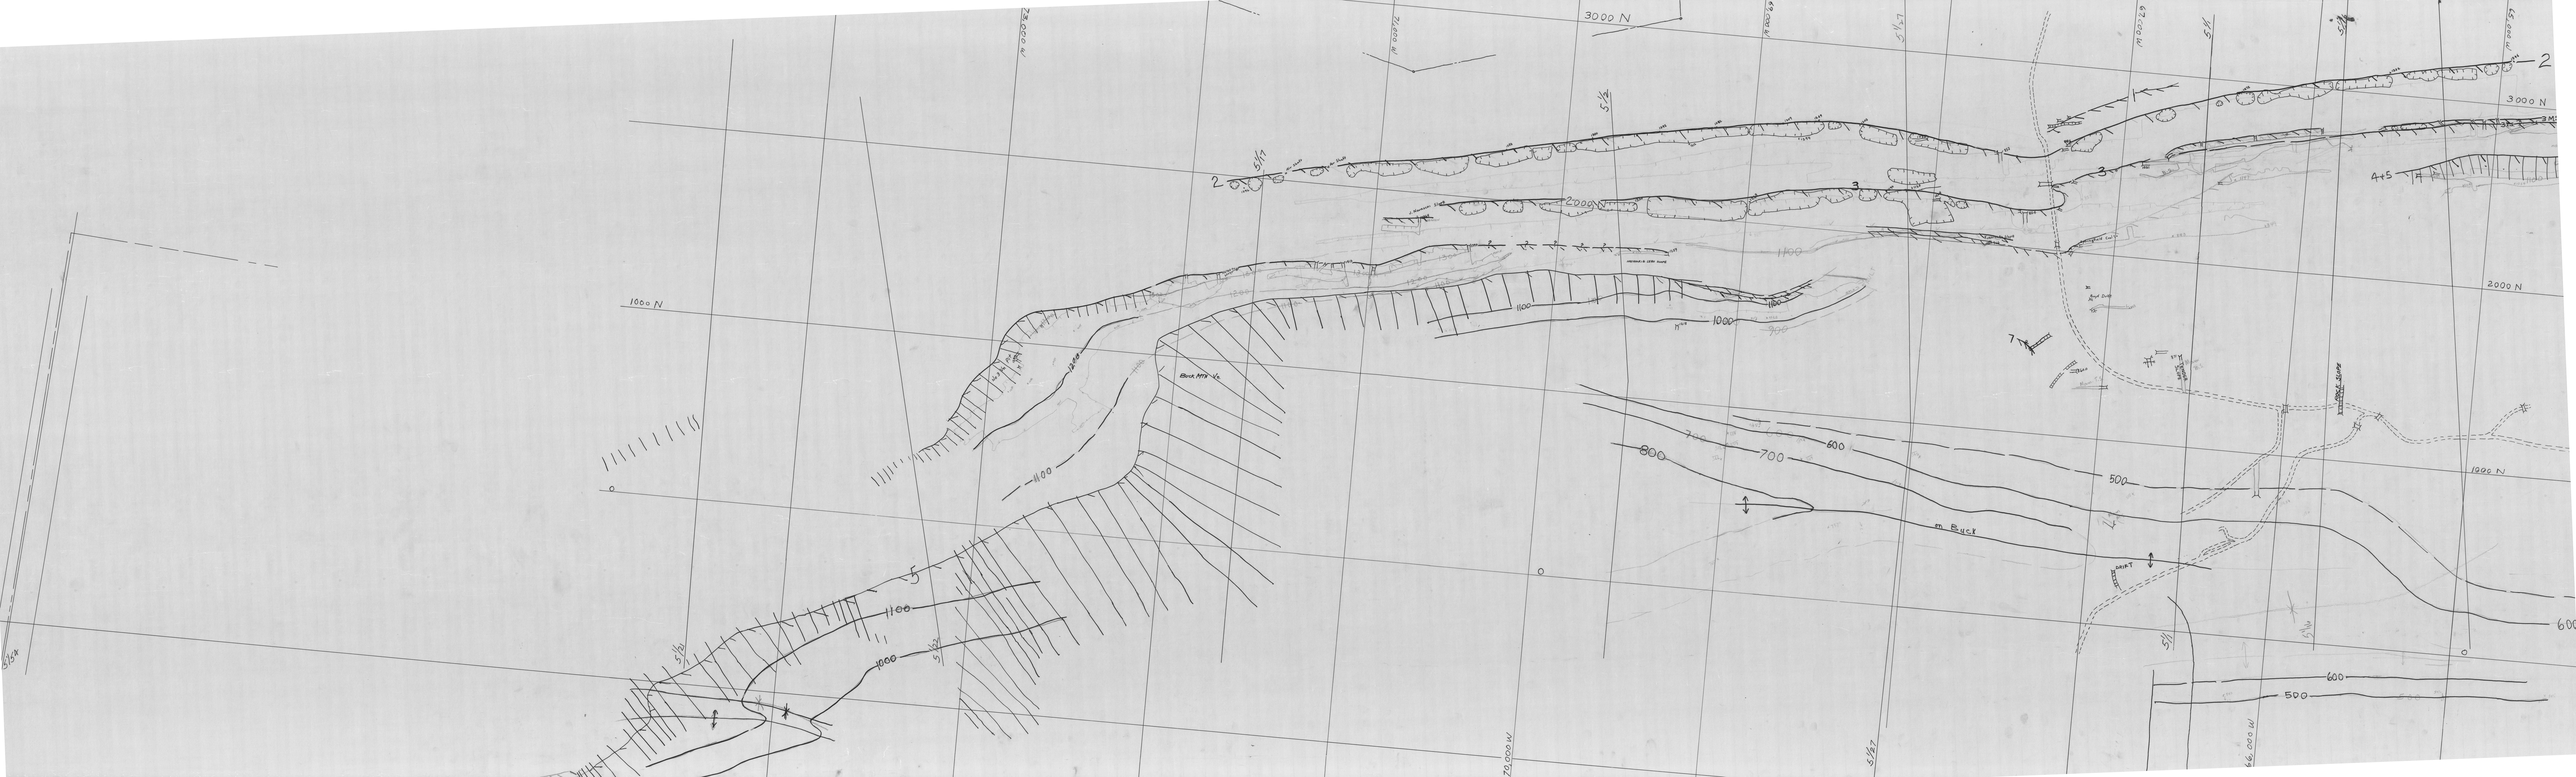
3000 N
2000 N
1000 N
0
1100
1000
900
800
700
600
500
Block Mtg. Ln.
m Block
Block
Block